

11

11

8.5

8.5

11

17

11



11

8.5

8.5

11

17

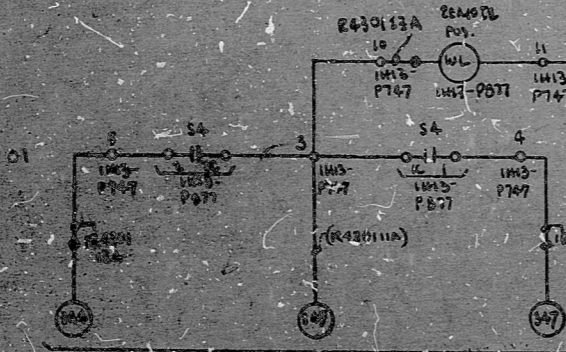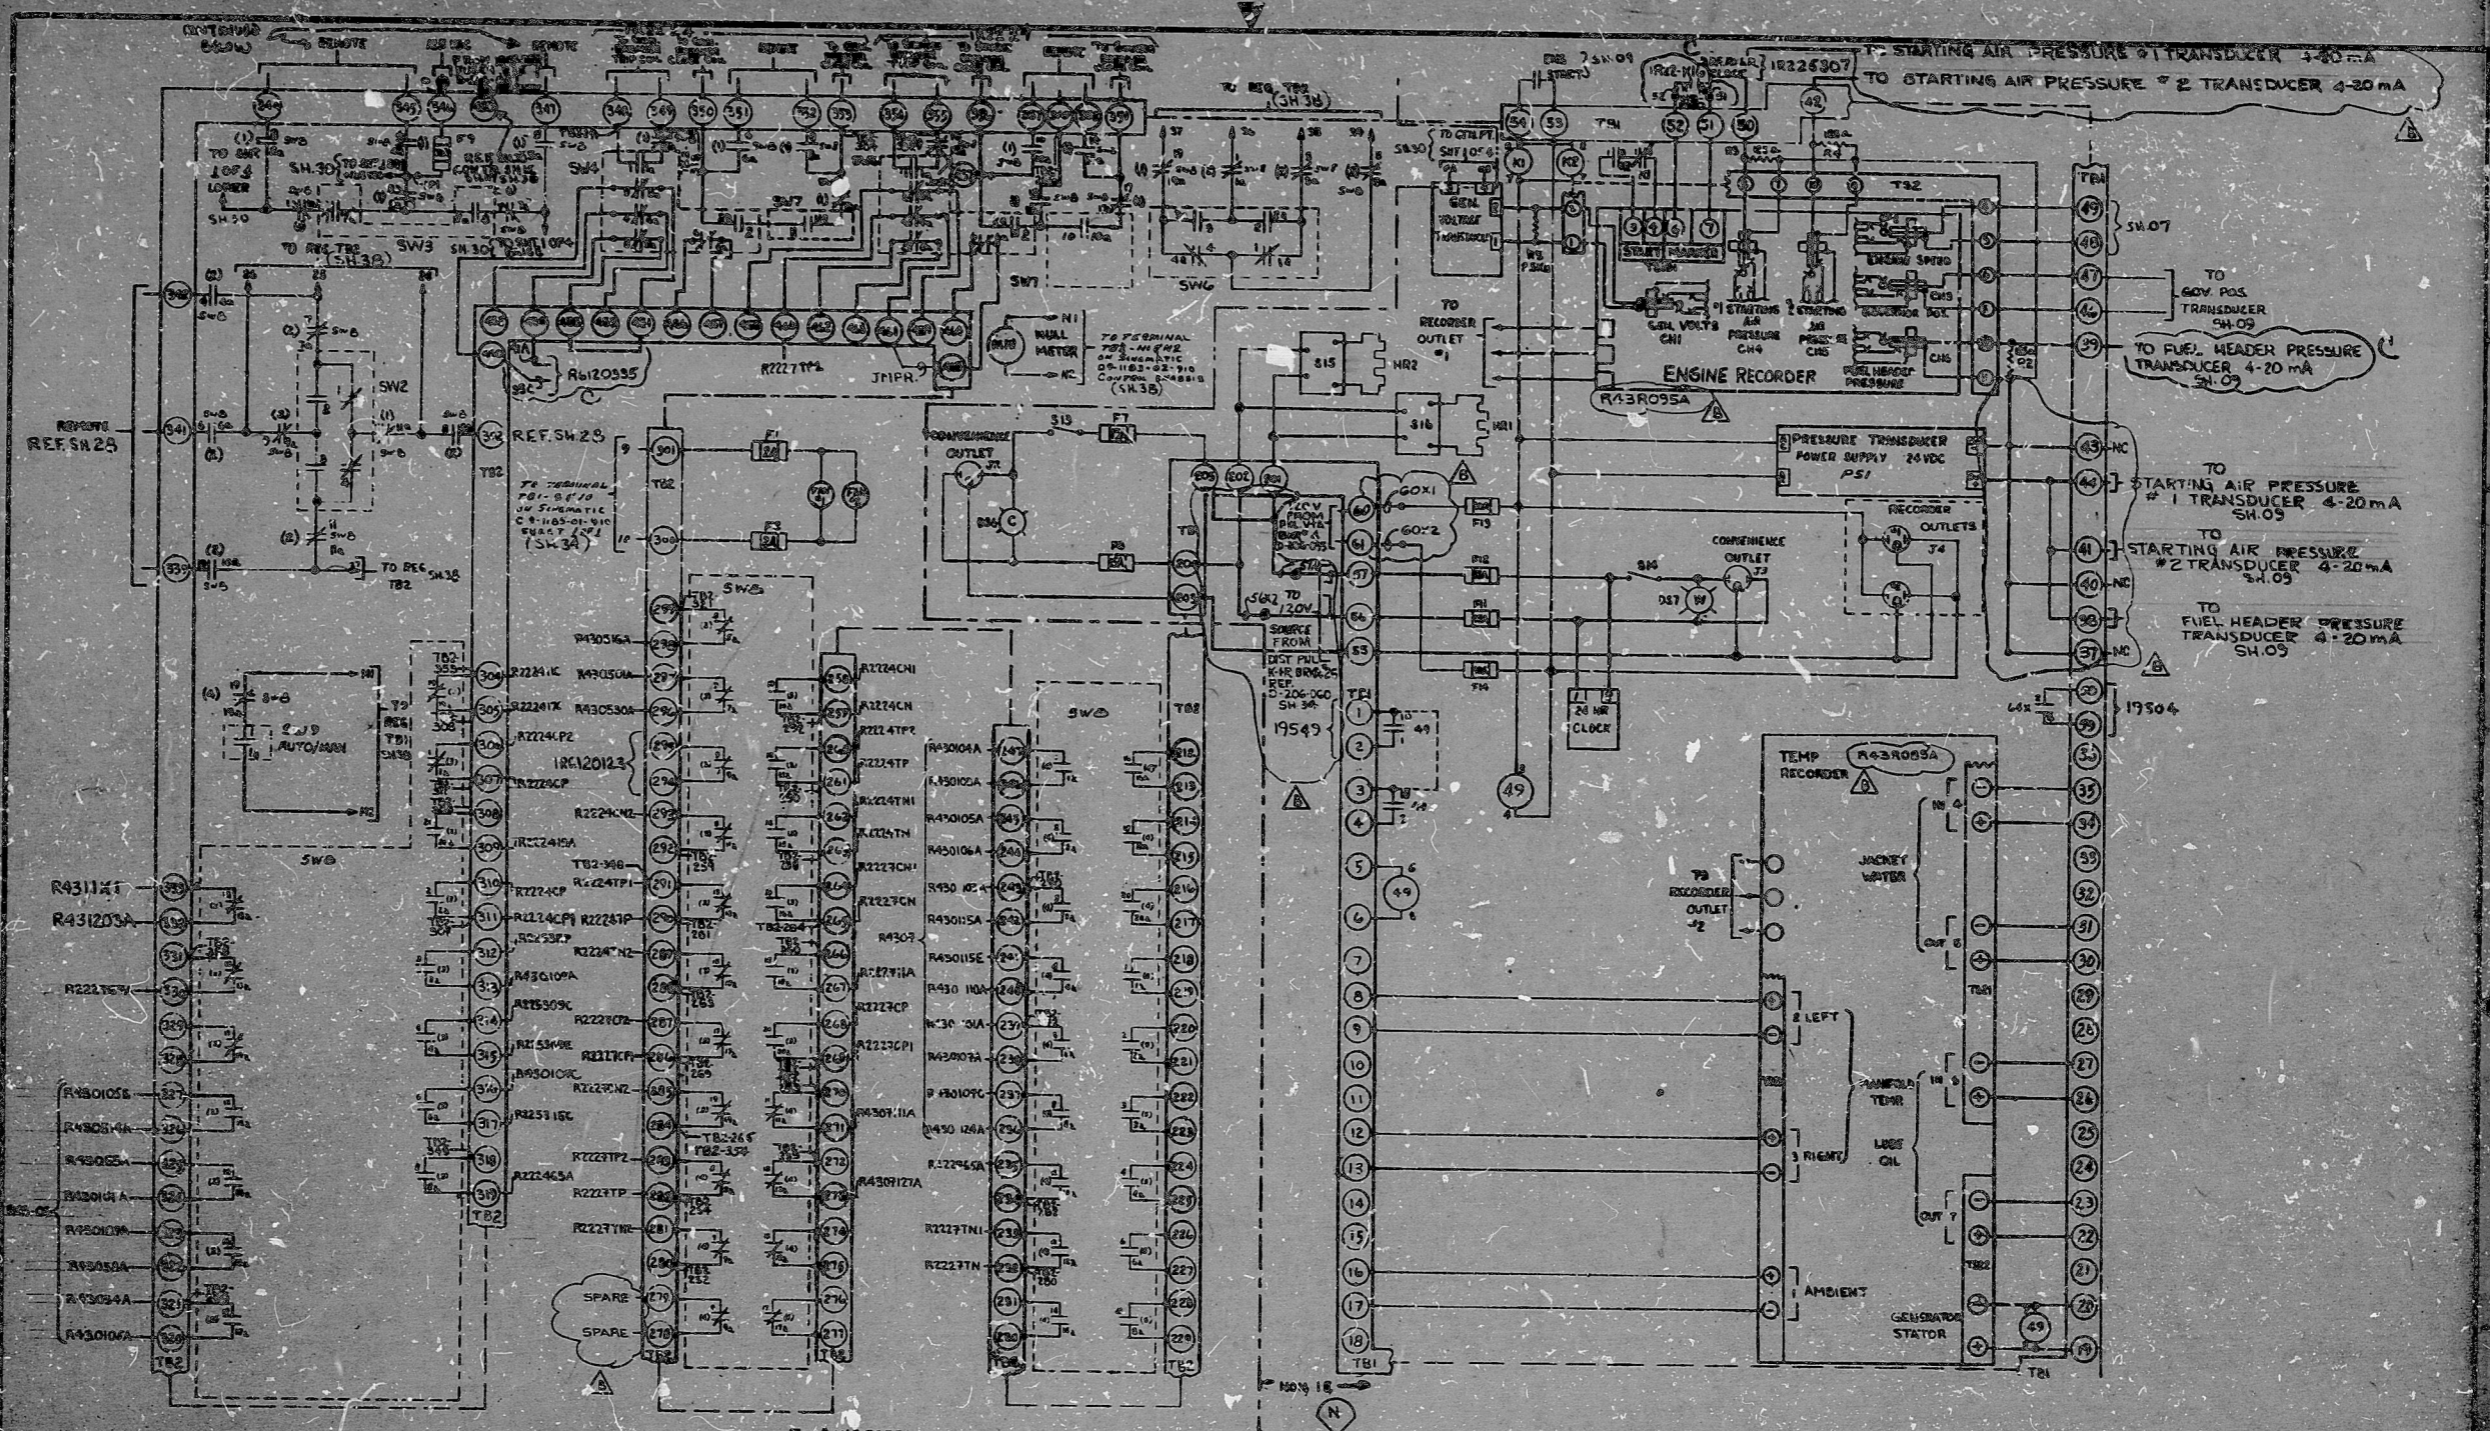

PRC
APERTURE
CARD

REF:
B-208-216 SH2B-E.D

- LEGEND
- (D1) CLASS I.E. DIV. I
 - S4 FOR SW DEVELOPMENT IDE R4366
 - IM3 P.476 TERMINATION CAB T MOD 50
 - IM3 P.0716 DISTAL GEM BOARD BOARD
 - (N) NONE I.E.

NUCLEAR SAFETY RELATED

THE CLEVELAND ELECTRIC ILLUSTRATING CO.

FERRY NUCLEAR POWER PLANT UNIT 1

ELECTRICAL-ELEMENTARY DIAGRAM






GILBERT ASSOCIATES, INC.
ENGINEERS AND CONSULTANTS




Rids

8212210584

