


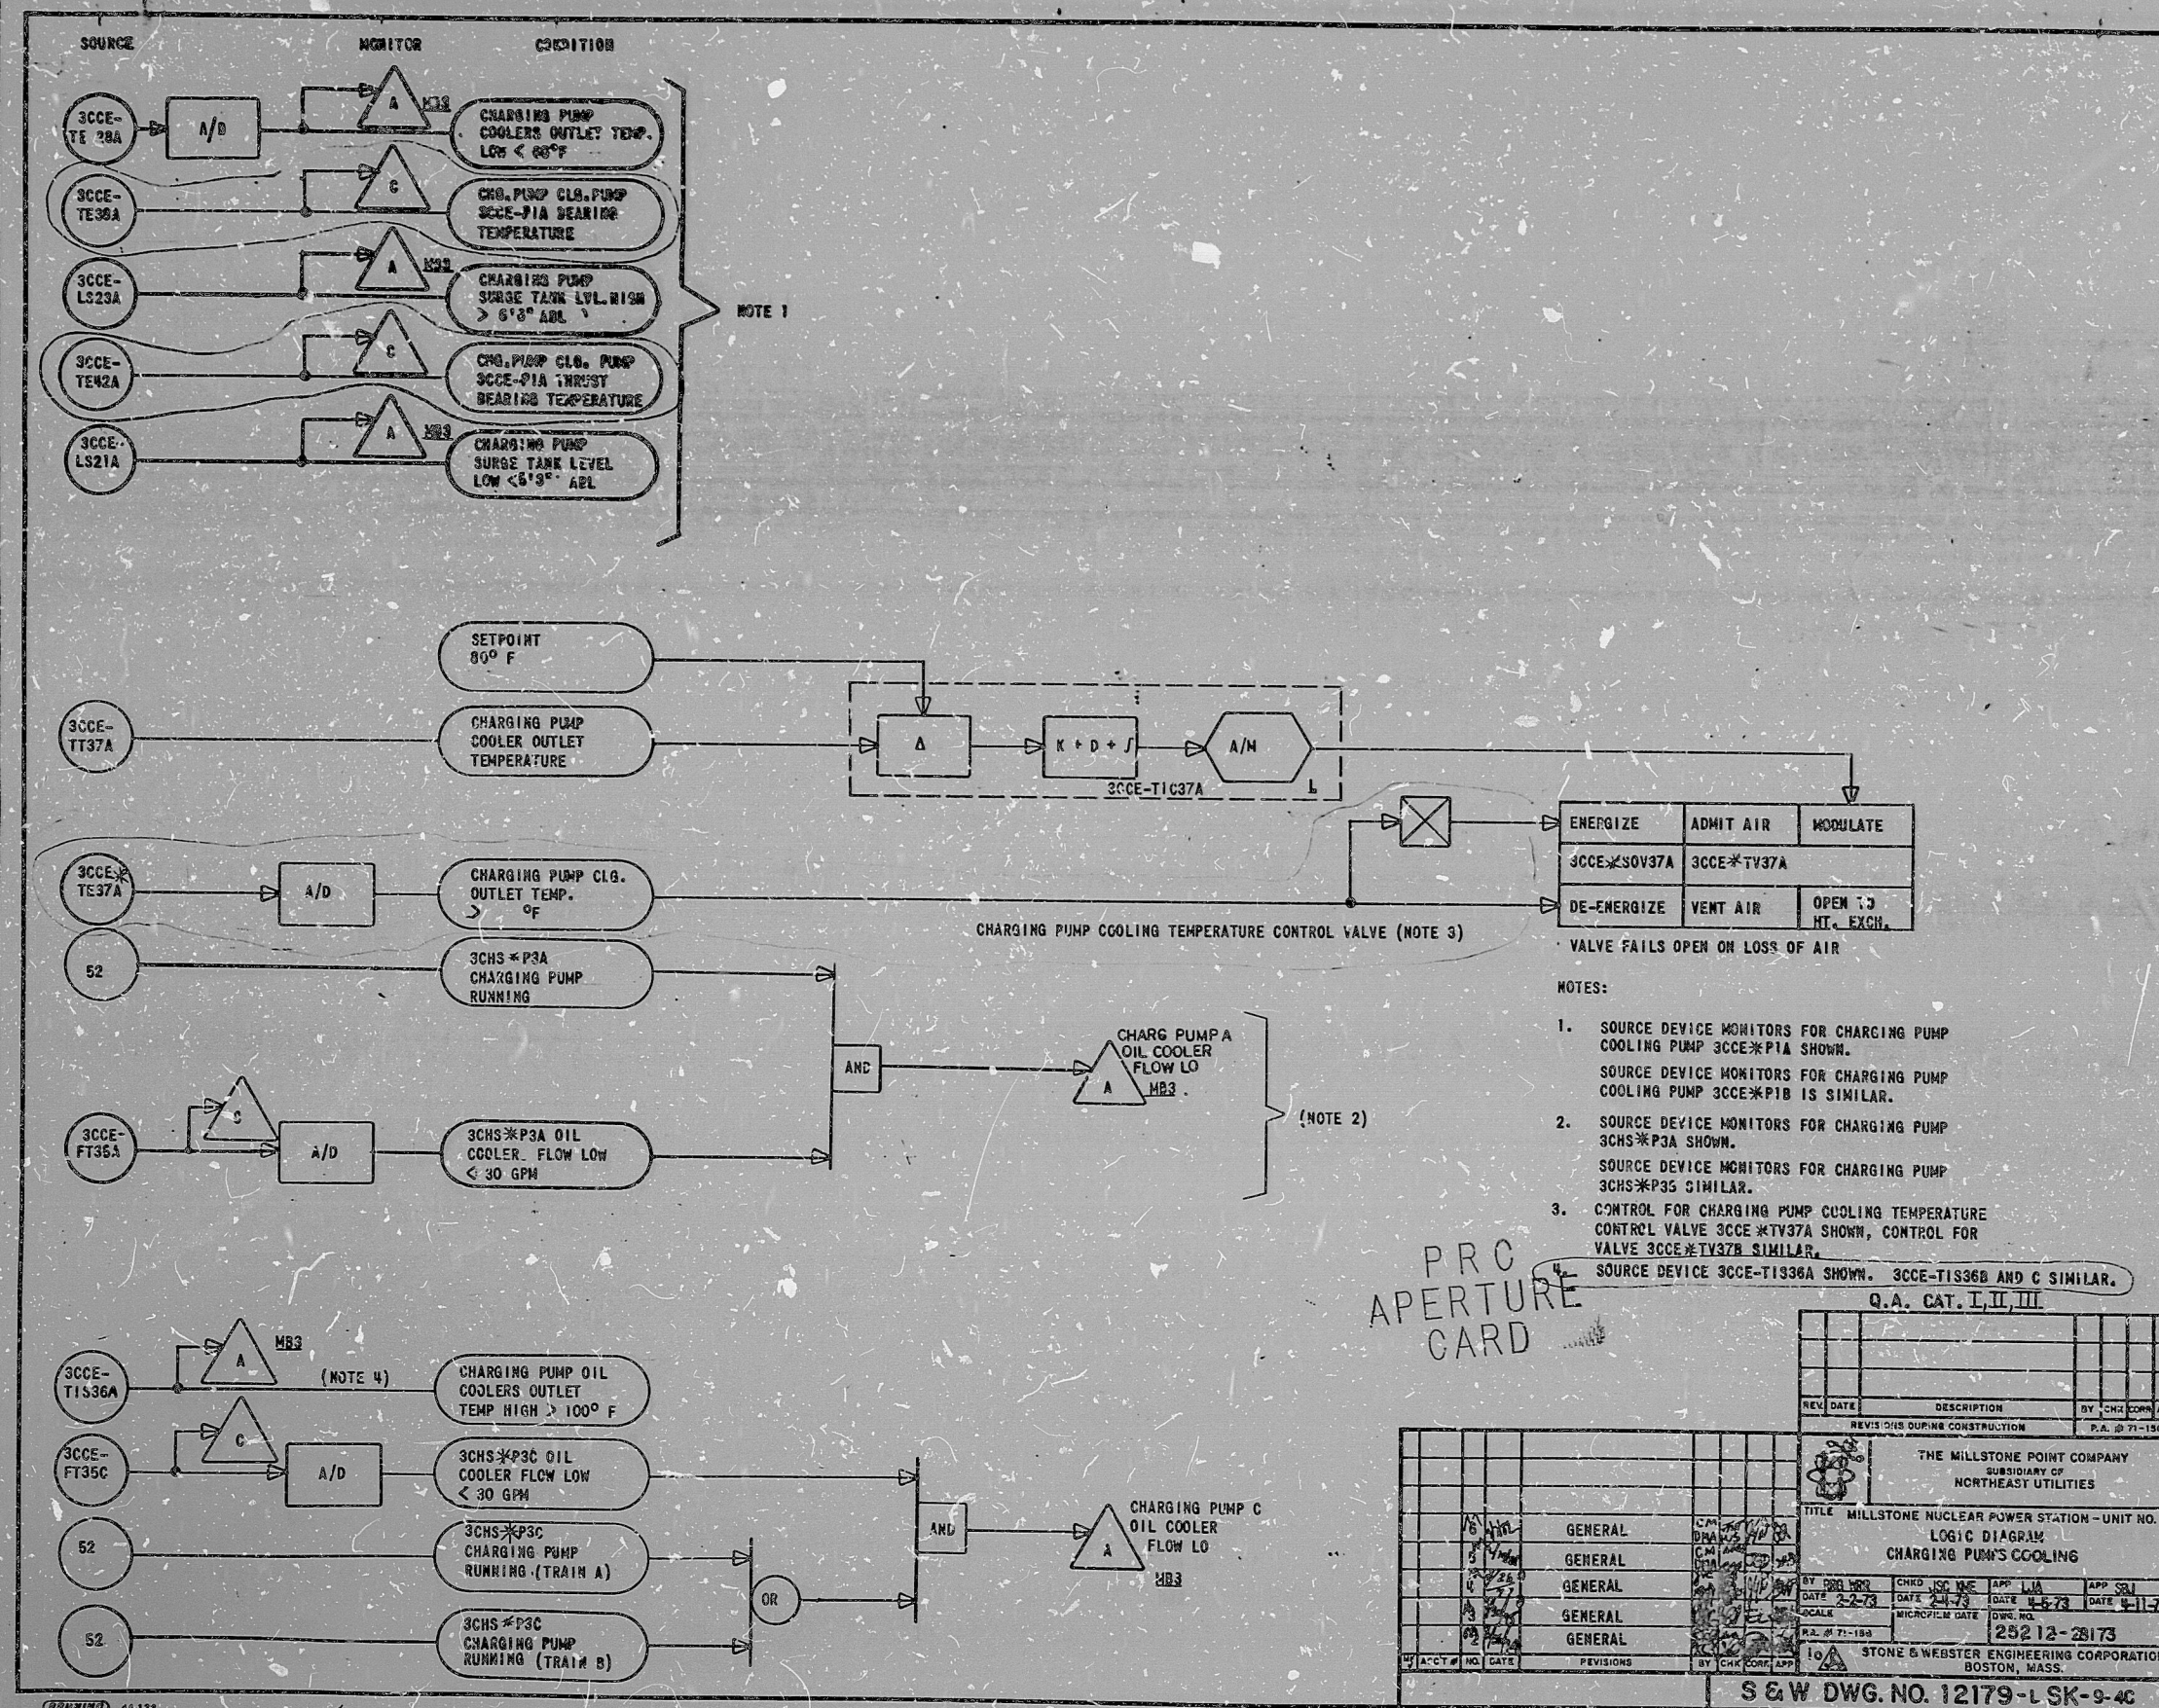

RID

8212220087

