


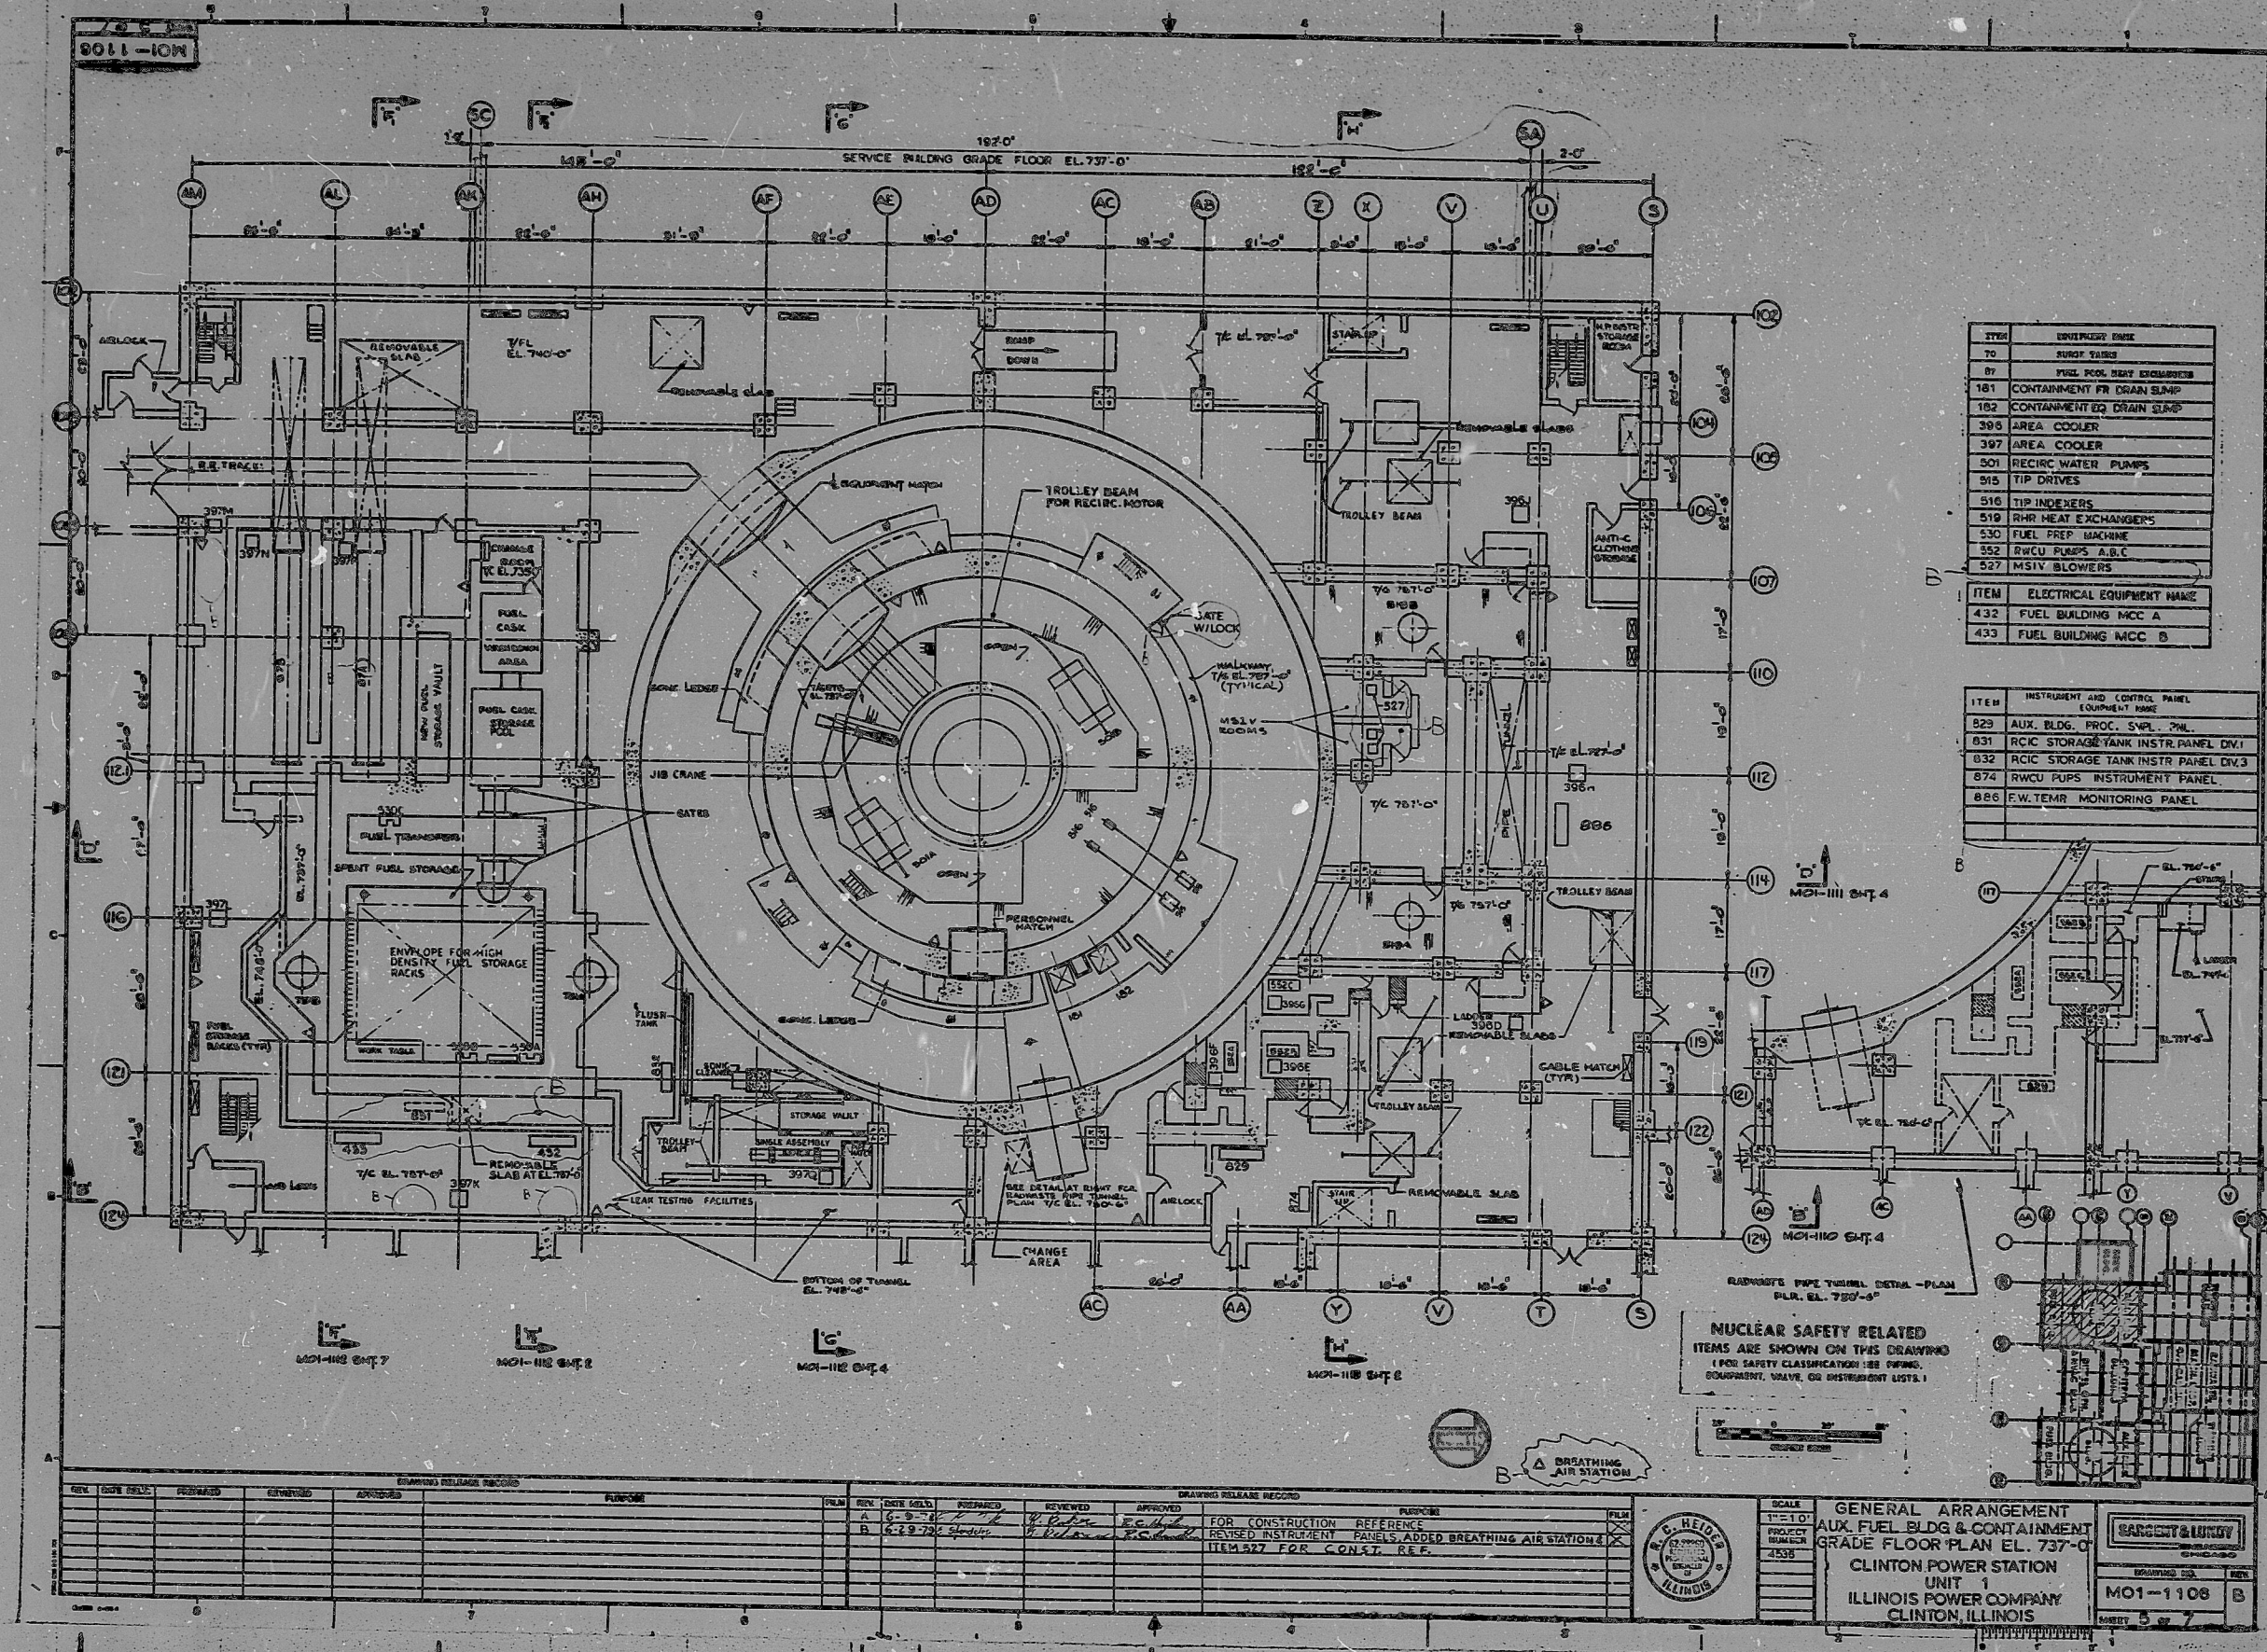

R1DS

8107130106

