


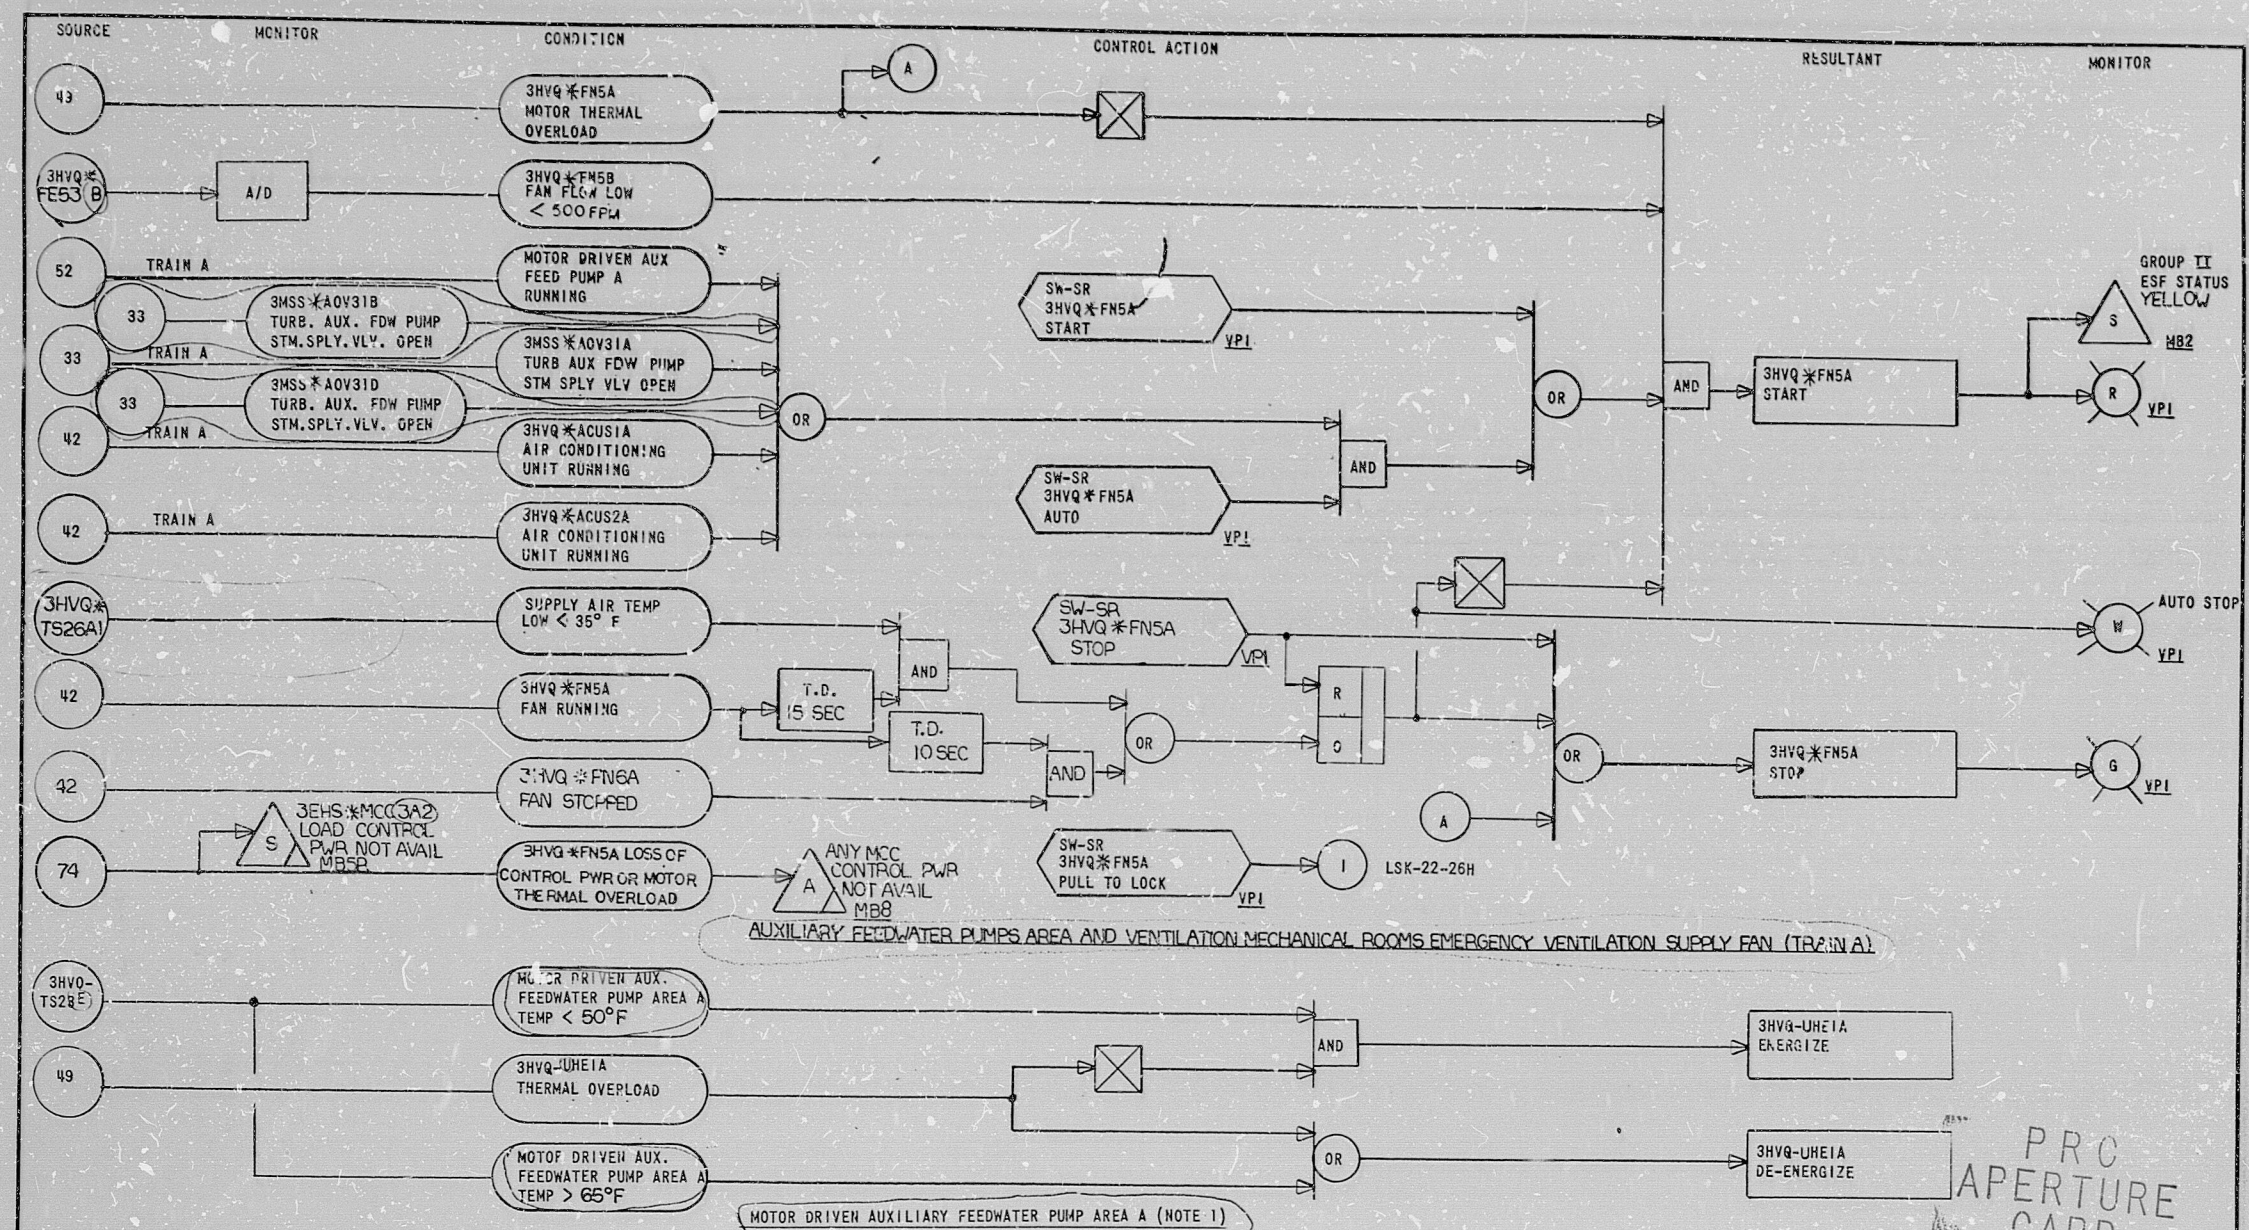

NOTES: 1. MOTOR DRIVEN AUXILIARY FEEDWATER PUMP AREA A UNIT HEATER 3HVQ-UHE1A IS SHOWN. EQUIPMENT LISTED BELOW IS SIMILAR.

| UNIT HEATER | SWITCH | AREA                                               |
|-------------|--------|----------------------------------------------------|
| UHE 1A      | TS23E  | MOTOR DRIVEN AUXILIARY FEEDWATER PUMP AREA A       |
| UHE 1B      | TS23F  | MOTOR DRIVEN AUXILIARY FEEDWATER PUMP AREA B       |
| UHE 1C      | TS23C  | SAFETY INJECTION AND QUENCH SPRAY PUMPS AREA A     |
| UHE 1D      | TS23D  | REFUELING WATER RECIRCULATION PUMP AREA            |
| UHE 2       | TS22   | TURBINE DRIVEN AUXILIARY FEEDWATER PUMP AREA       |
| UHE 3A      | TS36A  | MECHANICAL ROOM A                                  |
| UHE 3B      | TS36B  | MECHANICAL ROOM A                                  |
| UHE 3C      | TS36C  | MECHANICAL ROOM B                                  |
| UHE 3D      | TS36D  | RESIDUAL HEAT EXCHANGER AREA A                     |
| UHE 3E      | TS35E  | CONTAINMENT RECIRCULATION PUMPS AND COOLERS AREA A |
| UHE 4A      | TS39A  | MECHANICAL ROOM C                                  |
| UHE 4B      | TS39B  | CONTAINMENT RECIRCULATION PUMPS AND COOLERS AREA B |
| UHE 5A      | TS44A  | MECHANICAL ROOM D                                  |
| UHE 5B      | TS44B  | MECHANICAL ROOM D                                  |
| UHE 6A      | TS23A  | SAFETY INJECTION AND QUENCH SPRAY PUMPS AREA A     |
| UHE 6B      | TS23B  | SAFETY INJECTION AND QUENCH SPRAY PUMPS AREA B     |
| UHE 6C      | TS24D  | TURBINE DRIVEN AUXILIARY FEEDWATER PUMP AREA       |
| UHE 6D      | TS44C  | RESIDUAL HEAT EXCHANGER AREA B                     |

ESCUICHEON  
3HVQ\*FN5A  
AUTO  
STOP START  
PULL TO LOCK 0  
VPI  
SPRING RETURN

NUCLEAR SAFETY RELATED  
Q.A. CAT. I, II

|   |                |          |              |      |
|---|----------------|----------|--------------|------|
| REV. DATE   | DESCRIPTION    | BY       | CHK          | APP  |
| REVISIONS DURING CONSTRUCTION                                                                                   |                |          |              |      |
| P.A. # 71-156                                                                                                   |                |          |              |      |
| NORTHEAST NUCLEAR ENERGY COMPANY<br>SUBSIDIARY OF<br>NORTHEAST UTILITIES                                        |                |          |              |      |
| TITLE: MILLSTONE NUCLEAR POWER STATION - UNIT NO. 3<br>LOGIC DIAGRAM<br>SAFETY FEATURES<br>BUILDING VENTILATION |                |          |              |      |
| BY   | CHKD           | DATE     | DATE         | DATE |
| DATE   | DATE           | DATE     | DATE         | DATE |
| SCALE   | MICROFILM DATE | DWG. NO. | 25212- 28587 |      |
| P.A. # 71-156                                                                                                   |                |          |              |      |
| STONE & WEBSTER ENGINEERING CORPORATION<br>BOSTON, MASS.                                                        |                |          |              |      |
| S & W DWG. NO. 12179- LSK- 22-200                                                                               |                |          |              |      |



Rids

8212220250

