



NOTES:

1. TERMINALS WITHOUT LOCATION MARKS ARE LOCATED IN ANNUNCIATOR CAB. (H13-P630)
2. Δ DENOTES SEQUENCE OF EVENT RECORDER TERMINALS.
3. ALPHABETICAL WIRE MARKS ARE PREFIXED BY: SYSTEM NO., SHEET NO., AND LINE NO. (EXAMPLE R610101A).
4. DEVICE DESIGNATIONS ARE PREFIXED BY: SYSTEM NO. (EXAMPLE 1E21-N5).
5. FOR GRAPHIC STANDARDS, REFER TO DRAWING B-208-001.
6. POWER TO ISOLATORS IS SHOWN ON DWG. B-208-222 SHEET 725-731

LEGEND:

- EXTERNAL WIRE MARK (SEE NOTE 3)
- ∩ INTERNAL WIRE MARK
- H13-P704 COMMON HVAC PANEL
- H13-P969 COMMON AUX RELAY CAB.
- ◇1 CLASS IE - DIV. 1
- ◇2 CLASS IE - DIV. 2
- H13-P148 PCCC TERM. CAB
- - MCC

CONTINUED FROM DWG. B-208-222 SH. 610

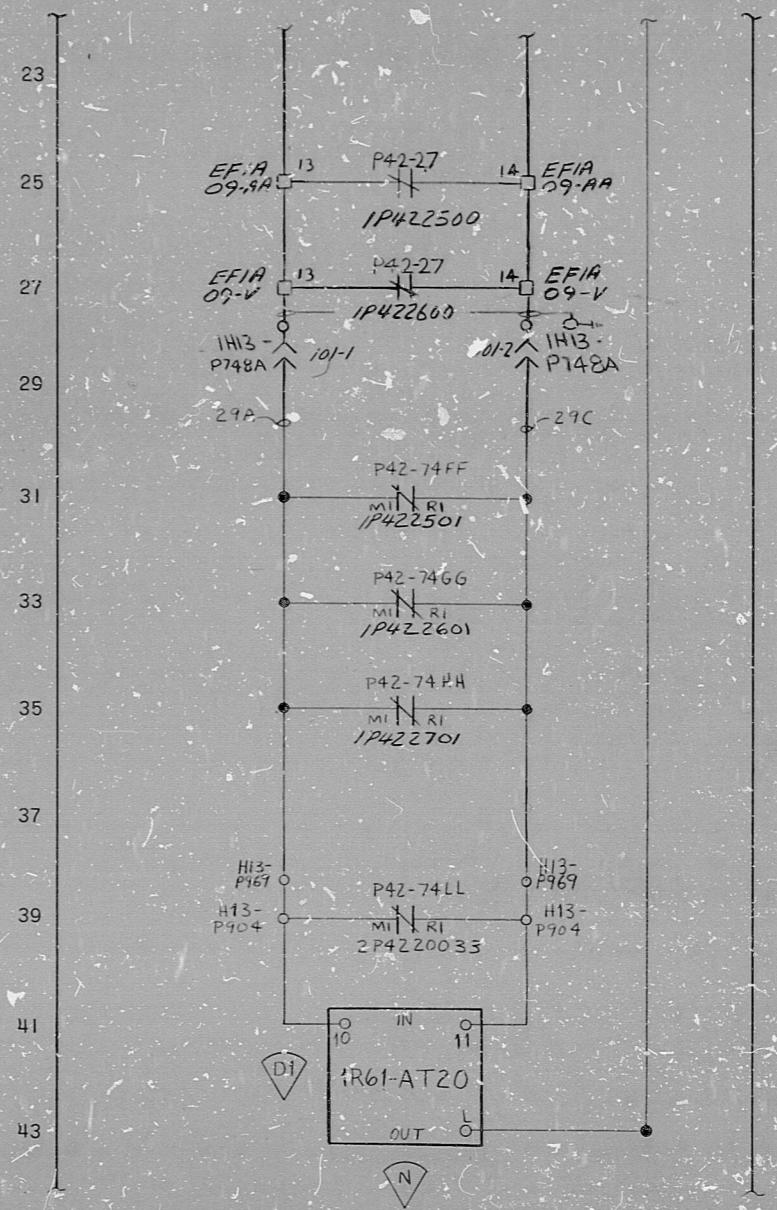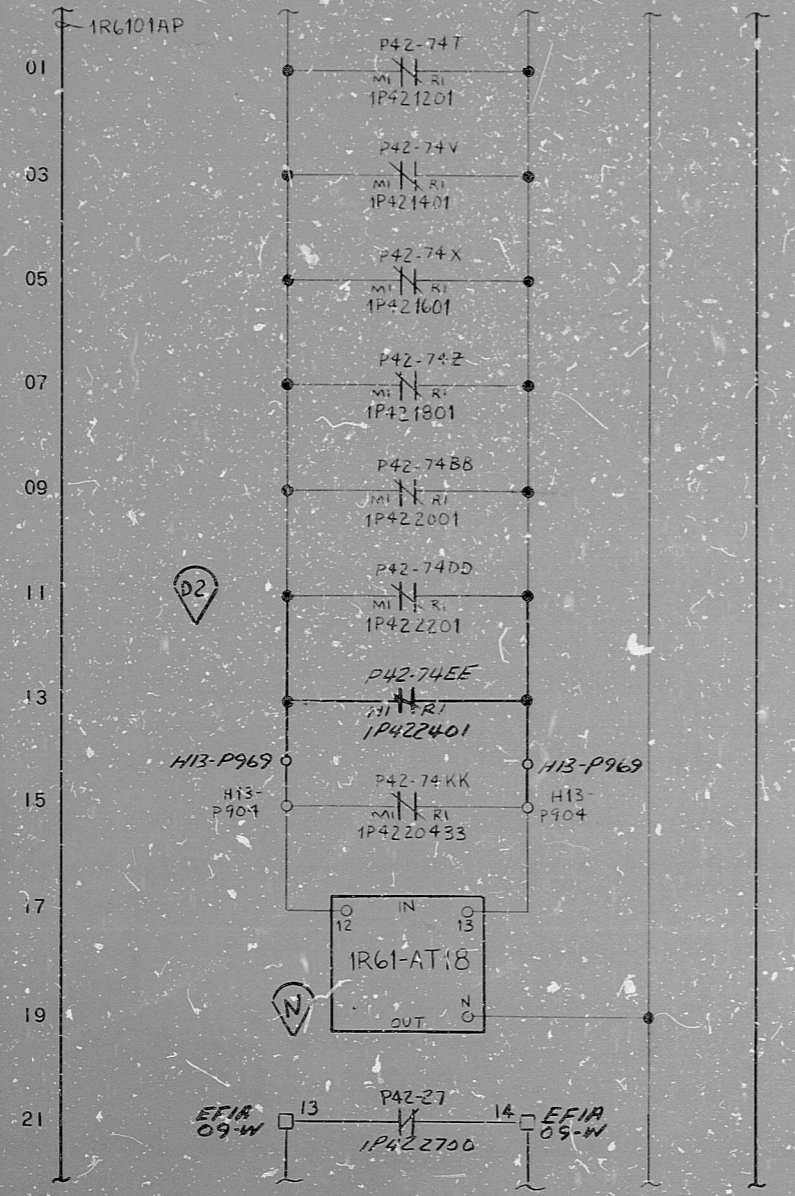

PROC APERTURE CARD

CONTINUED ON TO DWG. B-208-222 SH 612

WCR 1286
 ECN-245-033-01-449
 MOVE LN 29 TO LN 13
 DIV 1 TO DIV 2, U2 TO #1
 DELETE LN 23
 CHANGE LNS 21, 25, 27
 CHANGE PER LN 31, 33, 35

ASDMCC TERM INFO.

REV PER ECN 245-033-01-149
 ADD EAY ASSIGN #
 TERMINAL INFO TO
 LN 28

REV PER ECN 245-033-01-149
 MOVED 27 CONTACT FROM
 LINE 37 TO LINE 21
 ADDED MCC SYMBOLS &
 UNIT INFO, ADDED
 FIELD CIRCUIT LN 29

REV PER ECN 245-033-01-149
 ADDED P42-27 TO LINES
 23, 25, 27 & 37
 ADDED BACK-LOGIC

4/7/71	CONSTRUCTION	
	PRELIMINARY	
	RELEASED FOR	ENGR.
	GILBERT ASSOCIATES, INC. ENGINEERS AND CONSULTANTS	
044549-000	MSB	KLL
	DG	

NUCLEAR SAFETY RELATED

THE CLEVELAND ELECTRIC ILLUMINATING CO.
 PERRY NUCLEAR POWER PLANT UNITS 1 & 2
 ELECTRICAL-ELEMENTARY DIAGRAM
 CONTROL ROOM ANNUNCIATOR
 COMMON HVAC PANEL (H13-P704)

REV	MADE	CHKD	APPROVALS	DATE	REV	MADE	CHKD	APPROVALS	DATE	REV	MADE	CHKD	APPROVALS	DATE	REV	MADE	CHKD	APPROVALS	DATE	WORK ORDER	MADE	CHKD	DR. APP.	ENG. APP.	DATE	DRAWING NUMBER	SYSTEM	SH. NO.	REV.
E	2/1/77	AK		2/1/77	C	JH	SM		12/31/80	B	AK	PK		12/31/78	A	AK				044549-000					04/11/77	04 4549 B-208-222	R61	161	E

E L E M E N T A R Y A N N U N C I A T O R W I R I N G R 6 1 - 6 1 1

Rids

8212220507

