



MOTOR CONTROL CENTER EF2A09 COMPT. M  
480V. AC, 3Ø, 60 HZ.

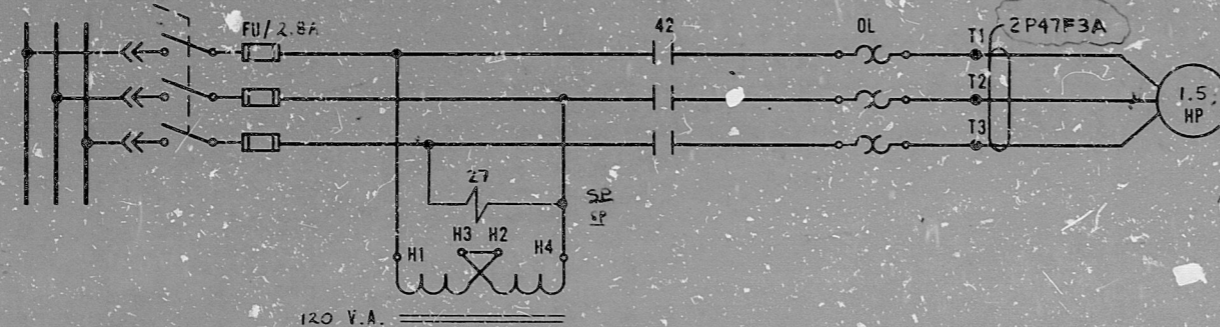

- LEGEND:**
- EXTERNAL WIRE MARK (SEE NOTES 2 AND 3)
  - MCC TERMINAL (WITH DRAW OUT PROVISION)
  - INTERNAL WIRE MARK
  - ◇ SWGR. TERMINAL
  - (D1) CLASS I E DIV 1 THIS SHEET
- W3-P404 COMMON HVAC PNL. B  
W3-P748B P404 TERM CAB-TMOD C47  
74N-AGASTAT GP1GM

- NOTES:**
1. ALL DEVICES WITHOUT LOCATION MARKS ARE LOCATED IN M.C.C.
  2. ALPHABETICAL WIRE MARKS ARE PREFIXED BY: SYSTEM NO., SHEET NO. AND LINE NO. (EXAMPLE P470505A)
  3. POTENTIAL WIRE MARKS ARE PREFIXED BY: SYSTEM NO. AND SHEET NO. (EXAMPLE P4705T3)
  4. DEVICE DESIGNATIONS ARE PREFIXED BY: SYSTEM NO. (EXAMPLE P47-47)
  5. FOR GRAPHIC STANDARDS, REFER TO DRAWING B-208-001.

**REFERENCE:**  
BLOCK DIAGRAM B-261-178 SH.3

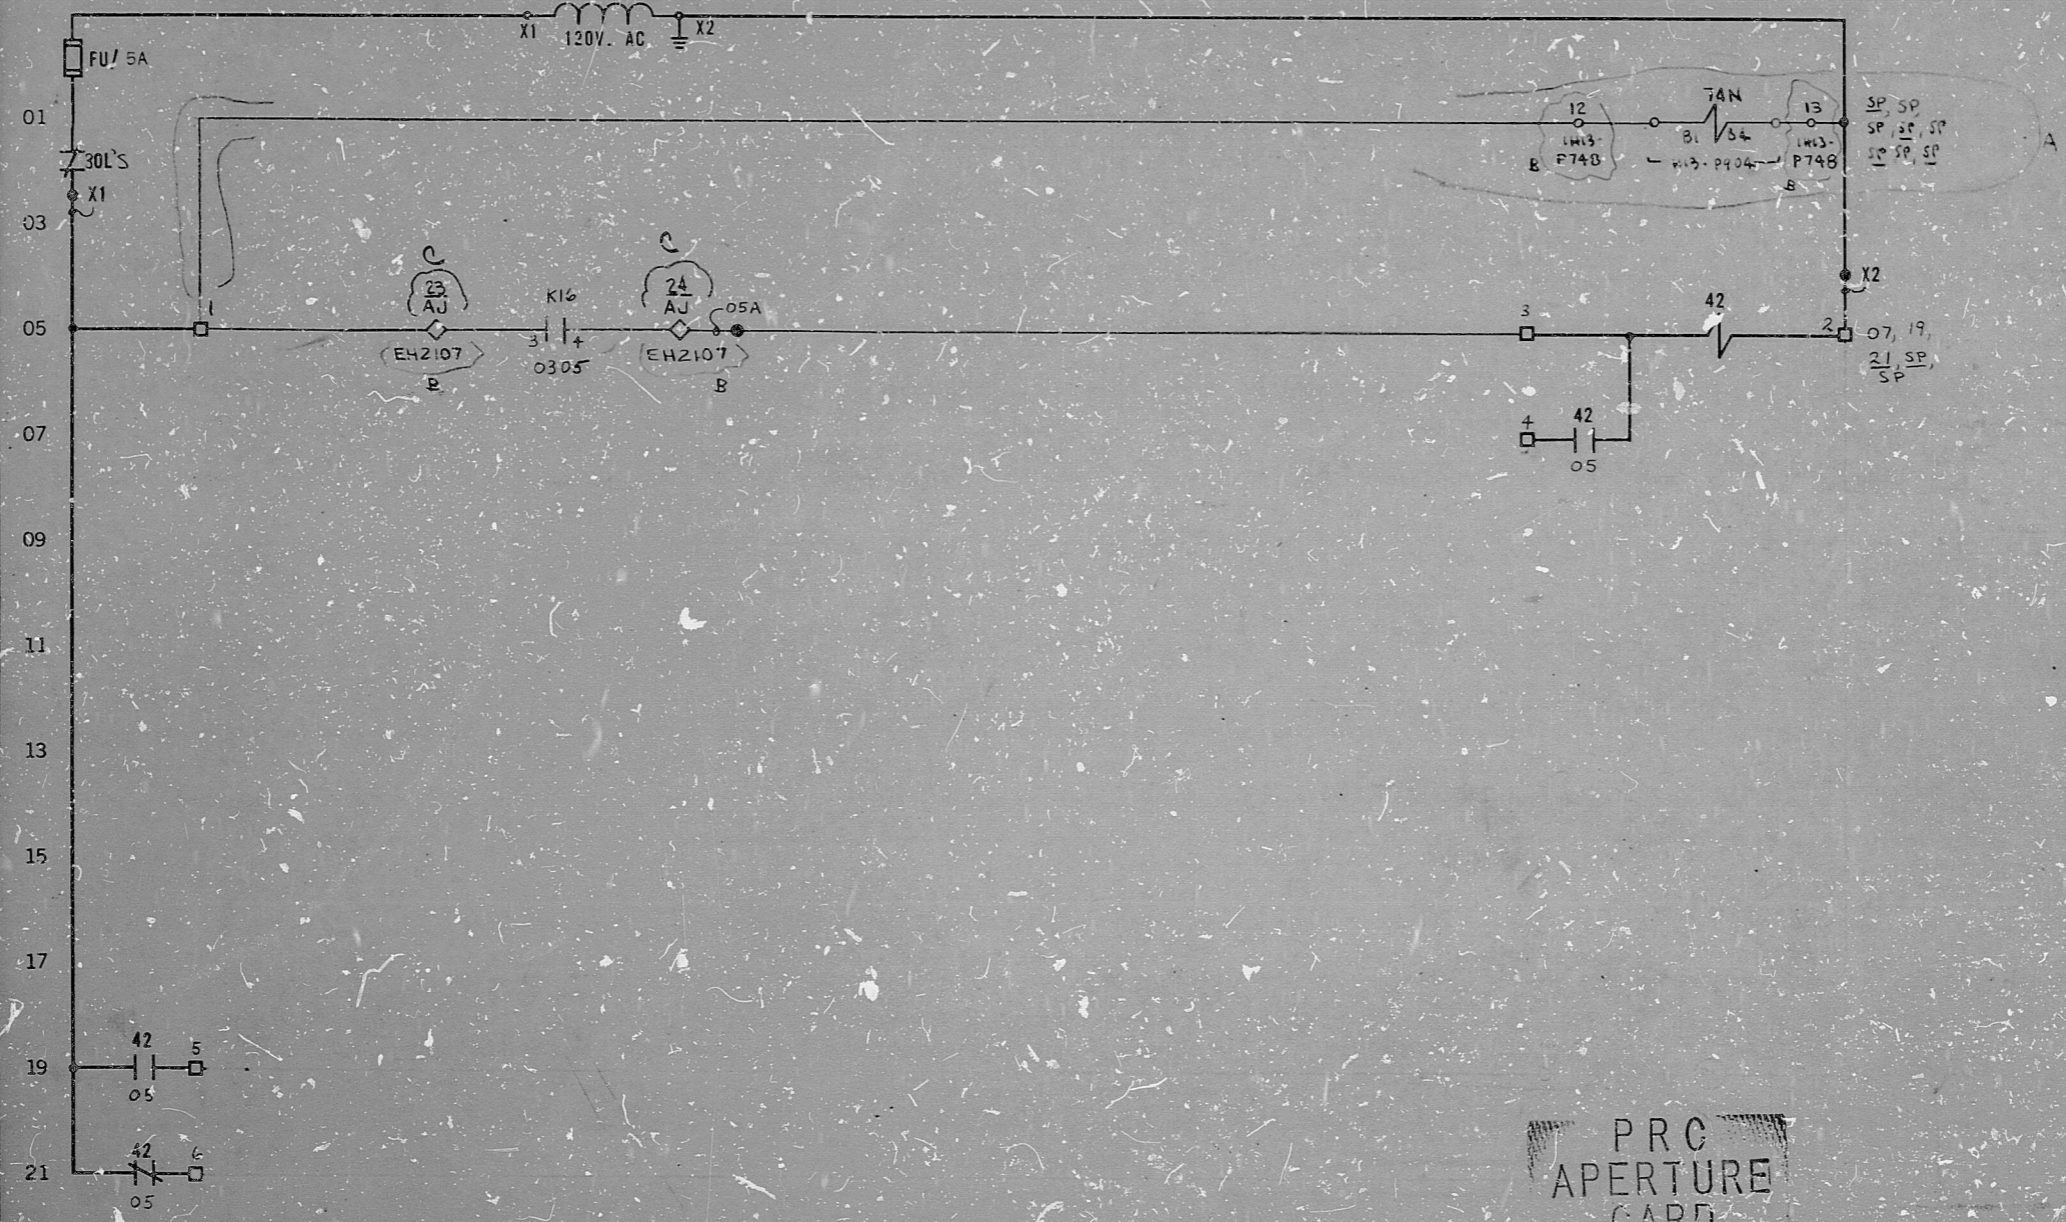

PRC  
APERTURE  
GARD

(D1) NUCLEAR SAFETY RELATED  
THE CLEVELAND ELECTRIC ILLUMINATING CO.

825-77	CONSTRUCTION	TFF
	PRELIMINARY	
DATE	RELEASED FOR	ENGR.

ADDED SWGR INFO (LINEOS)	ADDED FITS INFO PER ECN	ADDED 74N PER ECN	READING PA	GILBERT ASSOCIATES, INC. ENGINEERS AND CONSULTANTS
NIL	245-033-01-22	245-033-01-22		

REV	MADE	CHKD	APPROVALS	DATE	RLV	MADE	CHKD	APPROVALS	DATE	REV	MADE	CHKD	APPROVALS	DATE	REV	MADE	CHKD	APPROVALS	DATE	WORK ORDER	MADE	CHKD	DR. APP.	ENG. APP.	DATE	DRAWING NUMBER	SYSTEM	SH. NO.	REV.			
																					044549-000	TEL	NPS	DEG	TFF	825-77	04	4549	B-258-178	P47	05	C

E L E M E N T A R Y D I A G R A M P 4 7 O I L P U M P F O R B O O I C

11  
11  
8.5"  
8.5"  
11"  
17"

Rids

82L2220543

