




RIDS-PDR

8107130511

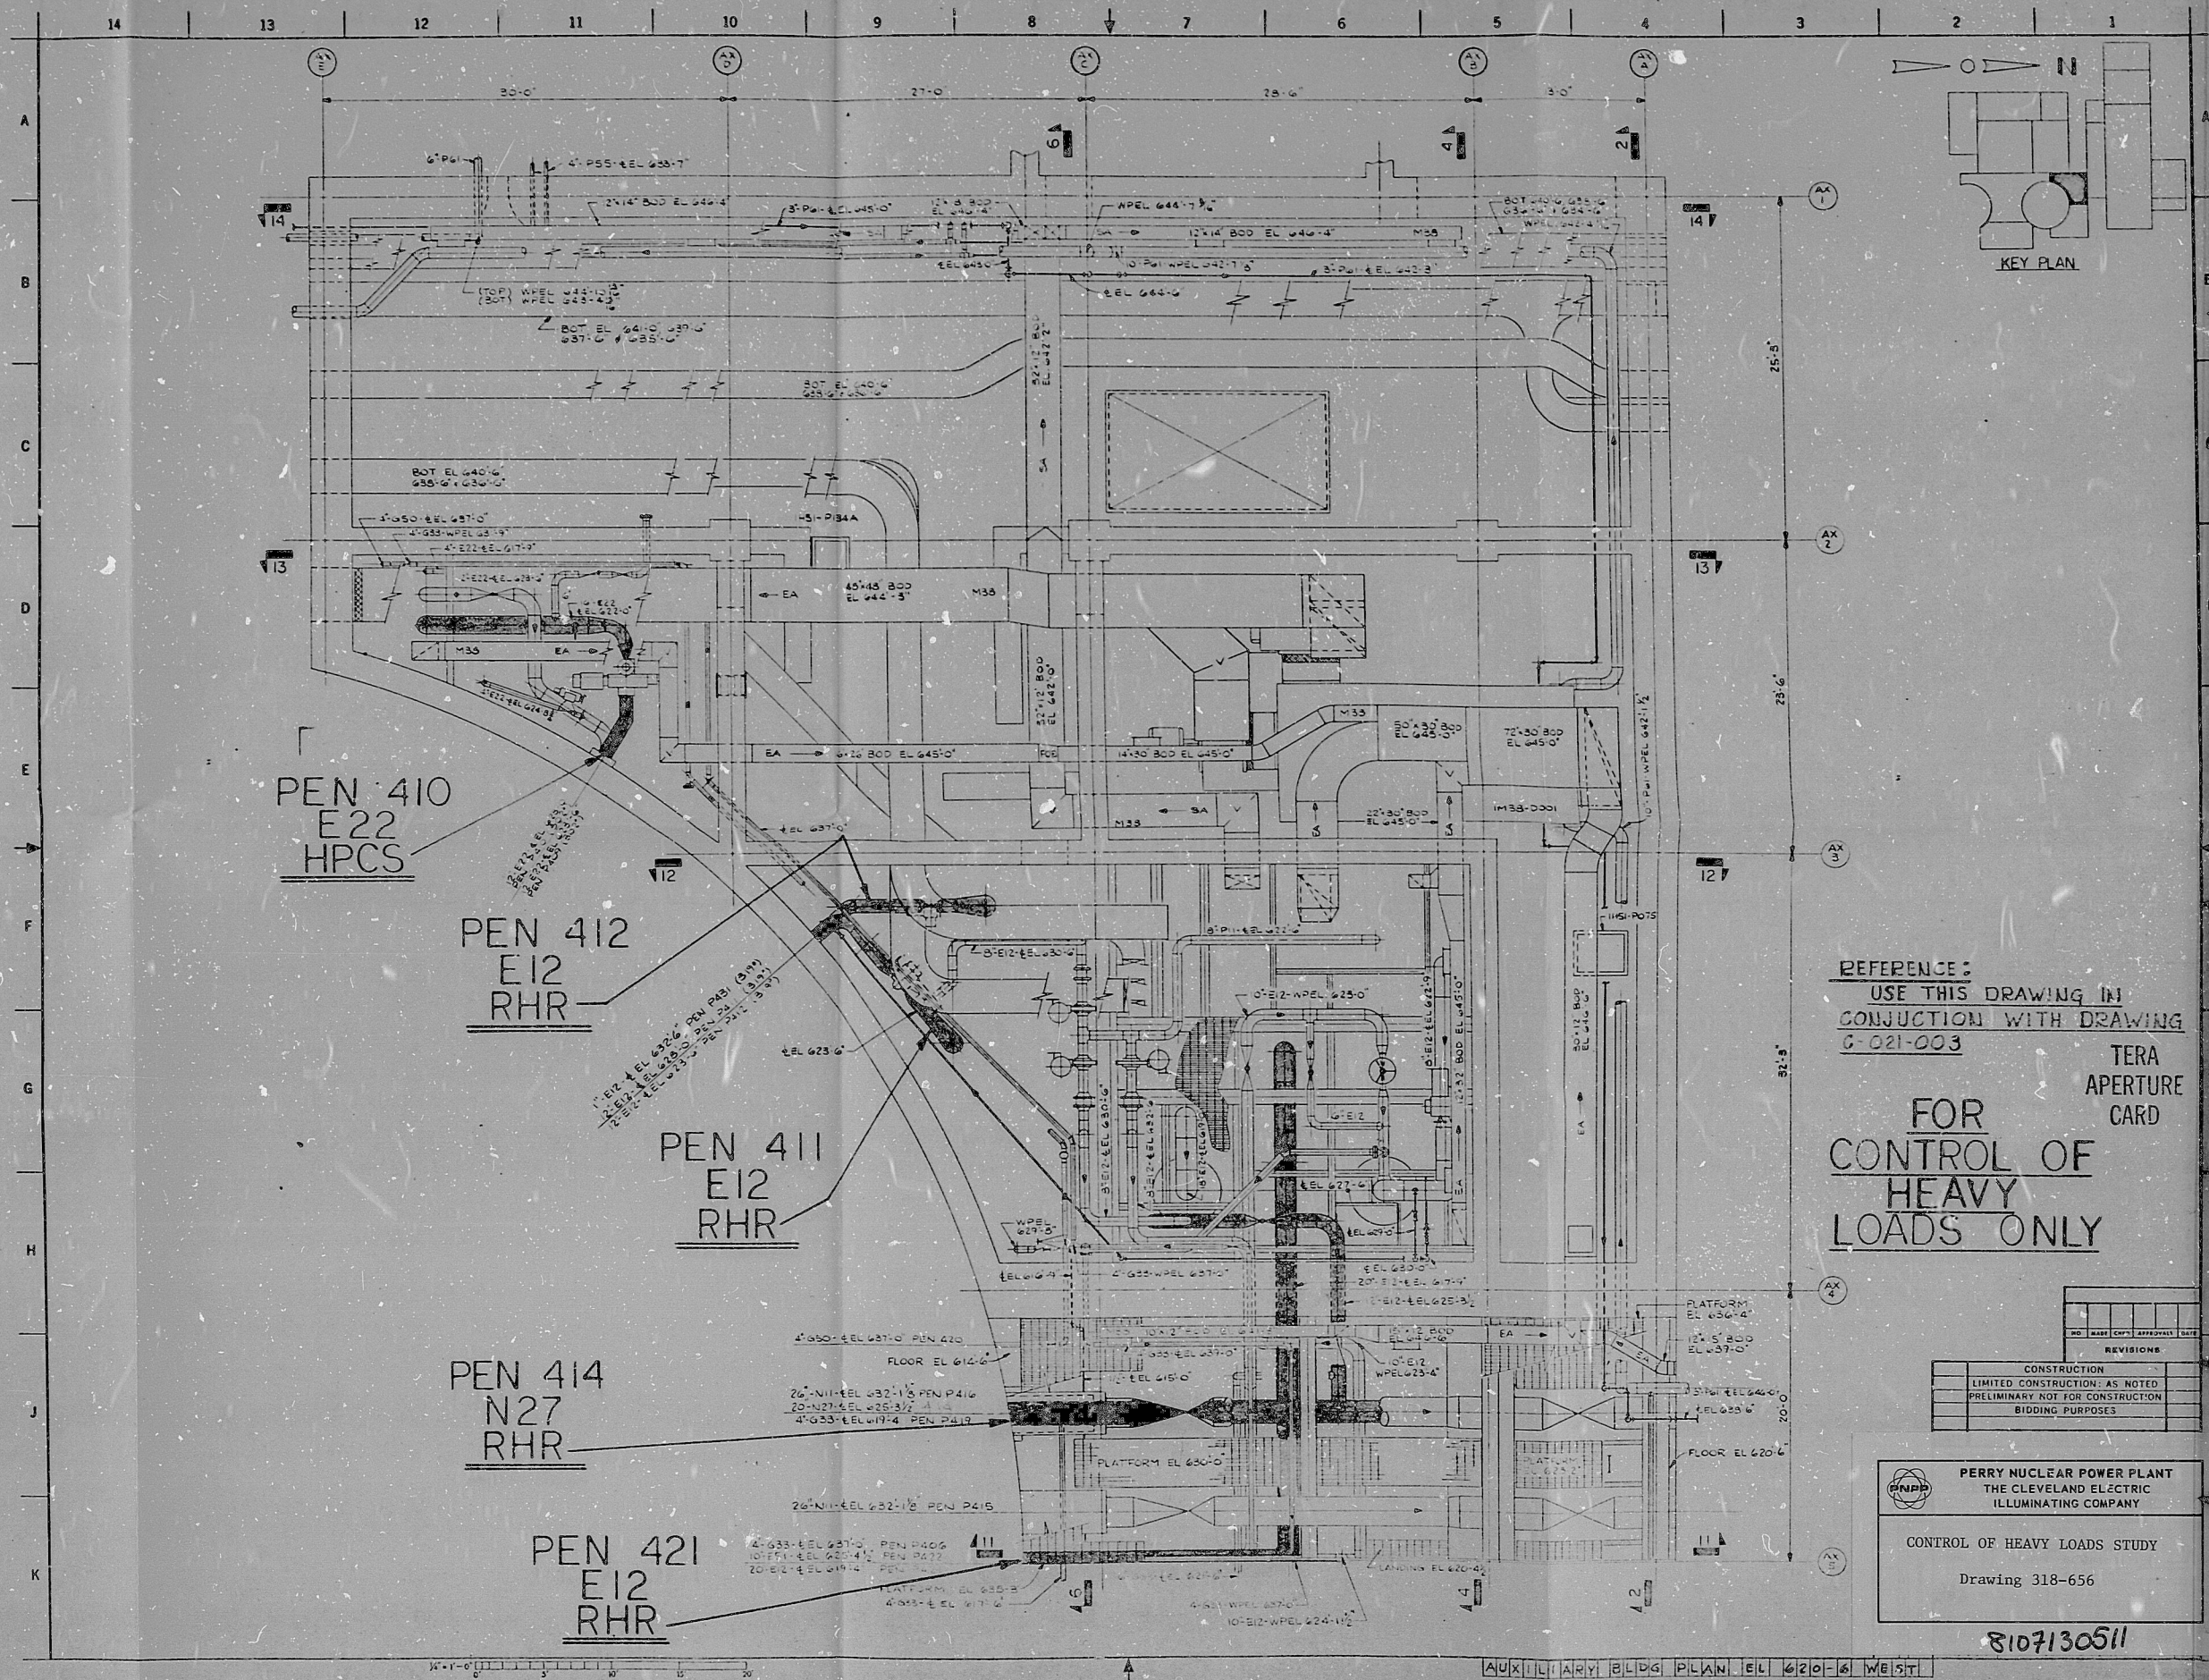