

17"


17"

11"

11"

8.5"

8.5"

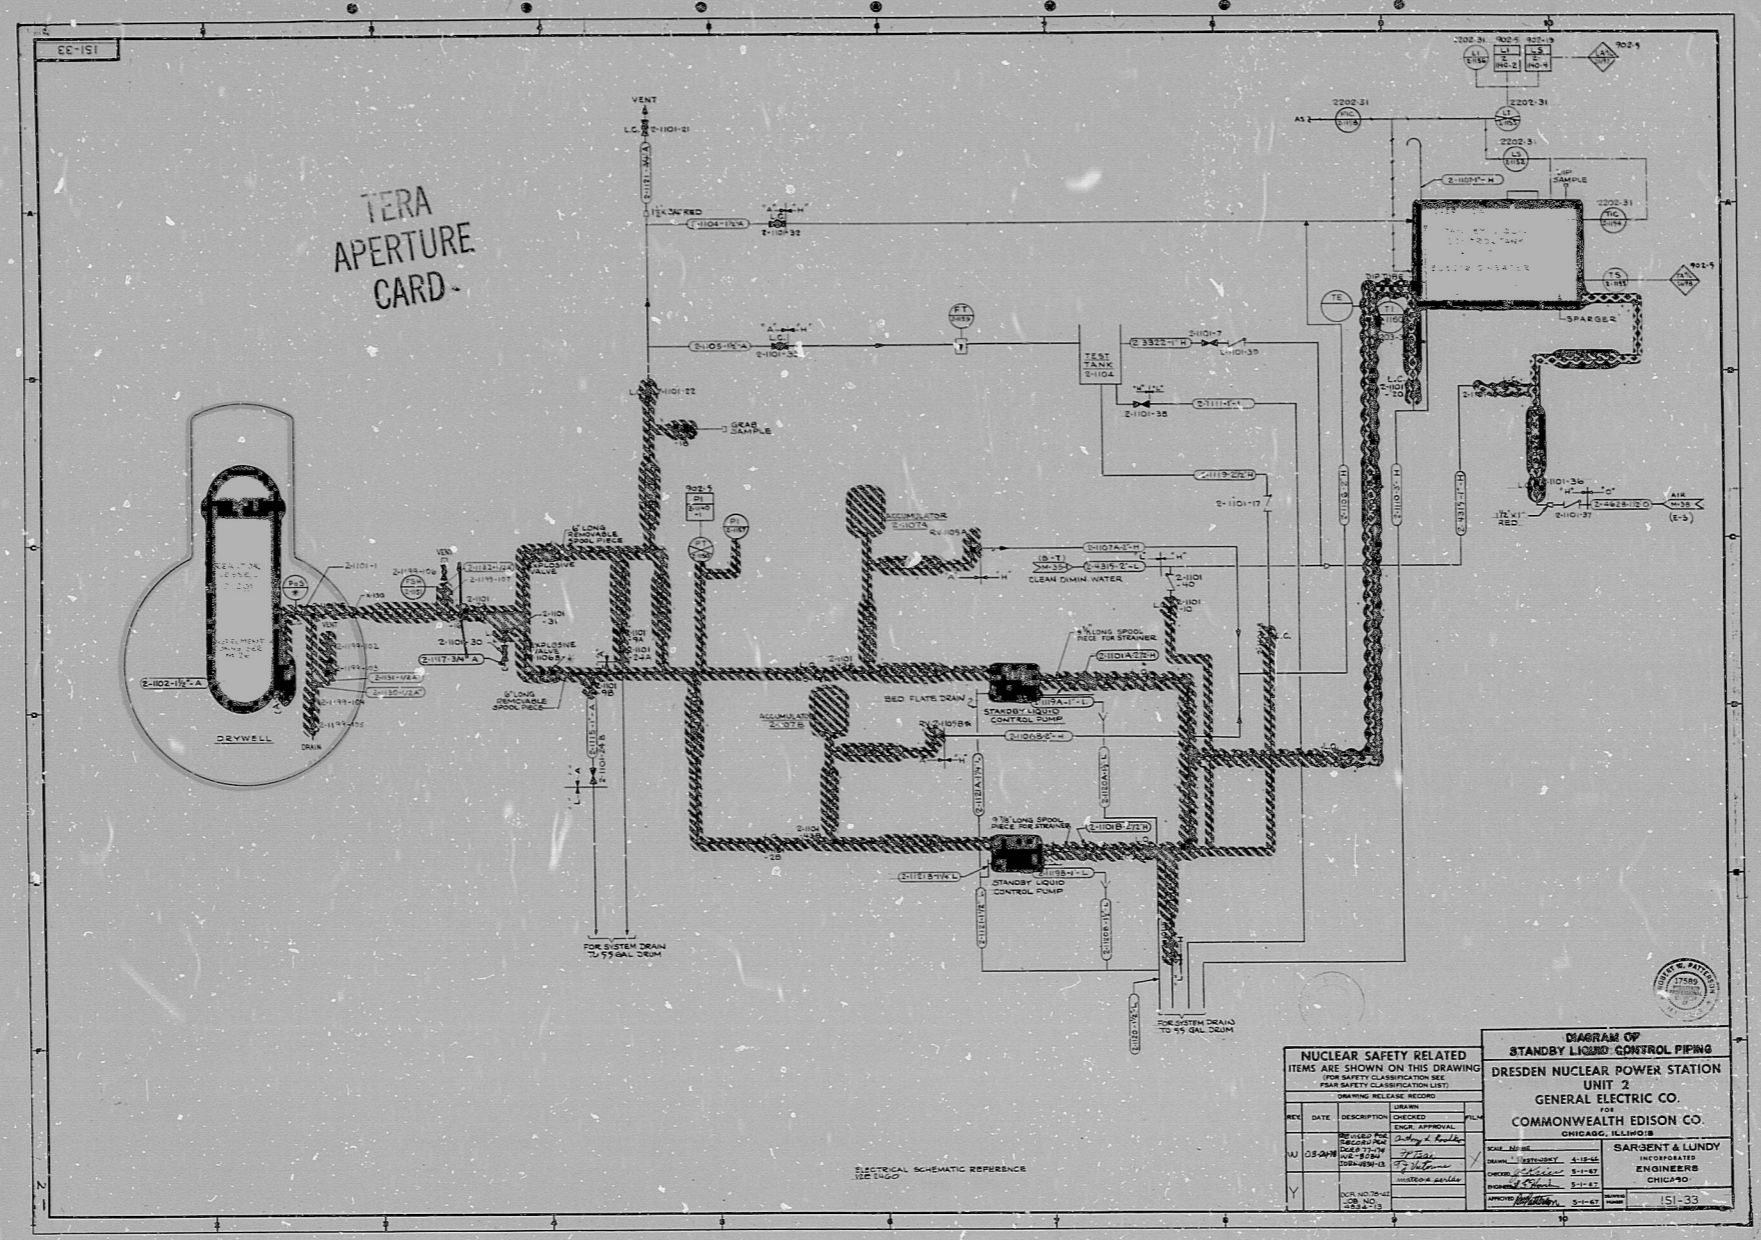

8.5"

8.5"

11"

11"

17"

17"

BAS

8107130533

