

11

11

8.5"

8.5"

11"

17"

11


11

8.5"

8.5"

11"

17"

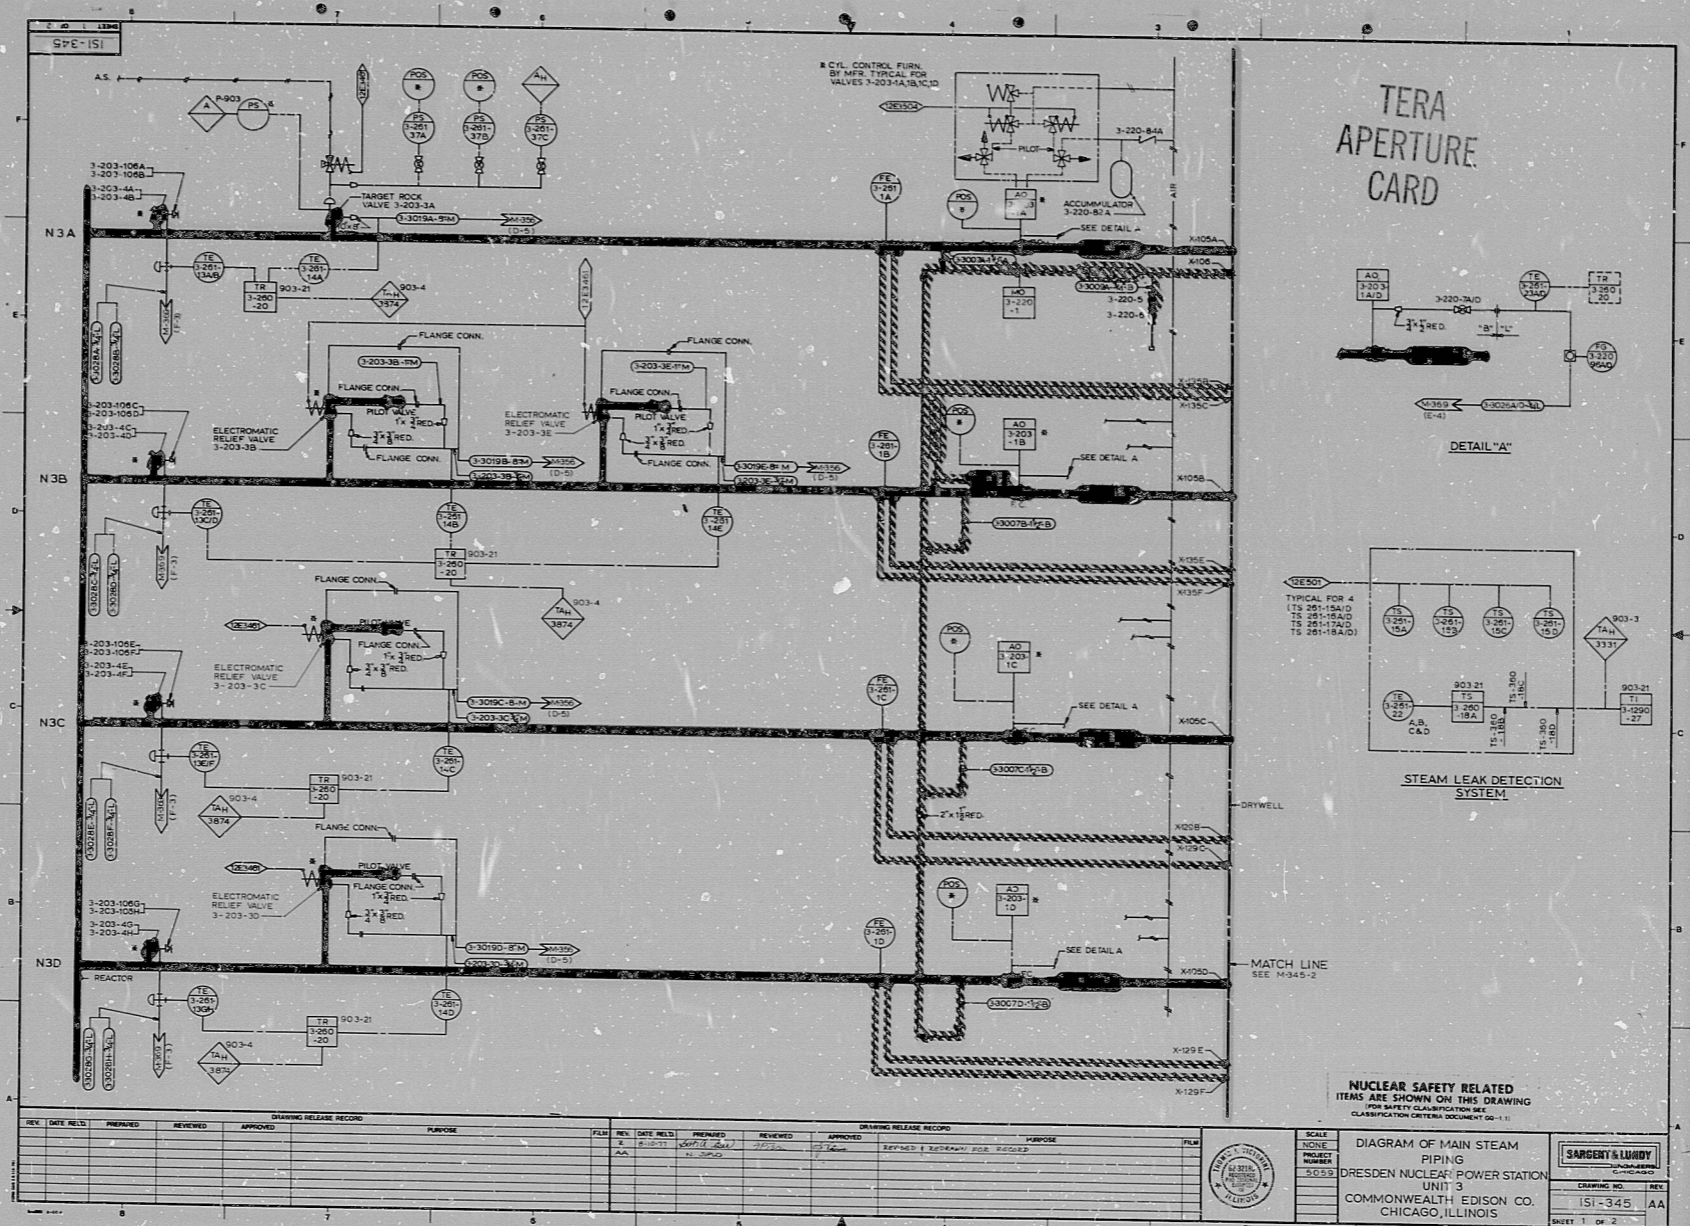

DRAWING RELEASE RECORD				DRAWING RELEASE RECORD			

NUCLEAR SAFETY RELATED  
ITEMS ARE SHOWN ON THIS DRAWING  
FOR SAFETY CLASSIFICATION SEE  
CLASSIFICATION CRITERIA DOCUMENT 00-11

DIAGRAM OF MAIN STEAM  
PIPING  
DRESDEN NUCLEAR POWER STATION  
UNIT 3  
COMMONWEALTH EDISON CO.  
CHICAGO, ILLINOIS

SARGENT & LUNDY  
ENGINEERS  
SI-345  
AA  
SHEET 1 OF 2

RIS

8107130541

