

17"


17"

11"

11"

8.5"

8.5"

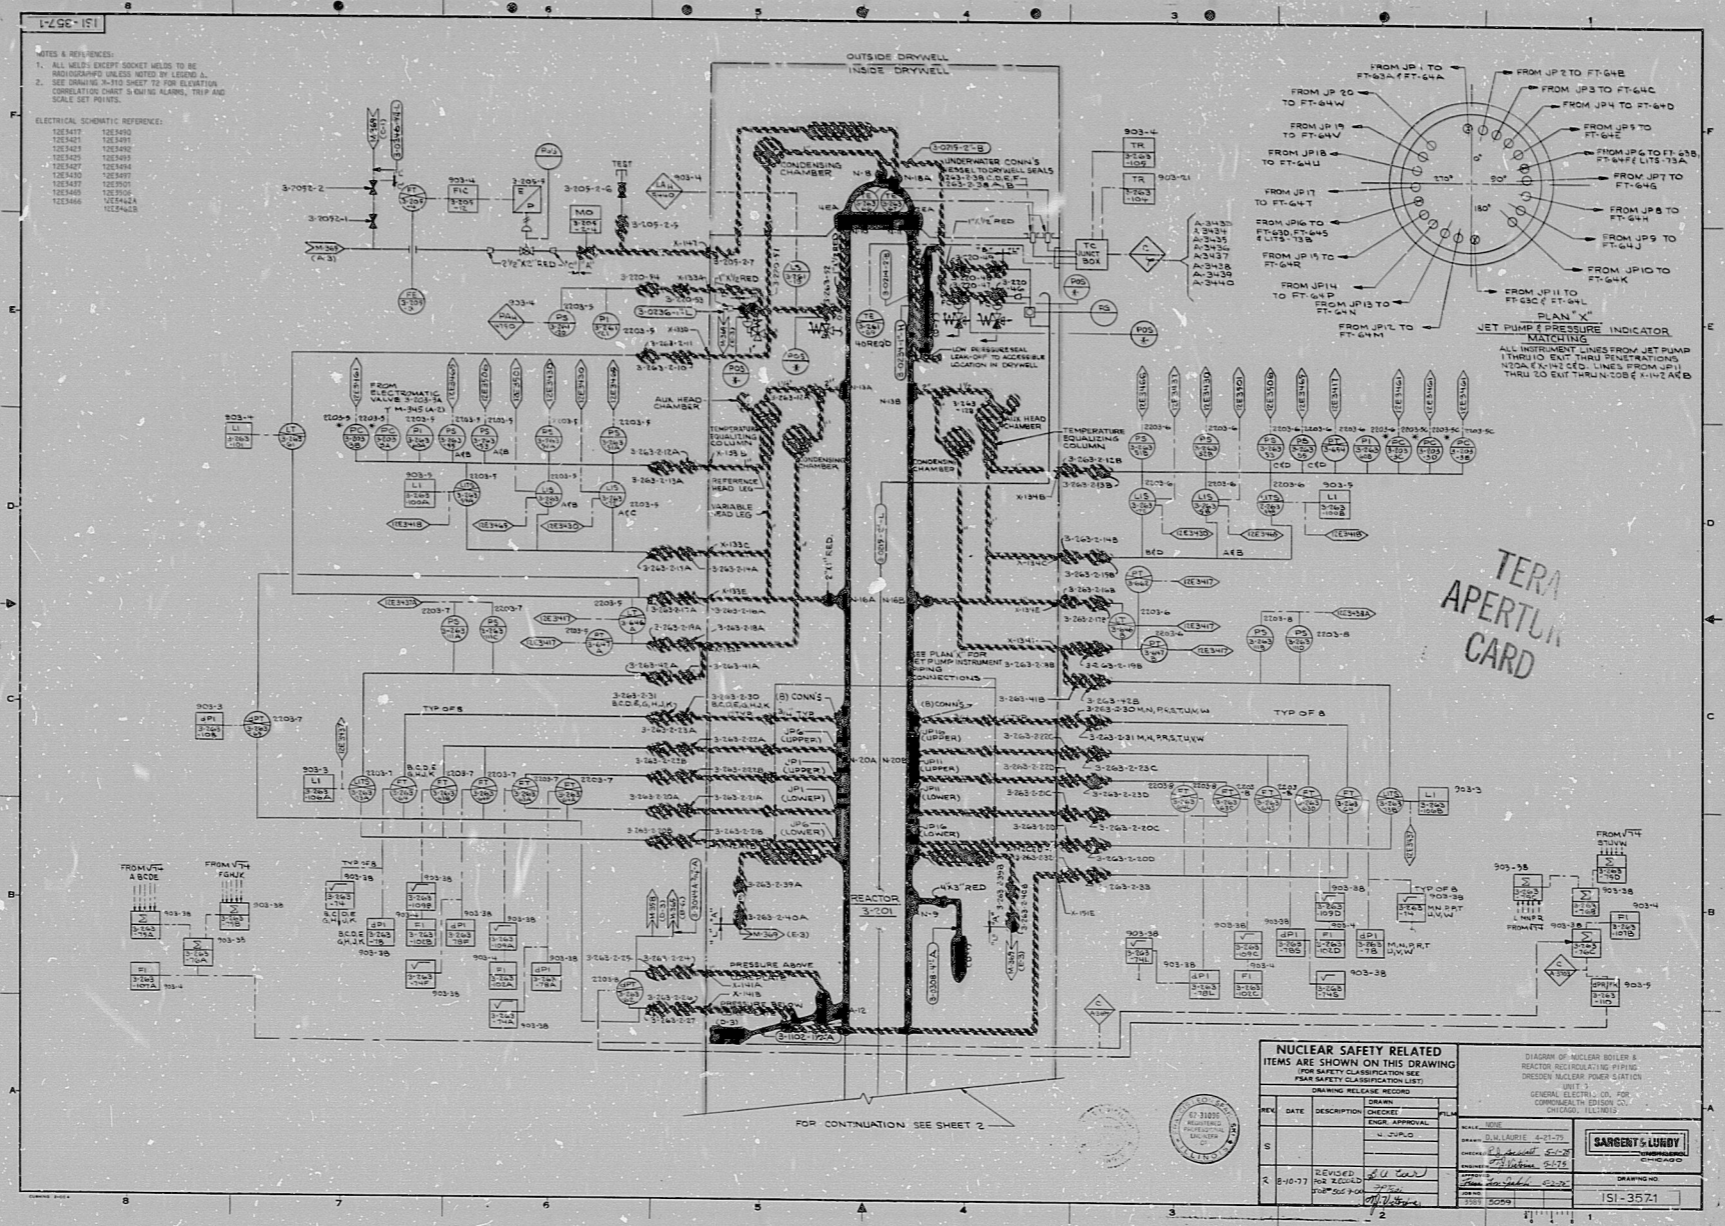

NUCLEAR SAFETY RELATED ITEMS ARE SHOWN ON THIS DRAWING

FOR SAFETY CLASSIFICATION SEE DRAWING RELEASE RECORD








FOR CONTINUATION SEE SHEET 2

8.5"

8.5"

11"

11"

17"

17"

8105

8107130554

