


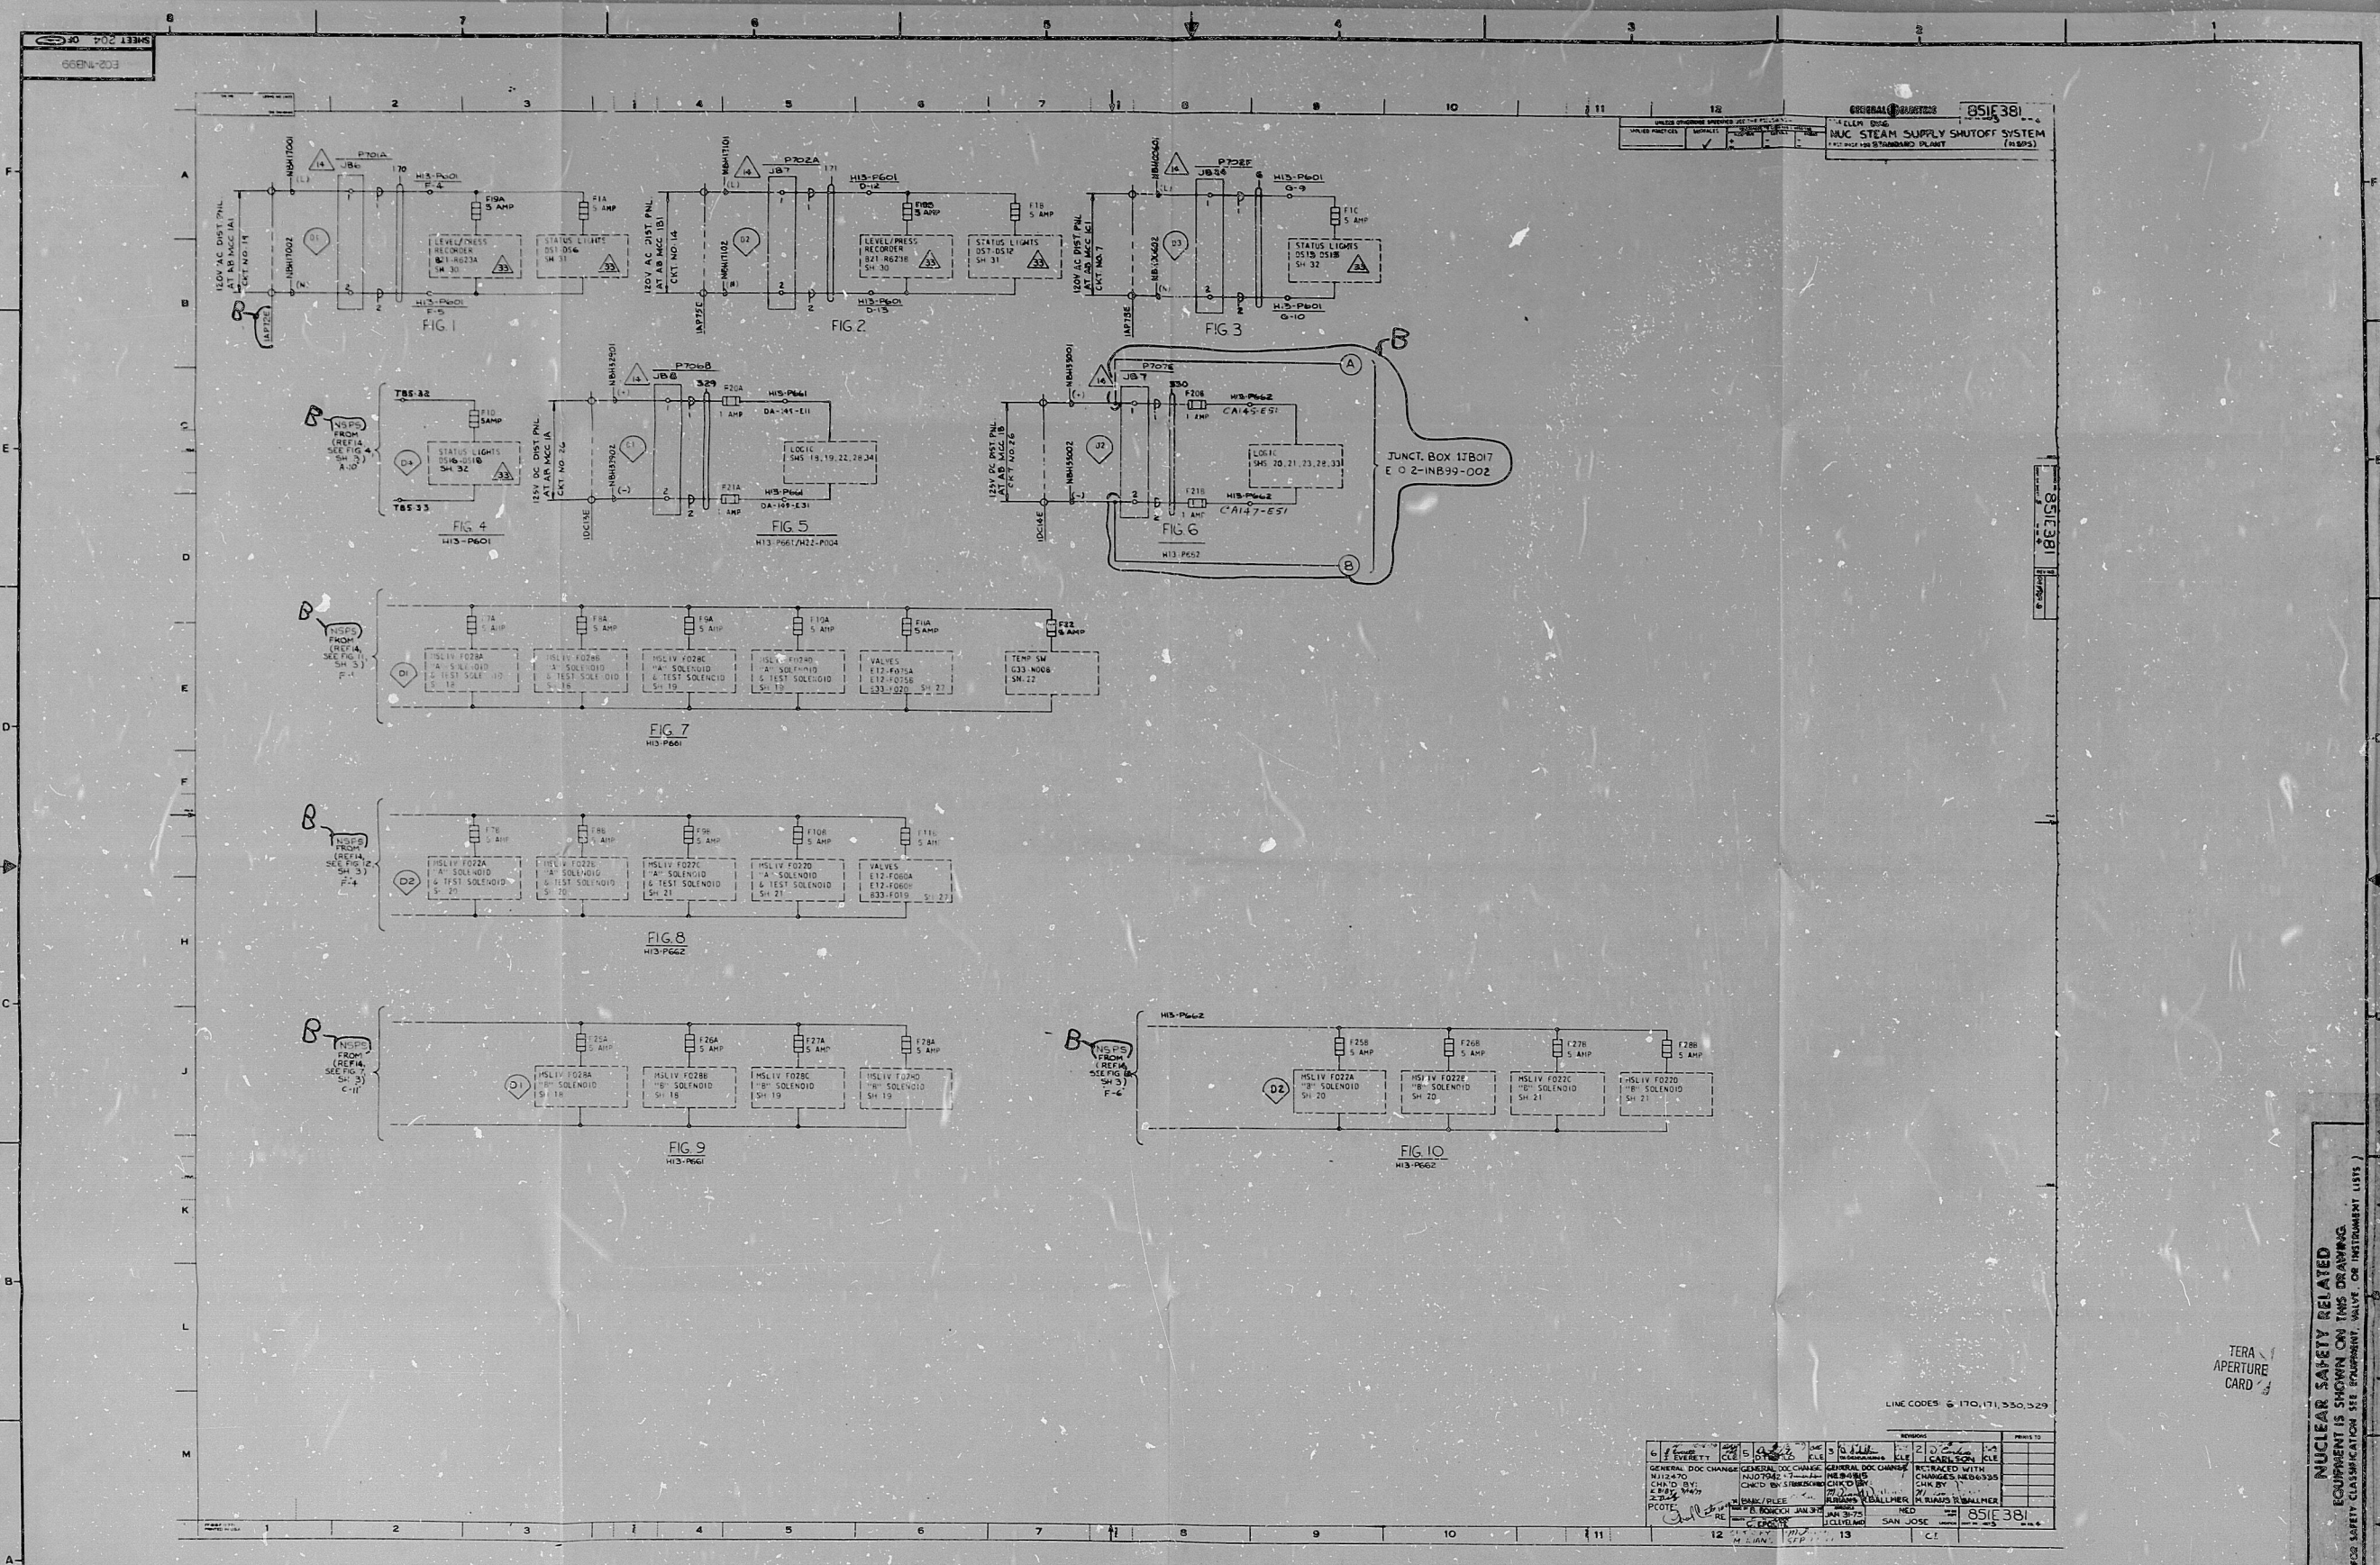


NUCLEAR SAFETY RELATED
EQUIPMENT IS SHOWN ON THIS DRAWING
(FOR SAFETY CLASSIFICATION SEE EQUIPMENT, VALVE OR INSTRUMENT LISTS)

TERA
APERTURE
CARD




SCHEMATIC DIAGRAM	
NUCLEAR BOILER SYSTEM (NB)	
NUCLEAR STEAM SUPPLY SHUT-OFF SYSTEM (NSSS)	
(K-2999)	
CLINTON POWER STATION UNIT 1	
ILLINOIS POWER COMPANY	
CLINTON, ILLINOIS	
DRAWING NO.	REV.
E02-INB99	B
SHEET 204 OF 204	

Rib

8107140177

