


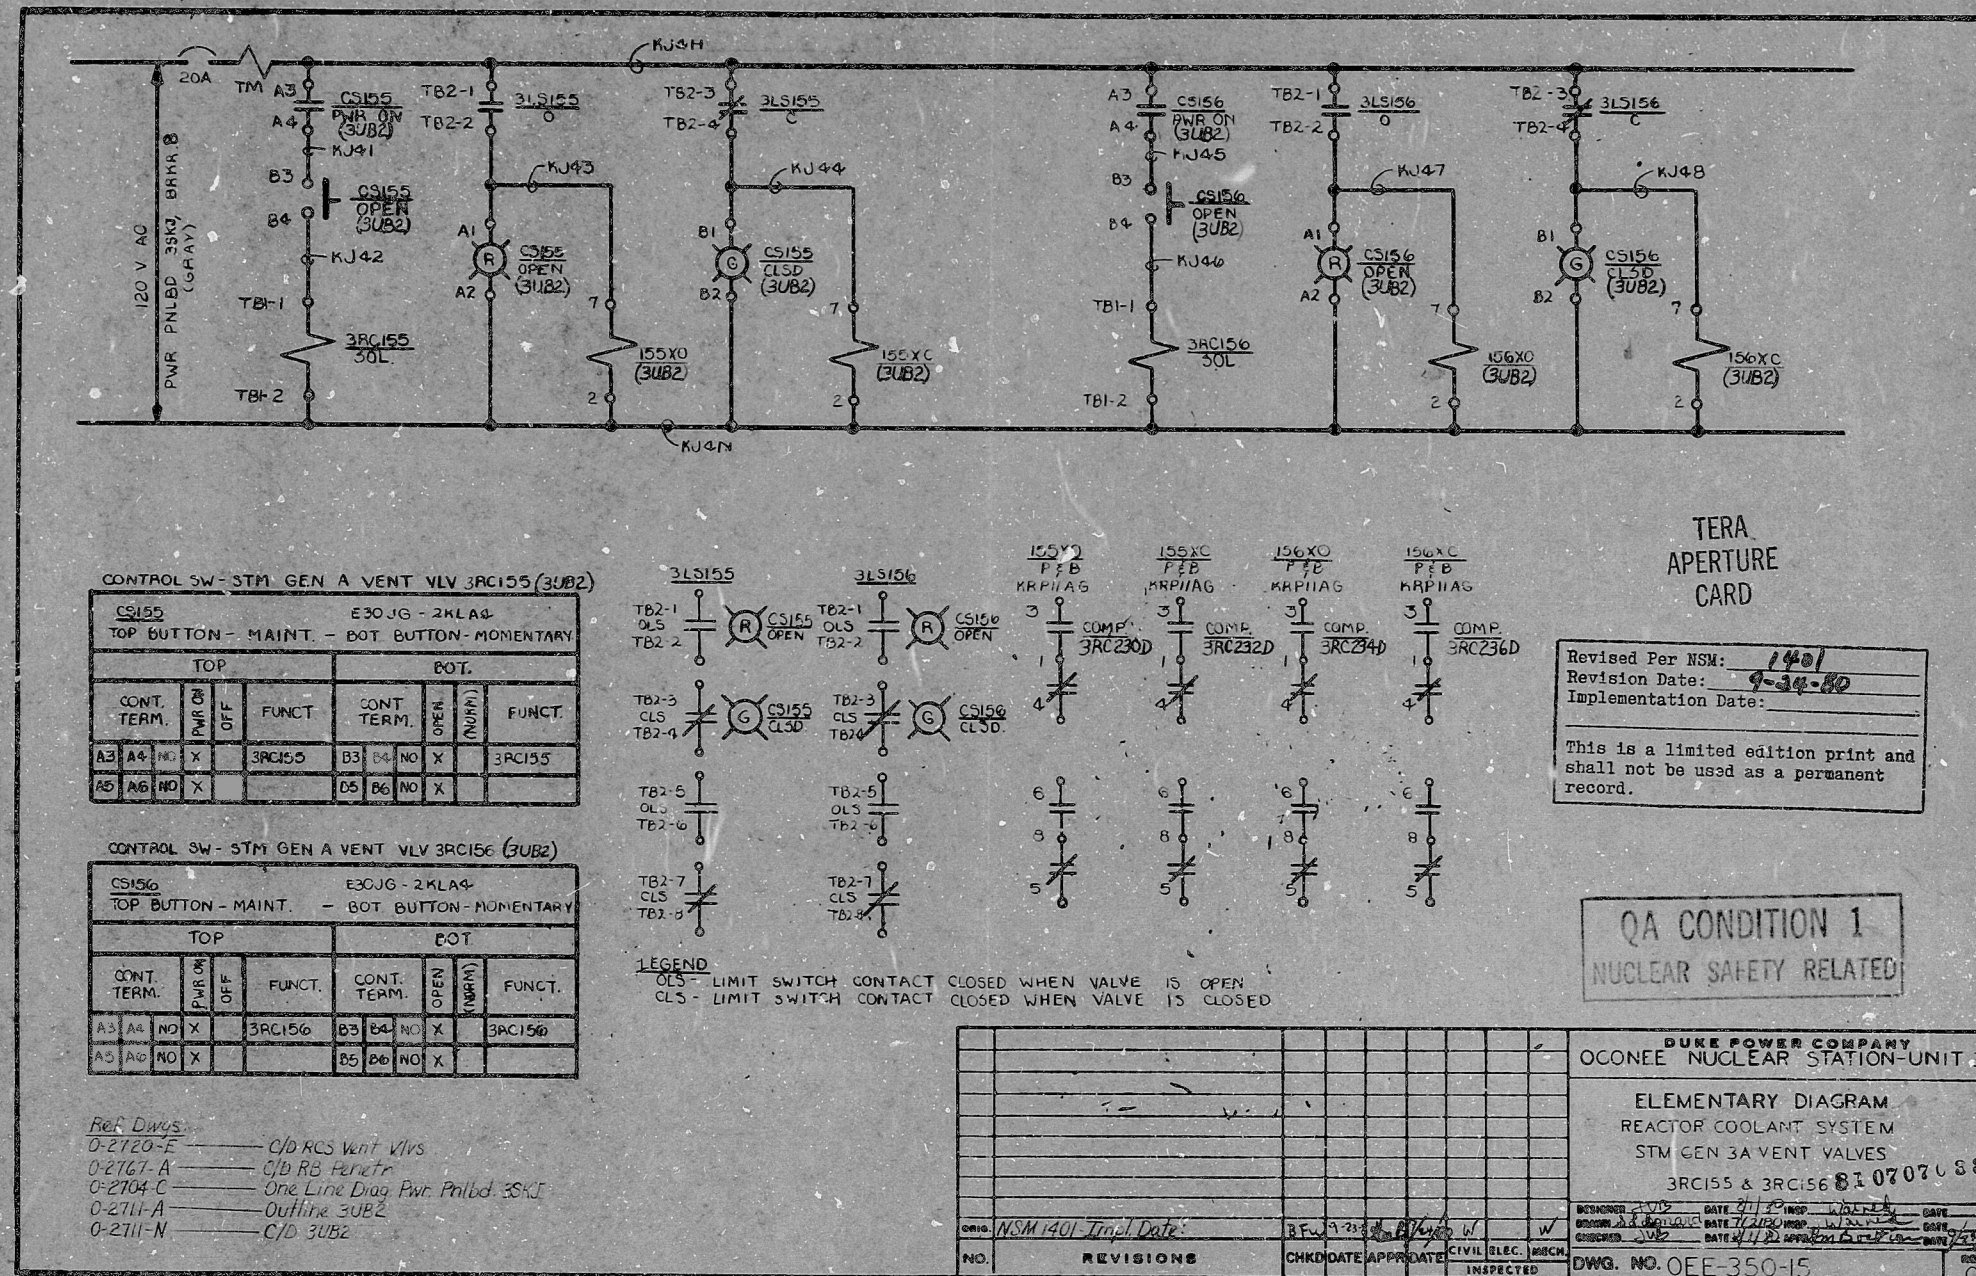

RDS

8107140207

