
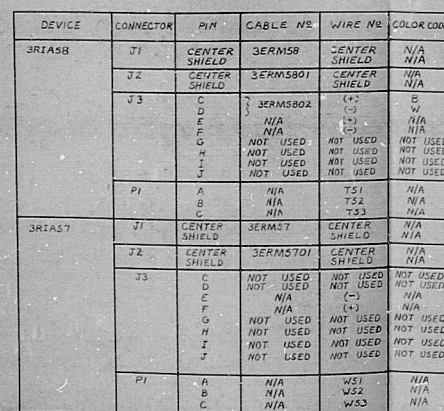


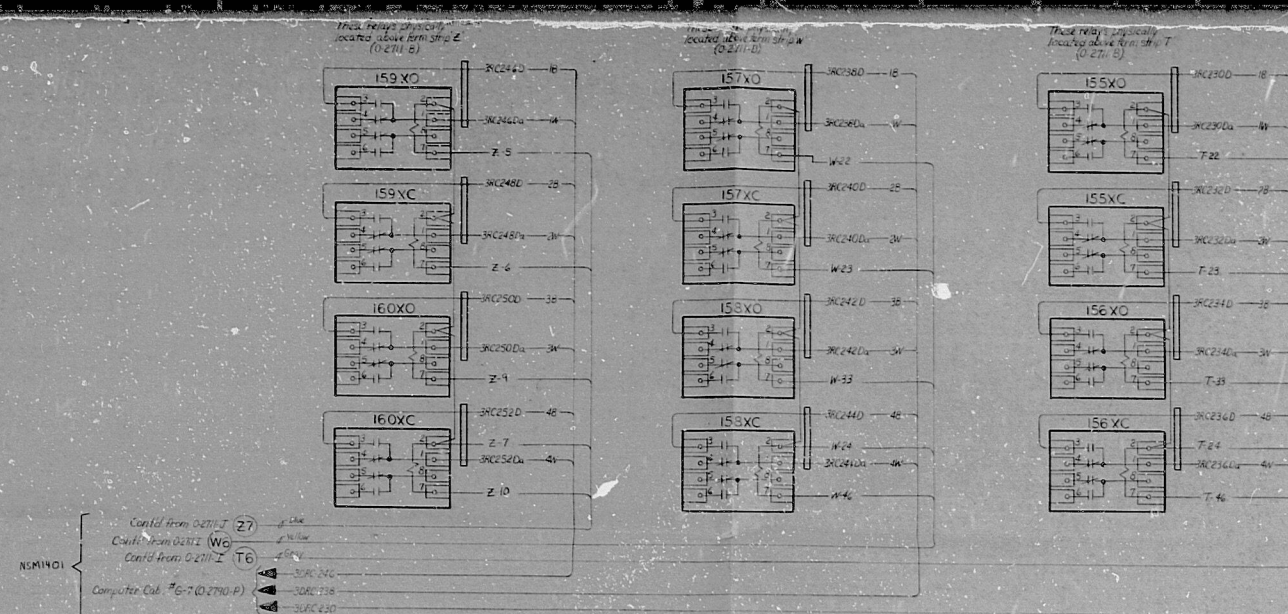

POST-ACCIDENT MONITORING INDICATOR PANEL (REAR VIEW)
FOR PHYSICAL LOC. SEE O-2711 & O-711-J

DEVICE	CONNECTOR	PIN	CABLE NO.	WIRE NO.	COLOR CODE
SR1A58	J1	CENTER SHIELD	3ERMS8	CENTER SHIELD	N/A

Revised Per NSMs: 1401
Revision Date: 5/27/81
Implementation Date: _____

This is a limited edition print and shall not be used as a permanent record.

QA CONDITION 1
NUCLEAR SAFETY RELATED

TERA
APERTURE
CARD

UNCONTROLLED
JUN 18 1981
COPY

DUKE POWER COMPANY
OCONEE NUCLEAR STATION UNIT 3

CONNECTION DIAGRAM
UNIT CONTROL BOARDS
3UB1 & 3UB2

DESIGNER <i>W. C. C.</i>	DATE <i>7-22-85</i>	INSP <i>W. C. C.</i>	DATE
DRAWN <i>W. C. C.</i>	DATE <i>7-22-85</i>	INSP <i>W. C. C.</i>	DATE
CHECKED <i>W. C. C.</i>	DATE <i>7-22-85</i>	APP. <i>W. C. C.</i>	DATE <i>10-23</i>
SCALE	DWG. NO. <i>02711-N</i>		
NTS			

[illegible]

RDS

8107140225

