



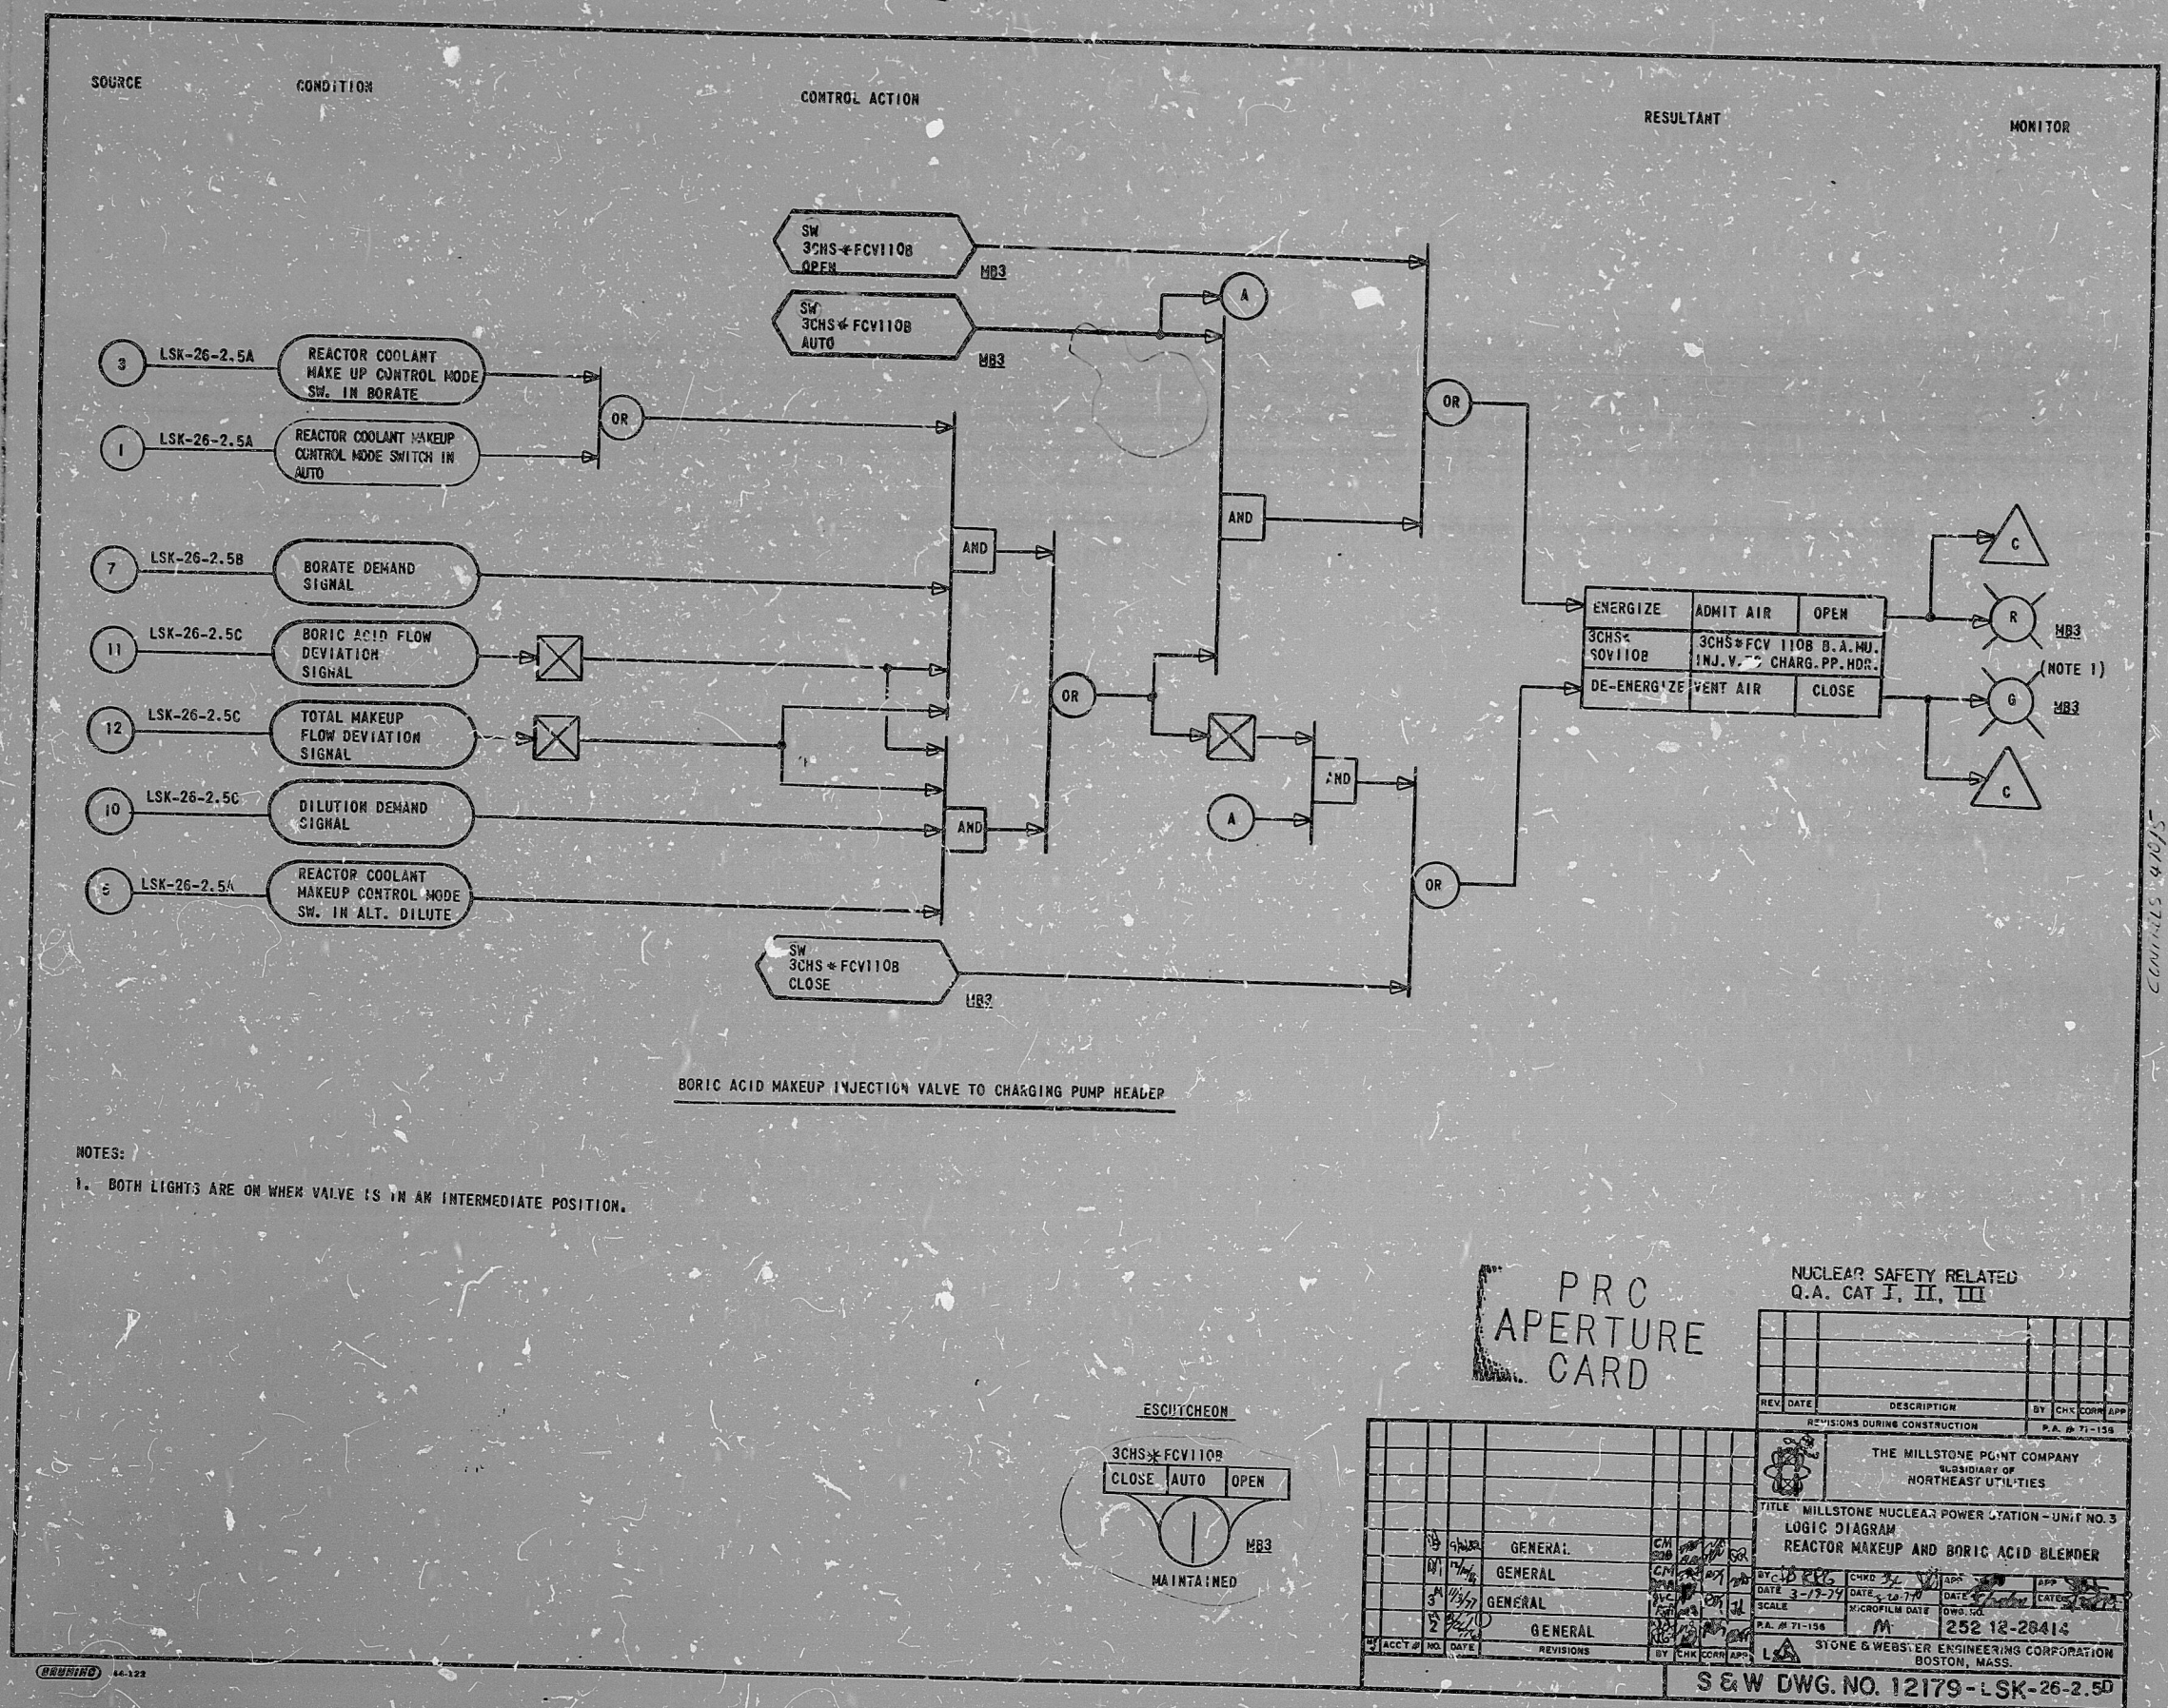

PRC
APERTURE
CARD

NUCLEAR SAFETY RELATED
Q.A. CAT I, II, III

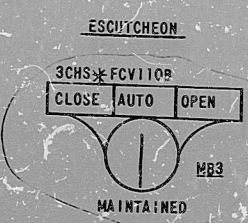

REV	DATE	DESCRIPTION	BY	CHK	APP
S & W DWG. NO. 12179-LSK-26-2.5D

Rids

8212230074

