
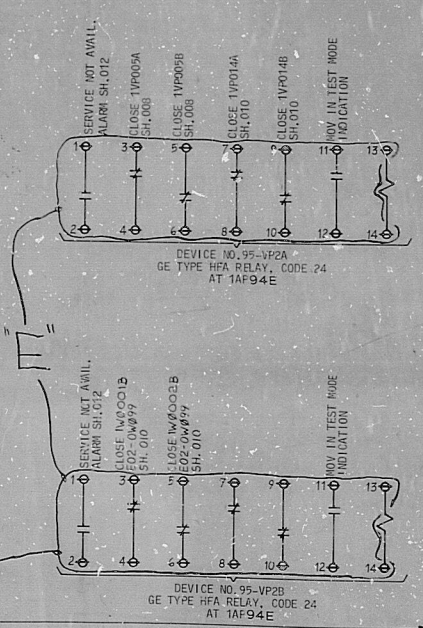
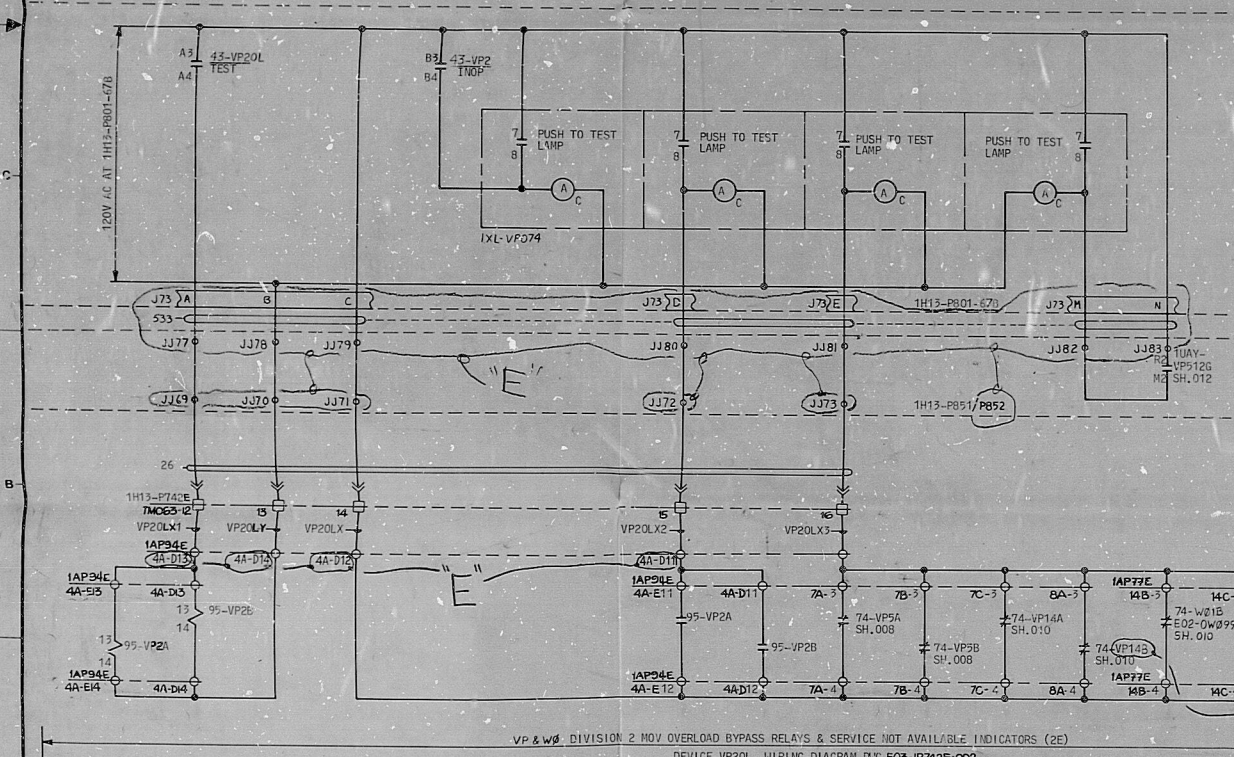
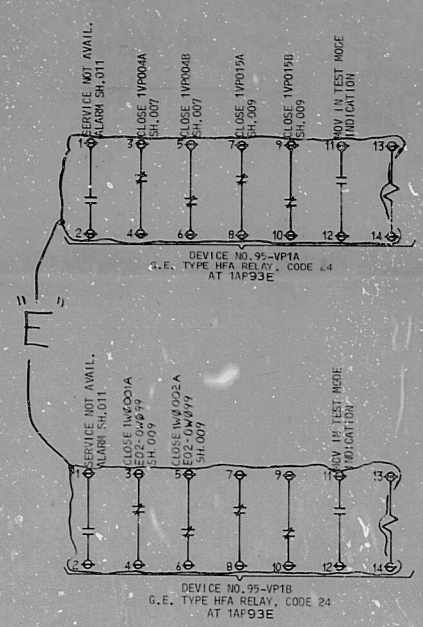


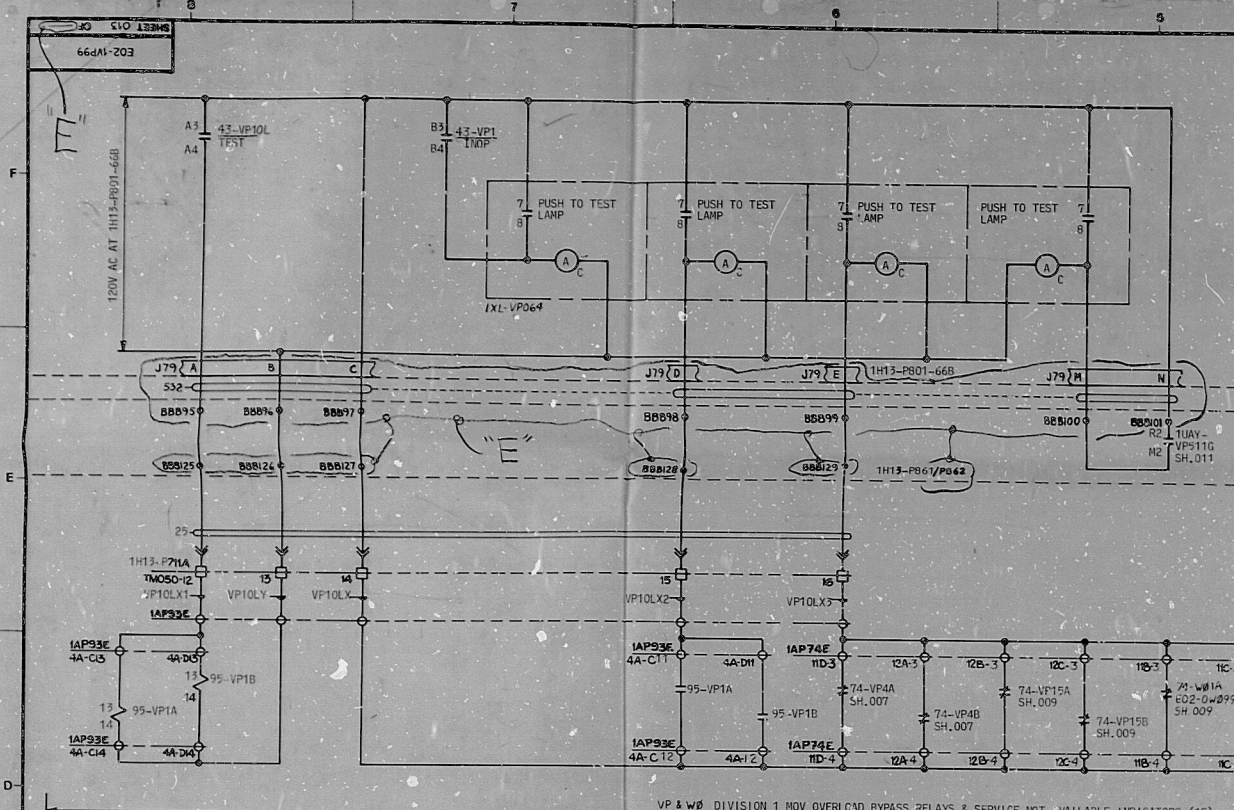

NORMAL	TEST	CONTACTS AND LOCATION (HANDLE END)		DECK	POSITION	
		FRONT	BACK		NORMAL	TEST
		A1	A2	A	X	
		A3	A4			X
		B1	B2	B	X	
		B3	B4			X

X-DENOTES CONTACT CLOSED
MAINTAINED CONTACTS
C.E. TYPE C2940
DEV. 95-VP1 & 95-VP2 KEYS LOCKED
KEY REMOVABLE IN NORM. POSITION

CONTROL SWITCH DEVELOPMENT FOR:

DEVICE	INSTRUMENT NO.	LOCATION
43-VP101	1HS-VF062	1H13-P801-66B
43-VP1	1HS-VF061	1H13-P801-66B
43-VP201	1HS-VF072	1H13-P801-67B
43-VP2	1HS-VF071	1H13-P801-67B

NOTE: FOR 43-VP1 CONTACTS A3-A4 SEE SH.011
FOR 43-VP2 CONTACTS A3-A4 SEE SH.012

DRAWING RELEASE RECORD										DRAWING RELEASE RECORD										LINE CODES USED: 25 & 26 FOR NOTES & REFERENCE DWGS. SEE SHEET 005	EQUIPMENT IS SHOWN ON THIS DRAWING. FOR SAFETY CLASSIFICATION SEE EQUIPMENT, VALVE, OR INSTRUMENT LISTING	
REV.	DATE	RELD.	PREPARED	REVIEWED	APPROVED	PURPOSE	FILM	REV.	DATE	RELD.	PREPARED	REVIEWED	APPROVED	PURPOSE	FILM	SCALE	SCHEMATIC DIAGRAM DRIVE/ COOLING SYSTEM (VP) HOW OVERLOAD BYPASS RELAYS & SERVICE NOT AVAILABLE INDICATORS CLINTON POWER STATION UNIT 1 ILLINOIS POWER COMPANY CLINTON, ILLINOIS	
A	8-2-77		5/11/78			FOR PCC FABRICATION ONLY, SPEC. NO. K-2801		A	8-2-77		5/11/78			FOR PCC FABRICATION ONLY, SPEC. NO. K-2801		10/17/77		10/17/77 314 INOT	
B	10-6-77		5/11/78			REVISED PER NISC 2 ENGR. COMMENTS, SPEC. NO. K-2801		B	10-6-77		5/11/78			REVISED PER NISC 2 ENGR. COMMENTS, SPEC. NO. K-2801		PROJECT NUMBER	
C	8-31-79		5/11/78			MISC. REV. FOR PNL. FAB. SPEC. K-2511		C	8-31-79		5/11/78			MISC. REV. FOR PNL. FAB. SPEC. K-2511		4556	
D	4-28-80		5/11/78			FOR MISC. REV. & CONST. SPEC. NO. K-2999		D	4-28-80		5/11/78			FOR MISC. REV. & CONST. SPEC. NO. K-2999	
E	2-29-81		5/11/78			NISC. REV. FOR CONSTRUCTION, SPEC. K-2999		E	2-29-81		5/11/78			NISC. REV. FOR CONSTRUCTION, SPEC. K-2999	
8										7										6										5										4										3										2										1									
B										7										6										5										4										3										2										1									
B										7										6										5	

SCALE: NONE
PROJECT NUMBER: 4356

13767
13768
SCHEMATIC DIAGRAM
DRIVE/COOLING SYSTEM (VP)
MOV OVERLOAD BYPASS RELAYS &
SERVICE NOT AVAILABLE INDICATORS
CLINTON POWER STATION UNIT 1
ILLINOIS POWER COMPANY
CLINTON, ILLINOIS

SARGENT & LUNDY
ENGINEERS
CHICAGO

DRAWING NO. REV
E02-VP99
SHEET 013 OF 013

R1AS

8107140300

