


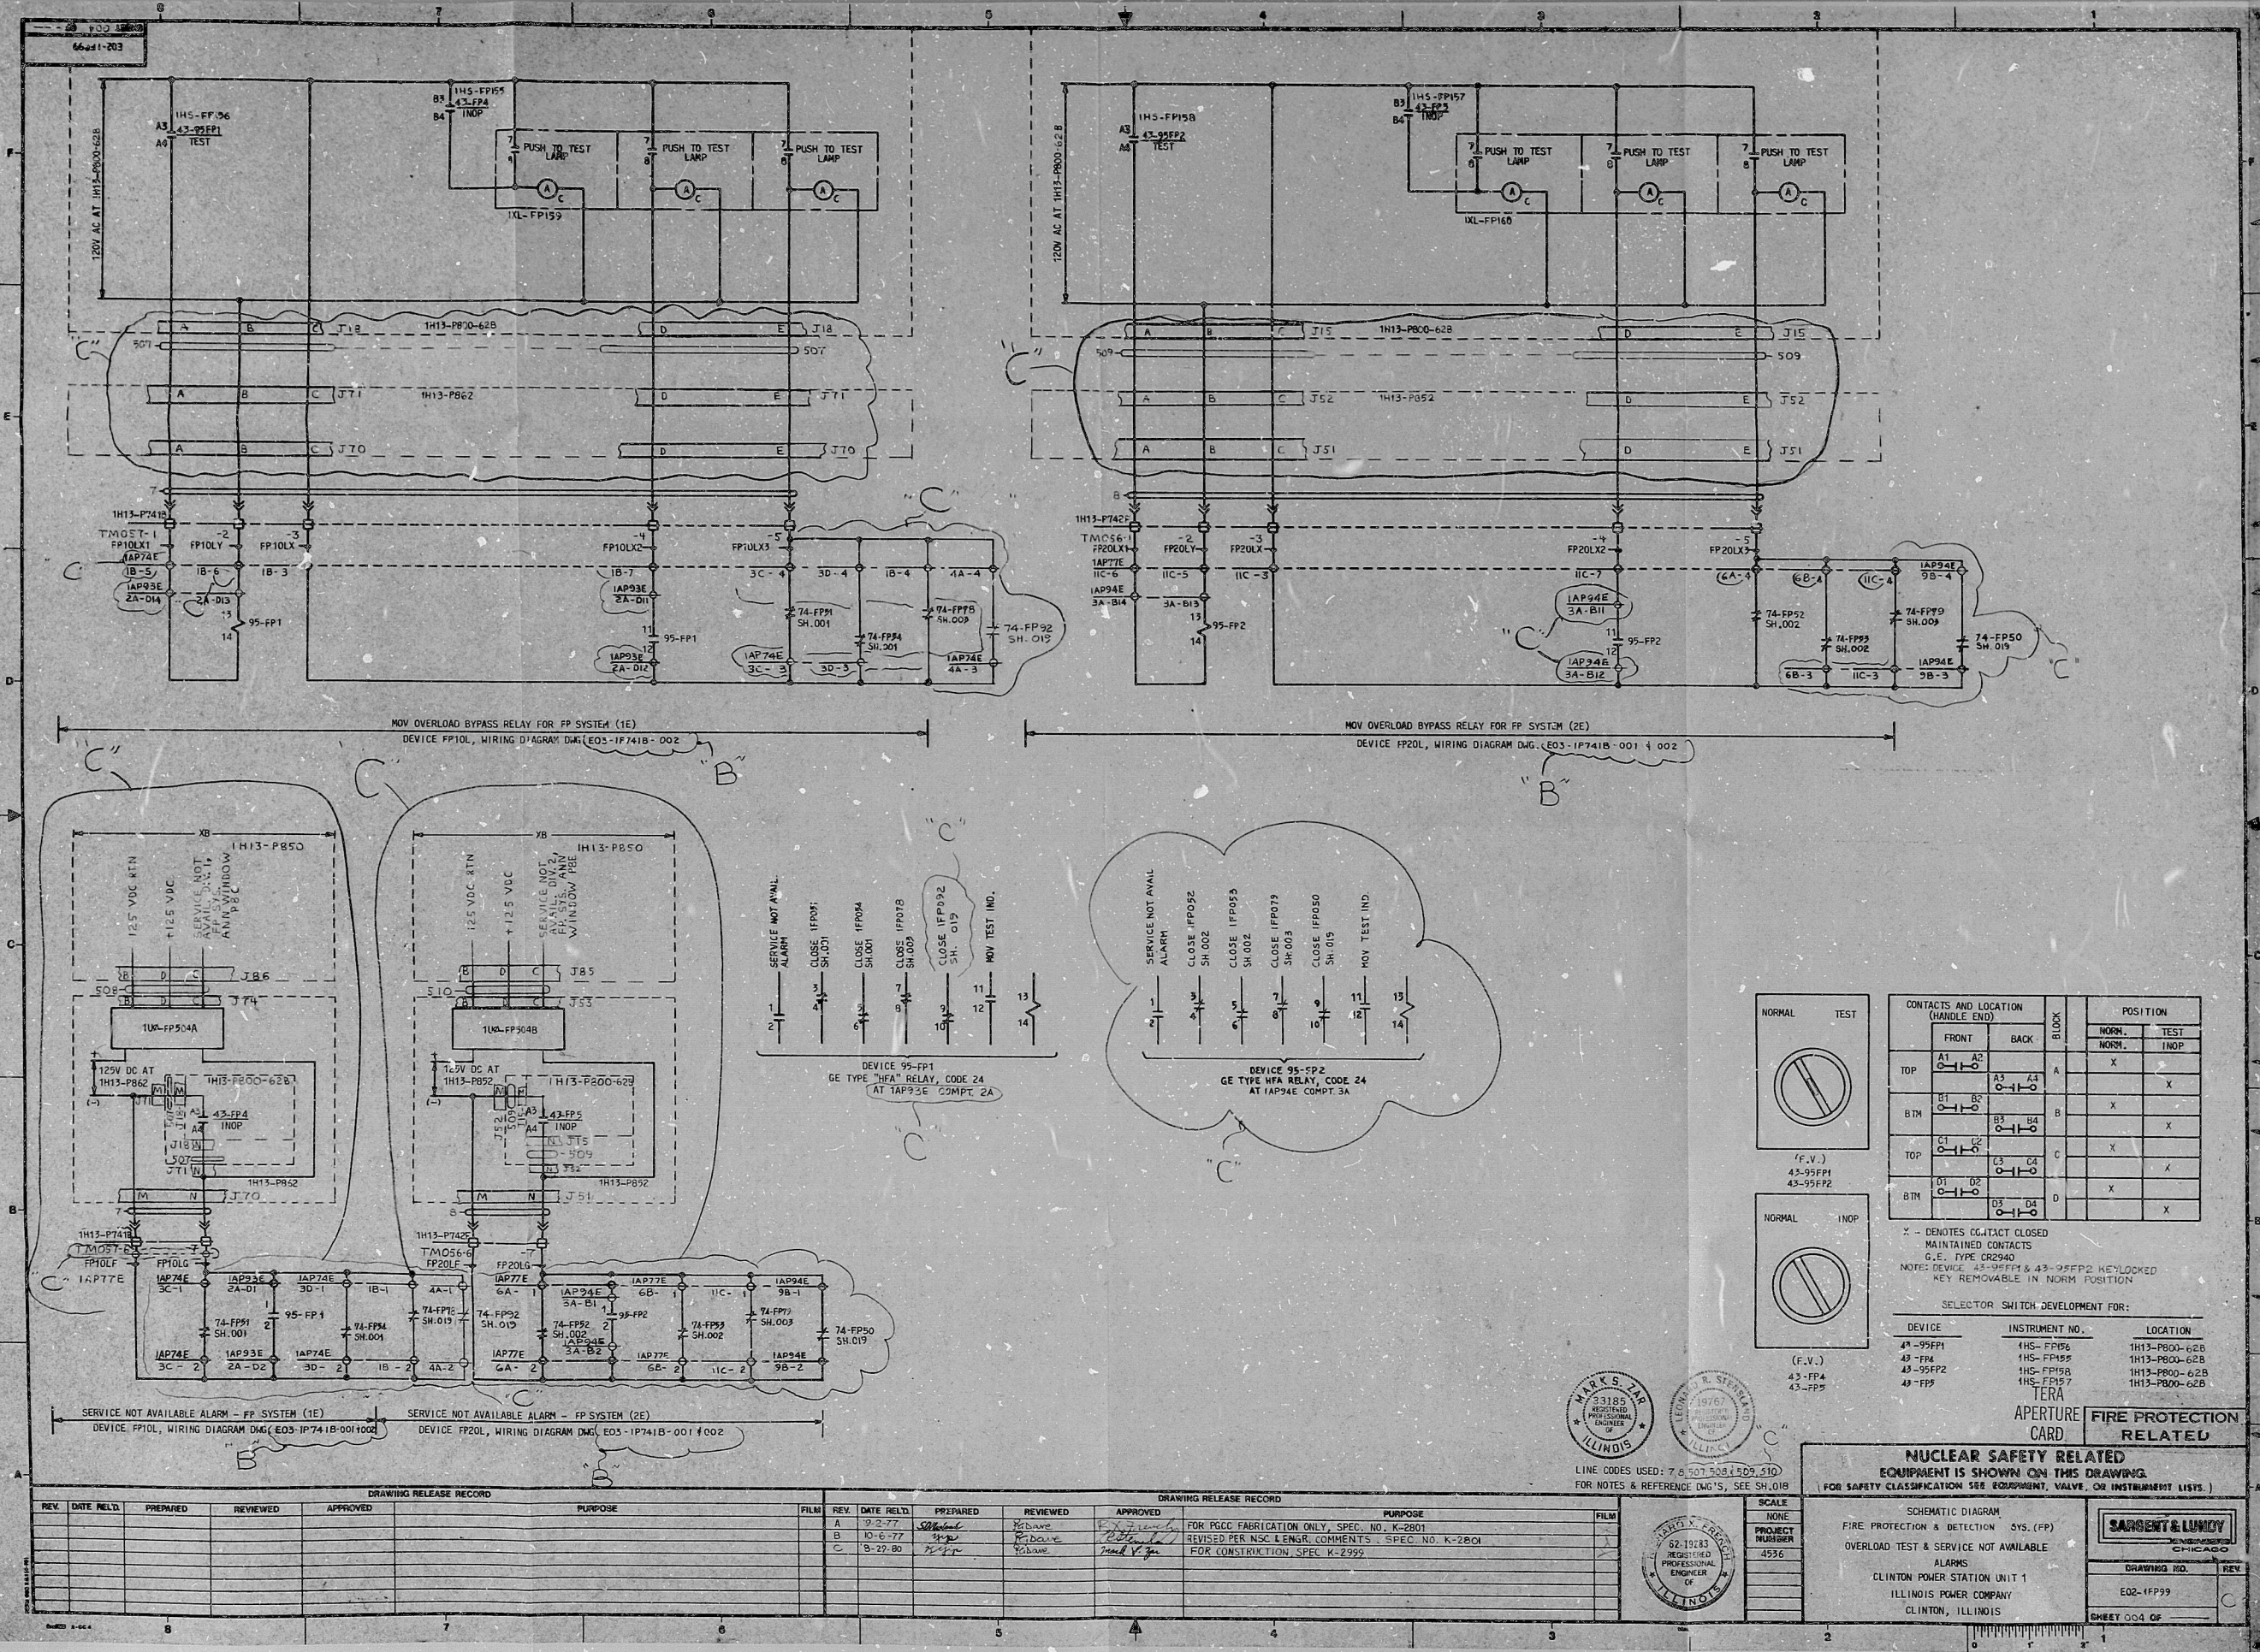

| CONTACTS AND LOCATION (HANDLE END) | BLOCK | POSITION |      |
|------------------------------------|-------|----------|------|
|                                    |       | NORM.    | TEST |
| TOP A1 A2                          | A     | X        |      |

X - DENOTES CONTACT CLOSED  
MAINTAINED CONTACTS  
G.E. TYPE CR2940  
NOTES: DEVICE 43-95FP1 & 43-95FP2 KEY-LOCKED  
KEY REMOVABLE IN NORM POSITION

SELECTOR SWITCH DEVELOPMENT FOR:


| DEVICE   | INSTRUMENT NO. | LOCATION      |
|----------|----------------|---------------|

TERA  
APERTURE  
CARD  
FIRE PROTECTION  
RELATED

NUCLEAR SAFETY RELATED  
EQUIPMENT IS SHOWN ON THIS DRAWING.  
(FOR SAFETY CLASSIFICATION SEE EQUIPMENT, VALVE, OR INSTRUMENT LISTS.)

|   |                                                                                   |
|---|-----------------------------------------------------------------------------------|
| SCHEMATIC DIAGRAM<br>FIRE PROTECTION & DETECTION SYS. (FP)<br>OVERLOAD TEST & SERVICE NOT AVAILABLE<br>ALARMS<br>CLINTON POWER STATION UNIT 1<br>ILLINOIS POWER COMPANY<br>CLINTON, ILLINOIS | <b>SARGENT &amp; LUNDY</b><br>CHICAGO<br>DRAWING NO. E02-1FP99<br>SHEET 004 OF 01 |
|---|-----------------------------------------------------------------------------------|

| DRAWING RELEASE RECORD |         |       |          |          |          | DRAWING RELEASE RECORD                           |      |      |         |       |          |
|------------------------|---------|-------|----------|----------|----------|--------------------------------------------------|------|------|---------|-------|----------|
| REV.                   | DATE    | RELD. | PREPARED | REVIEWED | APPROVED | PURPOSE                                          | FILM | REV. | DATE    | RELD. | PREPARED |

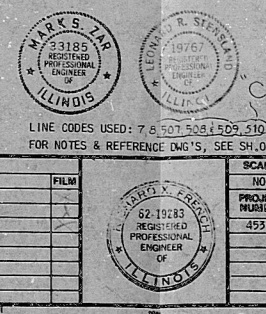



RIDS

8107140401

