




RIDS

8212230214

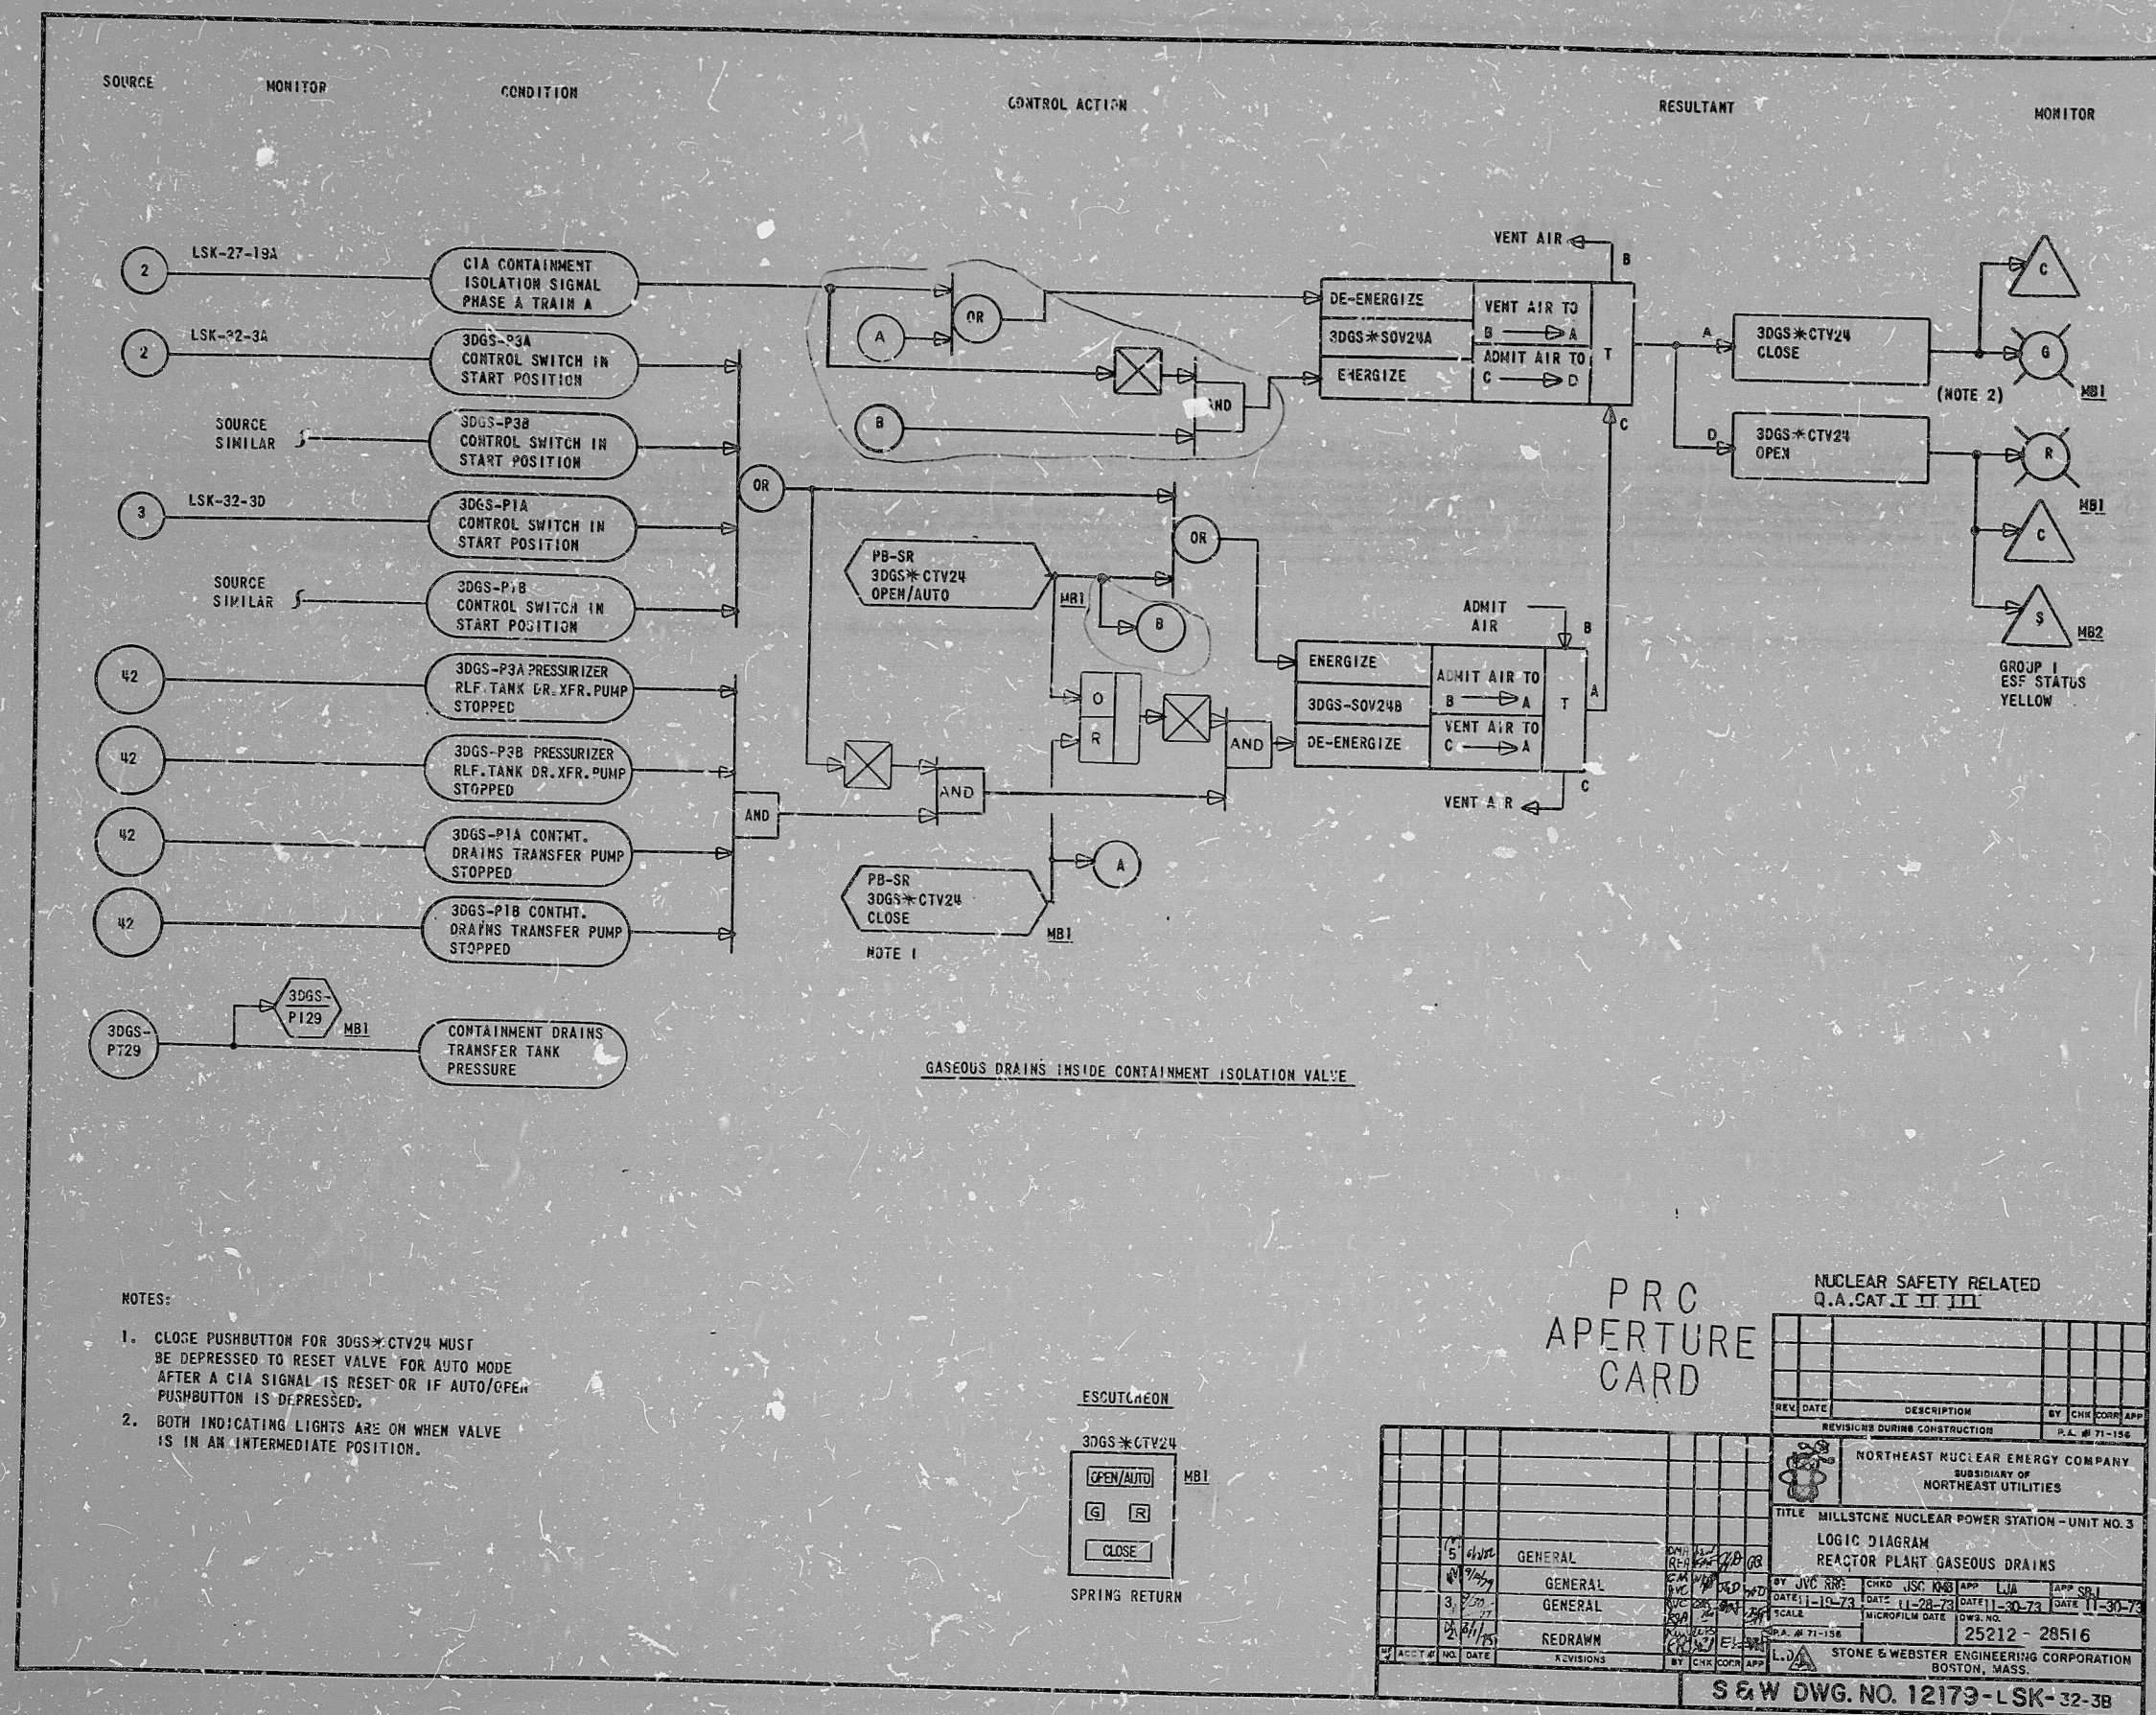