


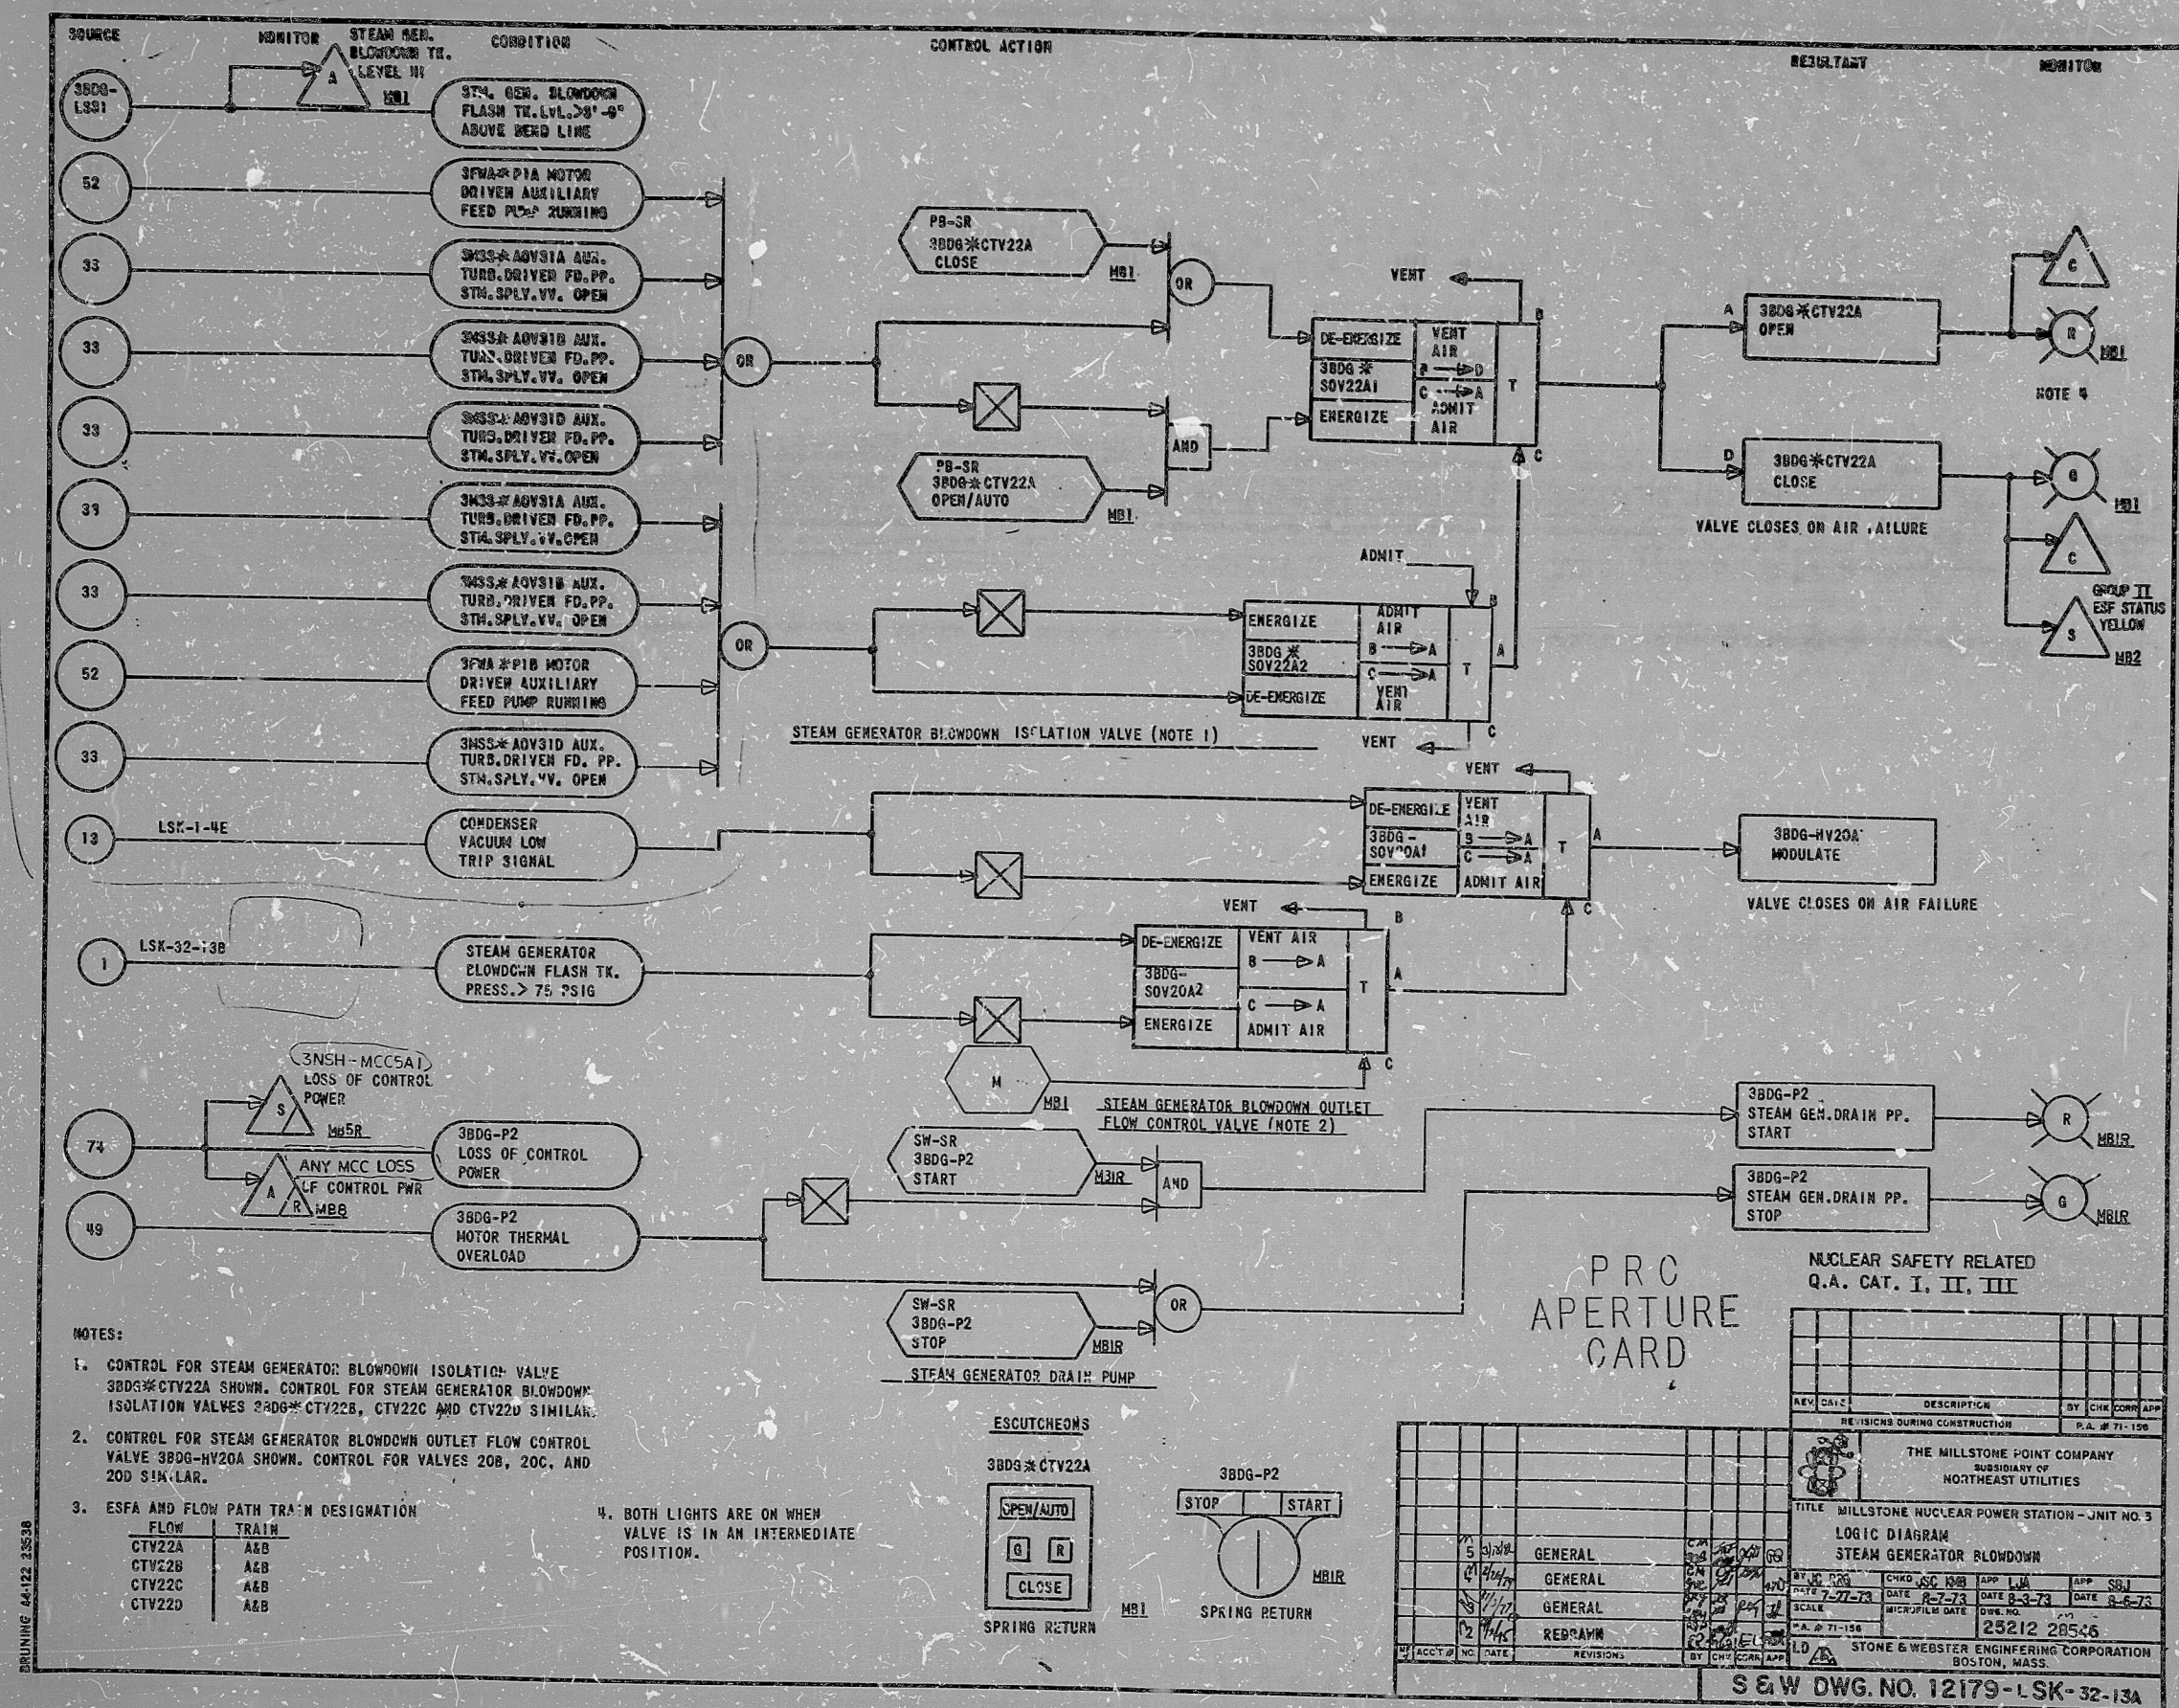



RIDS

8212230242

