


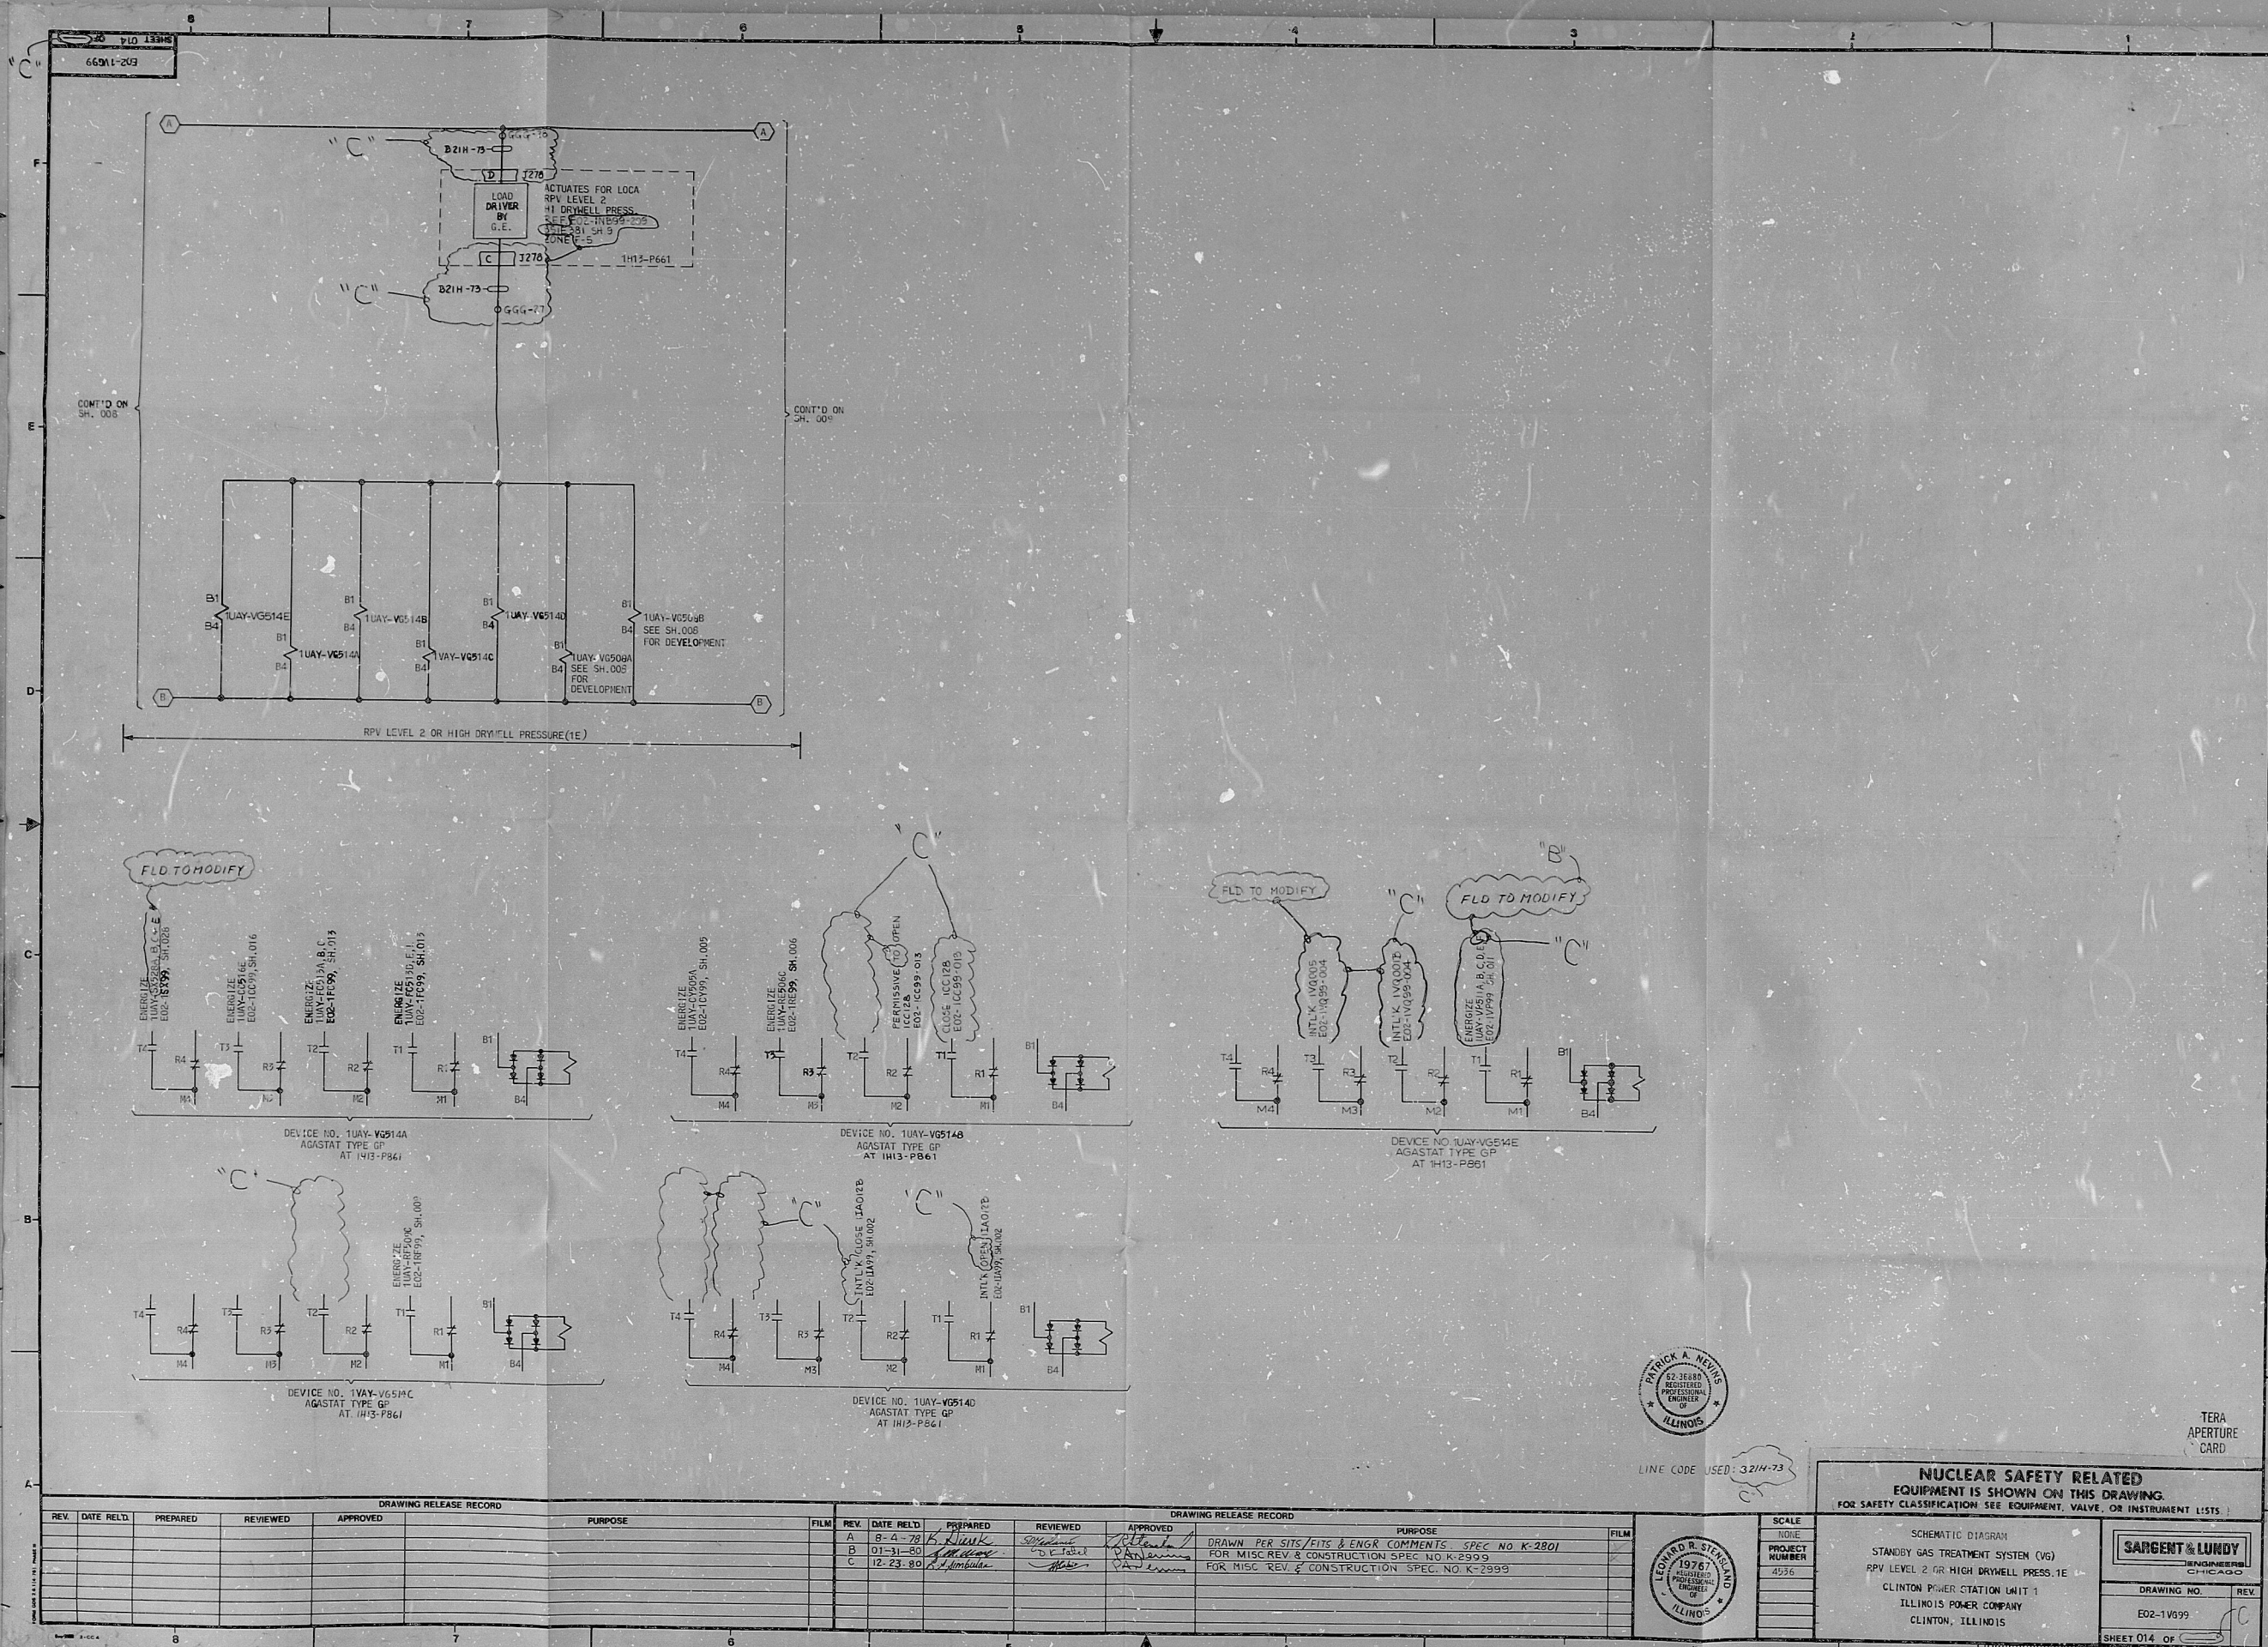

RIDS

8107140910

