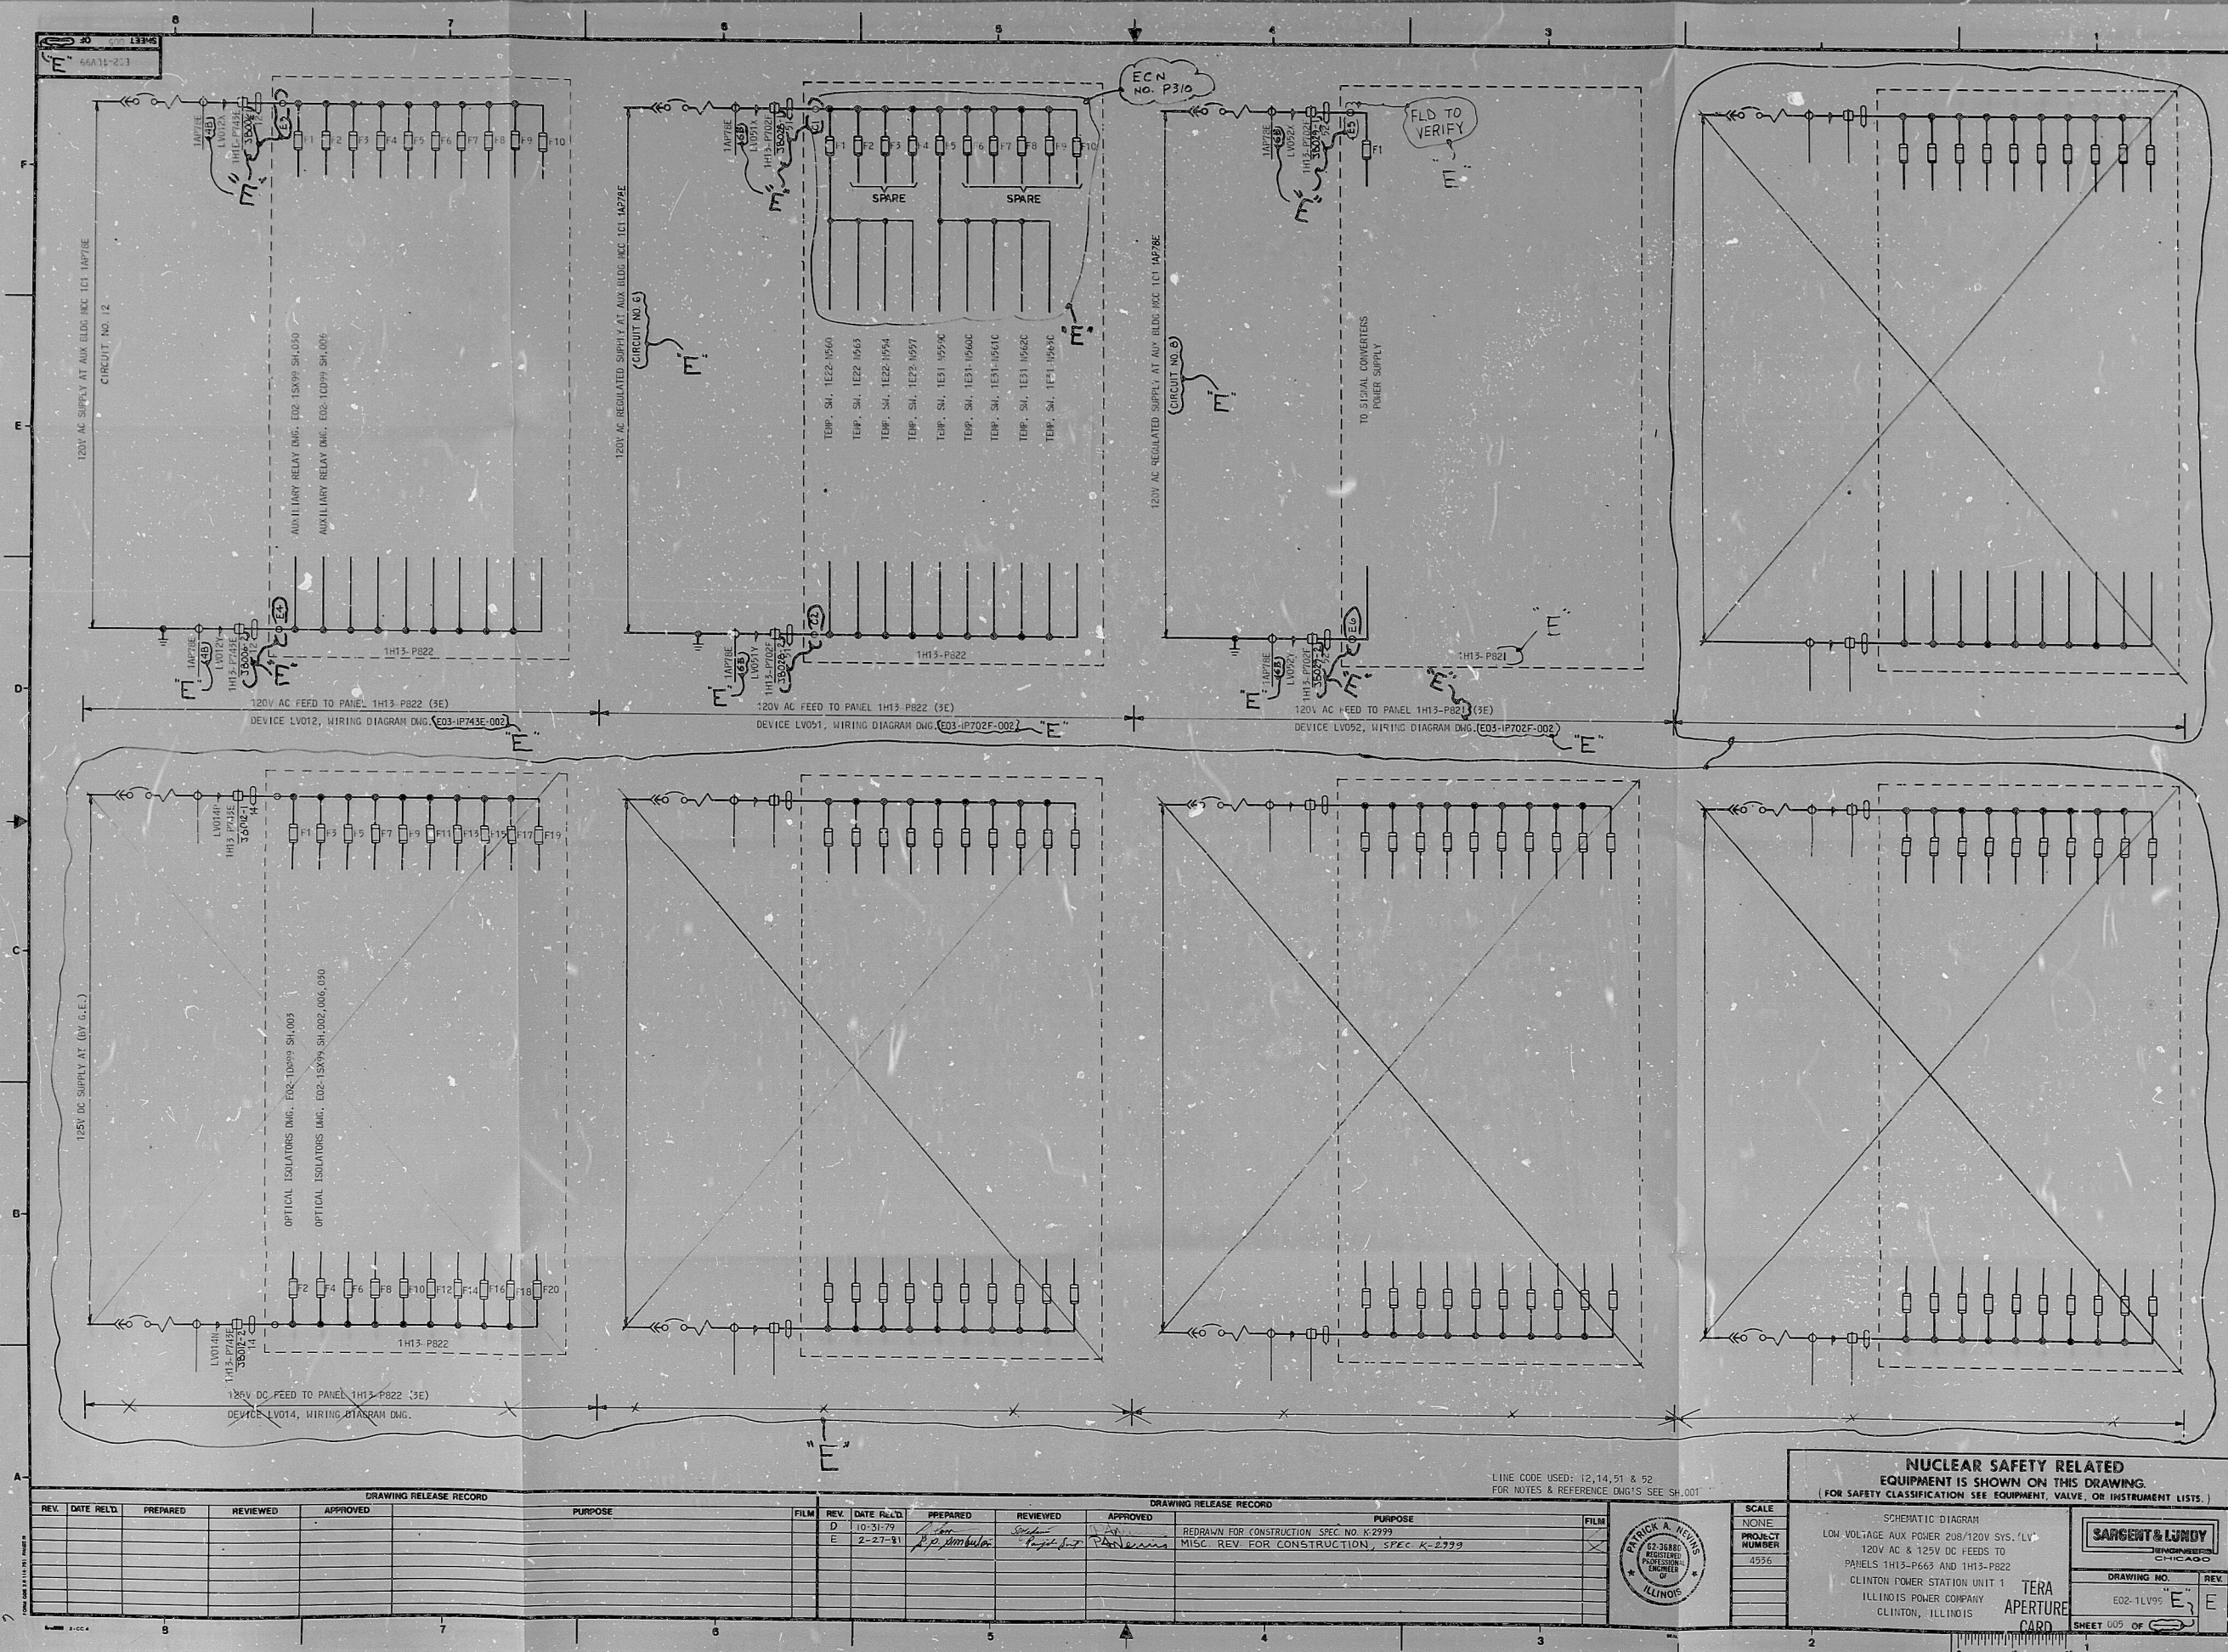


[illegible][illegible][illegible][illegible]

A circular professional engineer seal for Patrick A. Nevins, Registered Professional Engineer, State of Illinois. The seal includes the license number 62-36880 and the text "ILLINOIS" at the bottom. To the left of the seal, the word "FILM" is printed vertically.

LINE CODE USED: 12, 14, 51 & 52
FOR NOTES & REFERENCE DWG'S SEE SH.001

NUCLEAR SAFETY RELATED
EQUIPMENT IS SHOWN ON THIS DRAWING.

SCHEMATIC DIAGRAM

LOW VOLTAGE AUX POWER 208/120V SYS. 'LV'

120V AC & 125V DC FEEDS TO

PANELS 1H13-P663 AND 1H13-P822

CLINTON POWER STATION UNIT 1

ILLINOIS POWER COMPANY

CLINTON, ILLINOIS

TERA
APERTU

The logo for SARGENT & LUNDY ENGINEERS CHICAGO is enclosed in a rectangular border. Below the logo is a drawing title block with two columns. The left column is headed "DRAWING NO." and contains the text "E02-1LV99". The right column is headed "REV." and contains a handwritten "E" in the first row and a printed "E" in the second row.

DRAWING NO.	REV.
E02-1LV99 "E"	E

RIDS

810740919

