


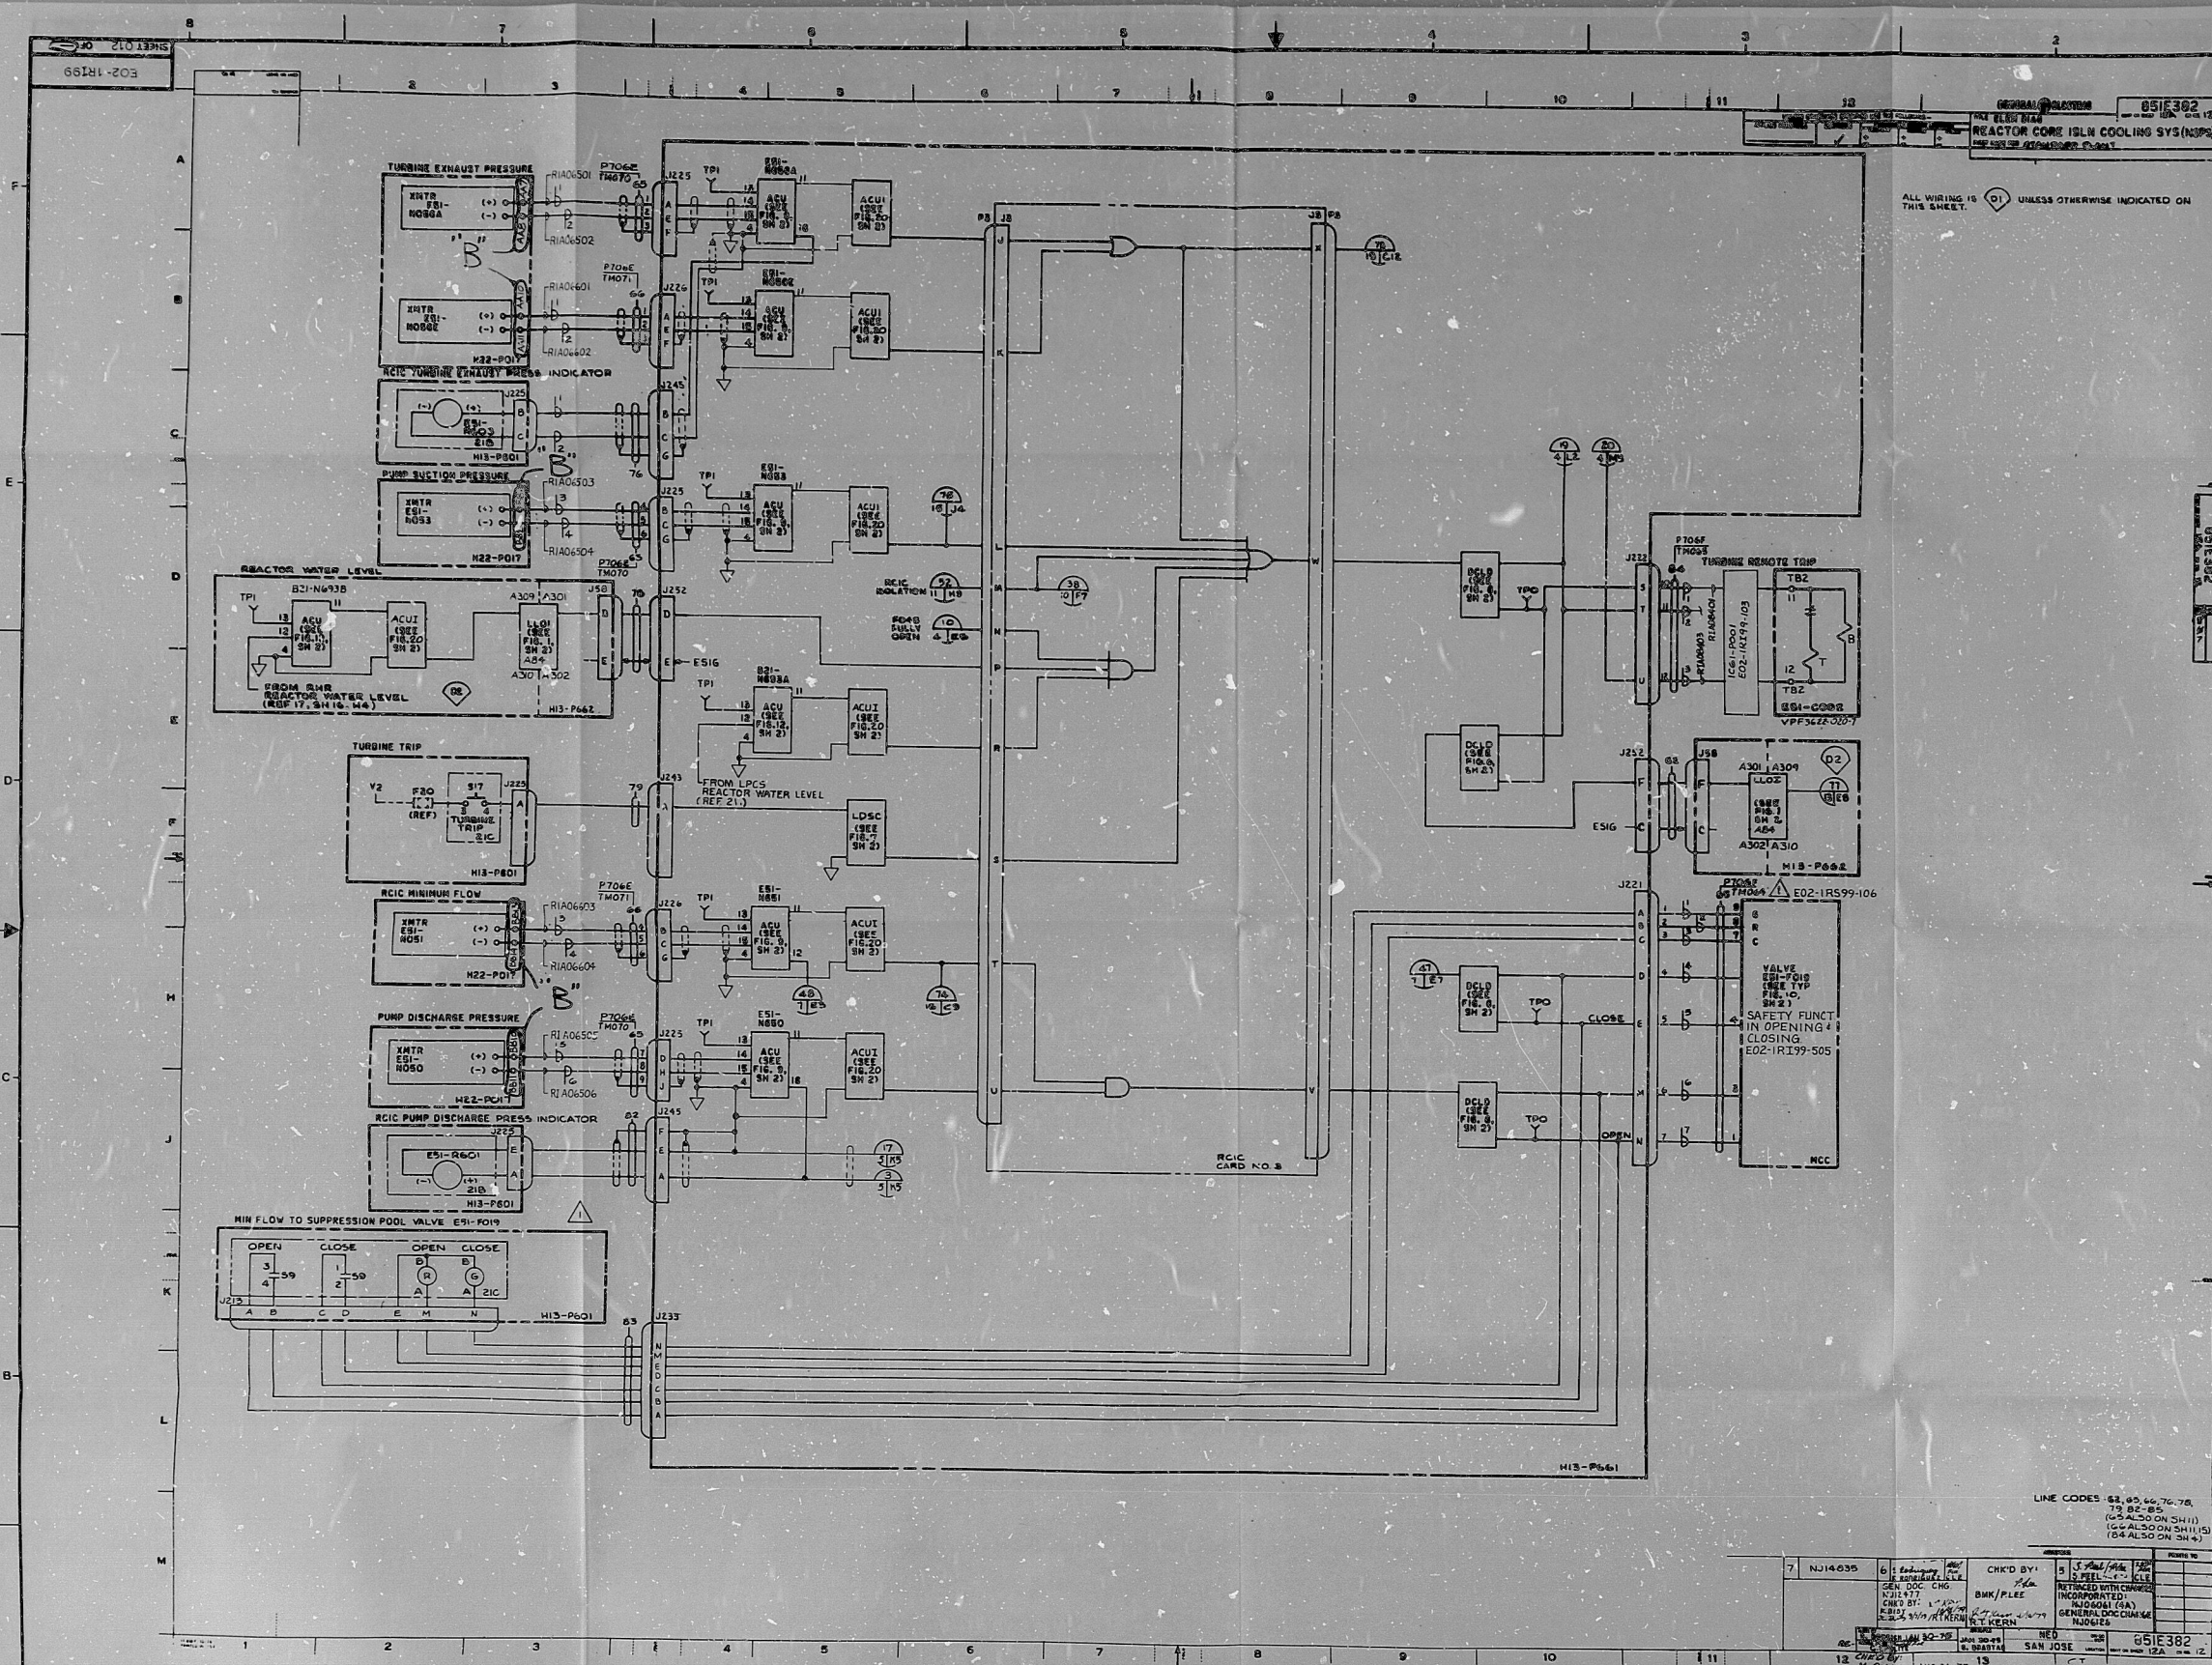

DRAWING RELEASE RECORD					DRAWING RELEASE RECORD				
REV	DATE	RELD	PREPARED	REVIEWED	APPROVED	PURPOSE	FILM	REV	DATE
A	03-31-80					RELEASED FOR CONSTRUCTION, SPEC. K-2999		A	03-31-80
B	02-18-81					REVISION FOR CONSTRUCTION, SPEC. No. K-2999		B	02-18-81

NUCLEAR SAFETY RELATED
EQUIPMENT SHOWN ON THIS DRAWING
(FOR SAFETY CLASSIFICATION SEE COMMENTS, VALVE OR INSTRUMENT LIST)

TEMA
APERTURE
CARD

SARGENT & LUNDY
ENGINEERS
CHICAGO

DRAWING NO. REV.
E02-1R199 B
SHEET 012 OF 012

RIDS

810759193

