


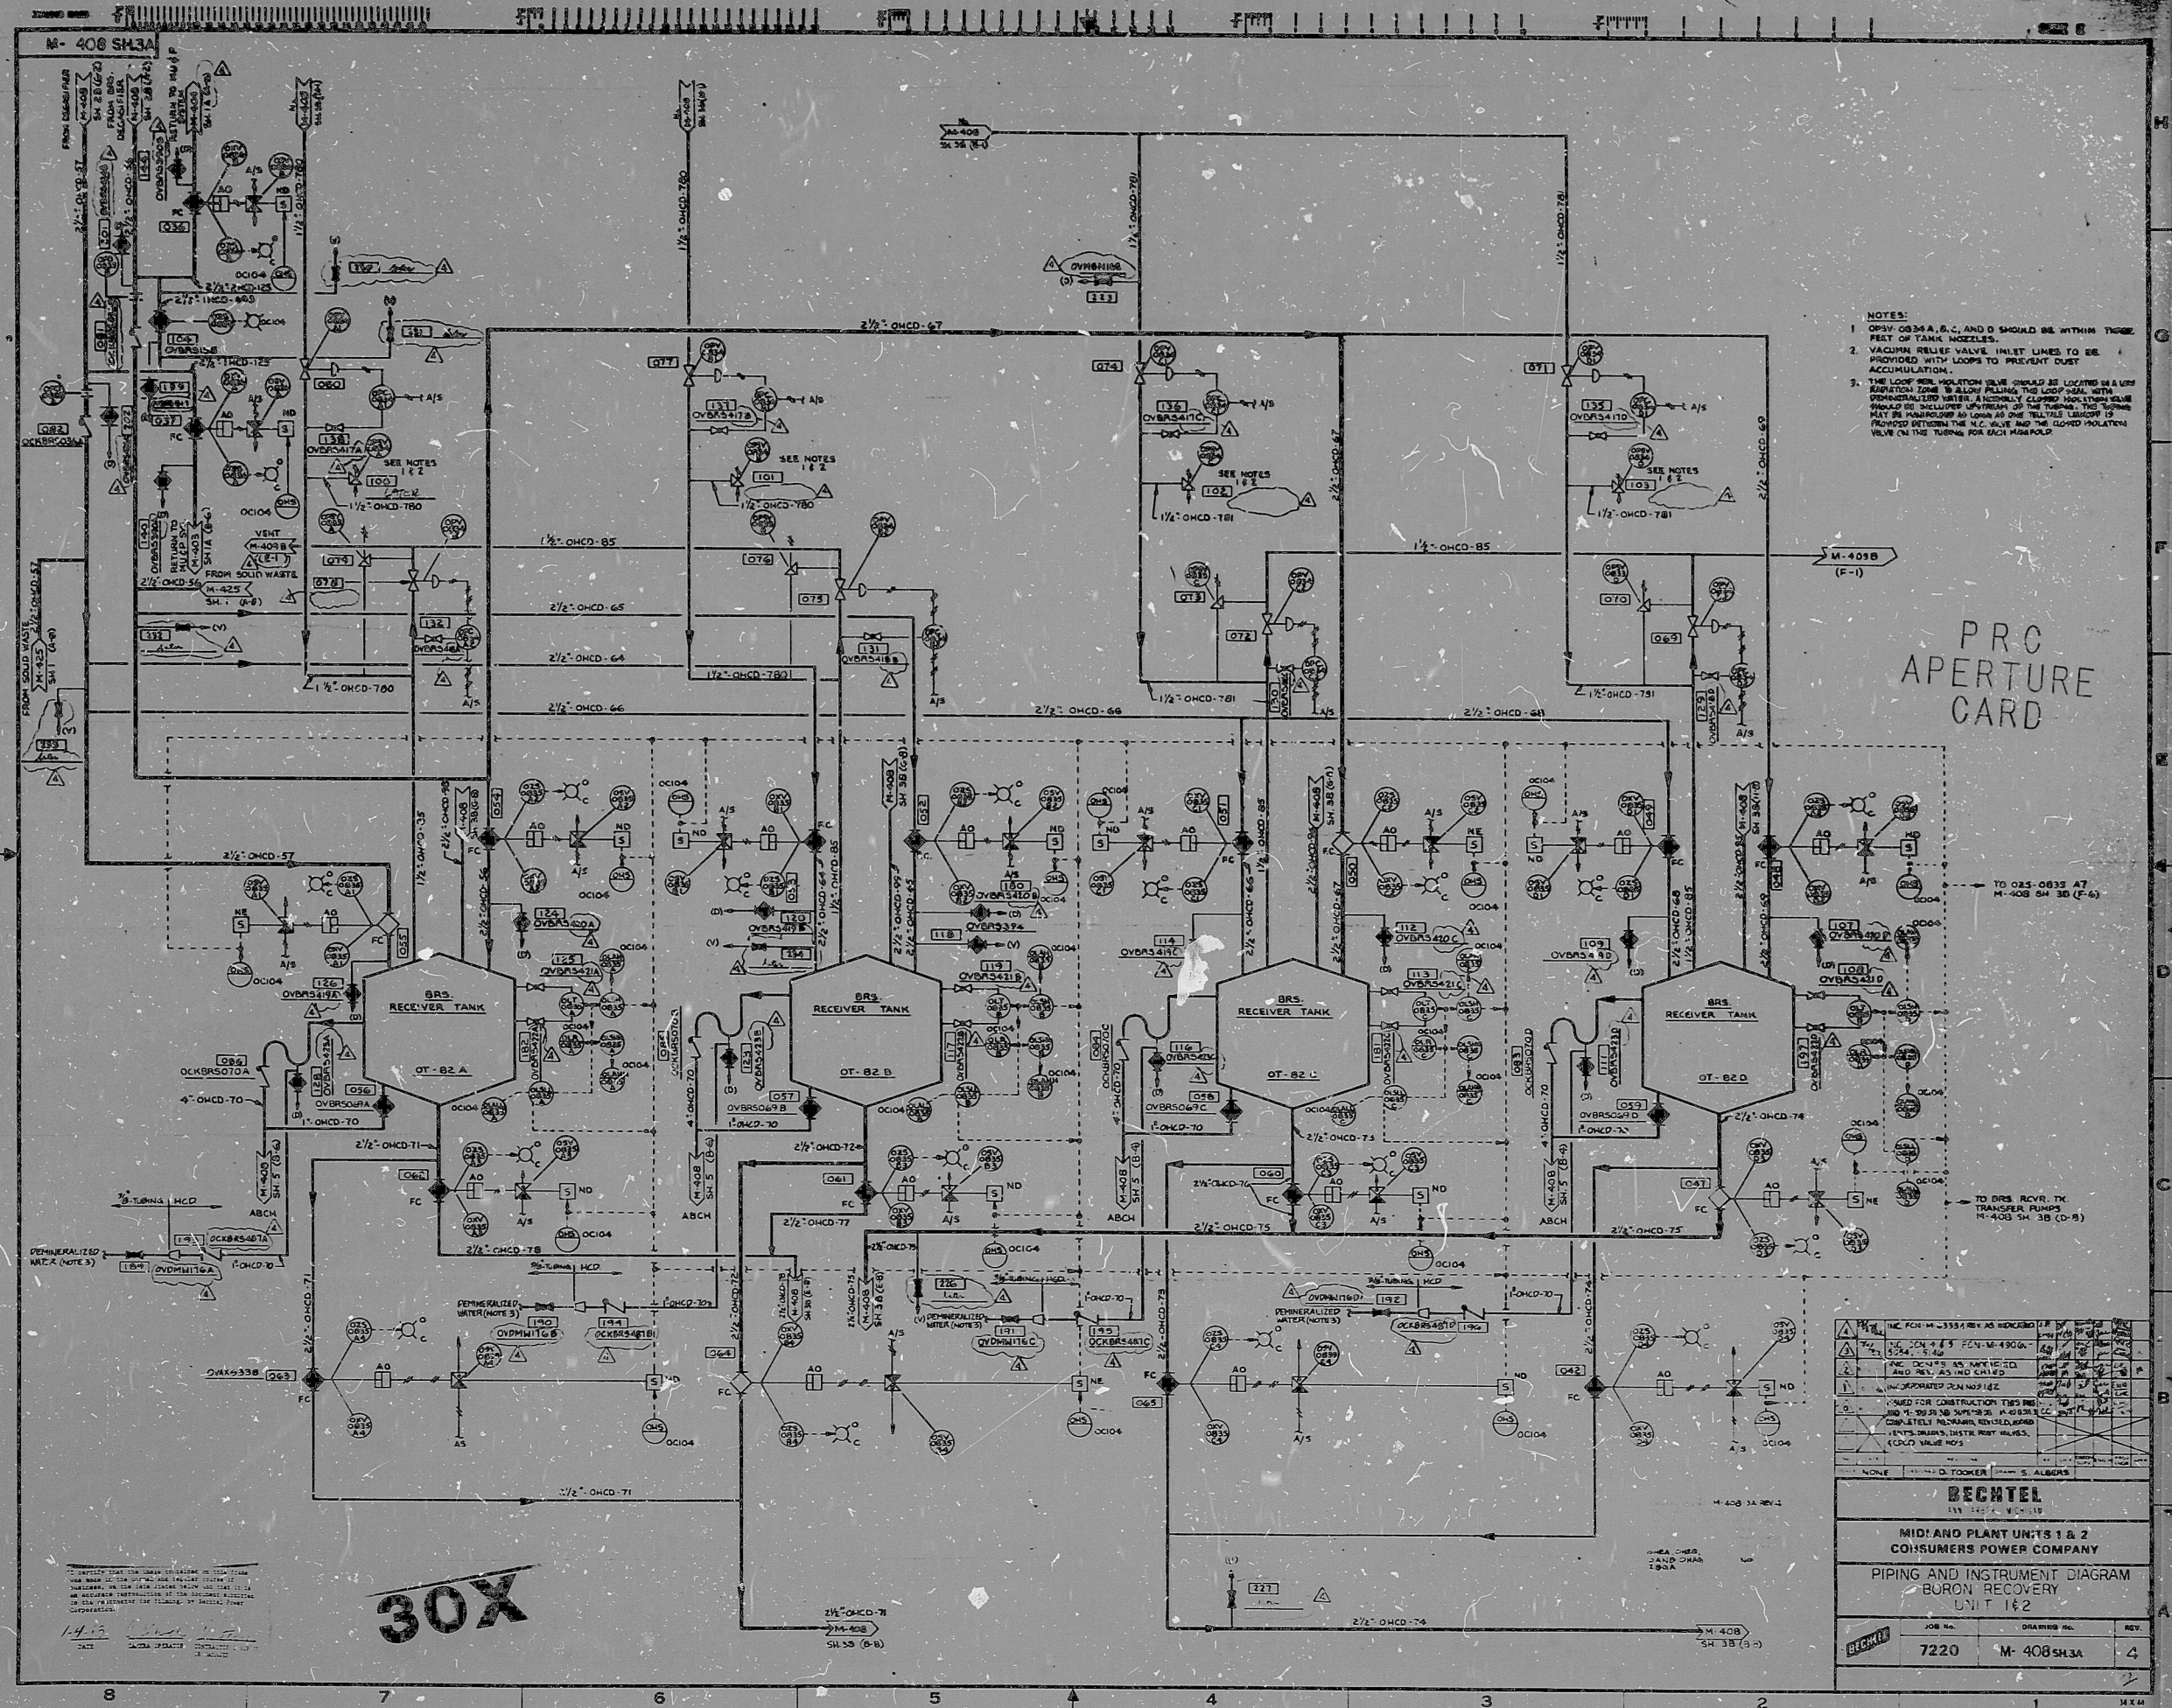



PDR RIDS

8312150390

