


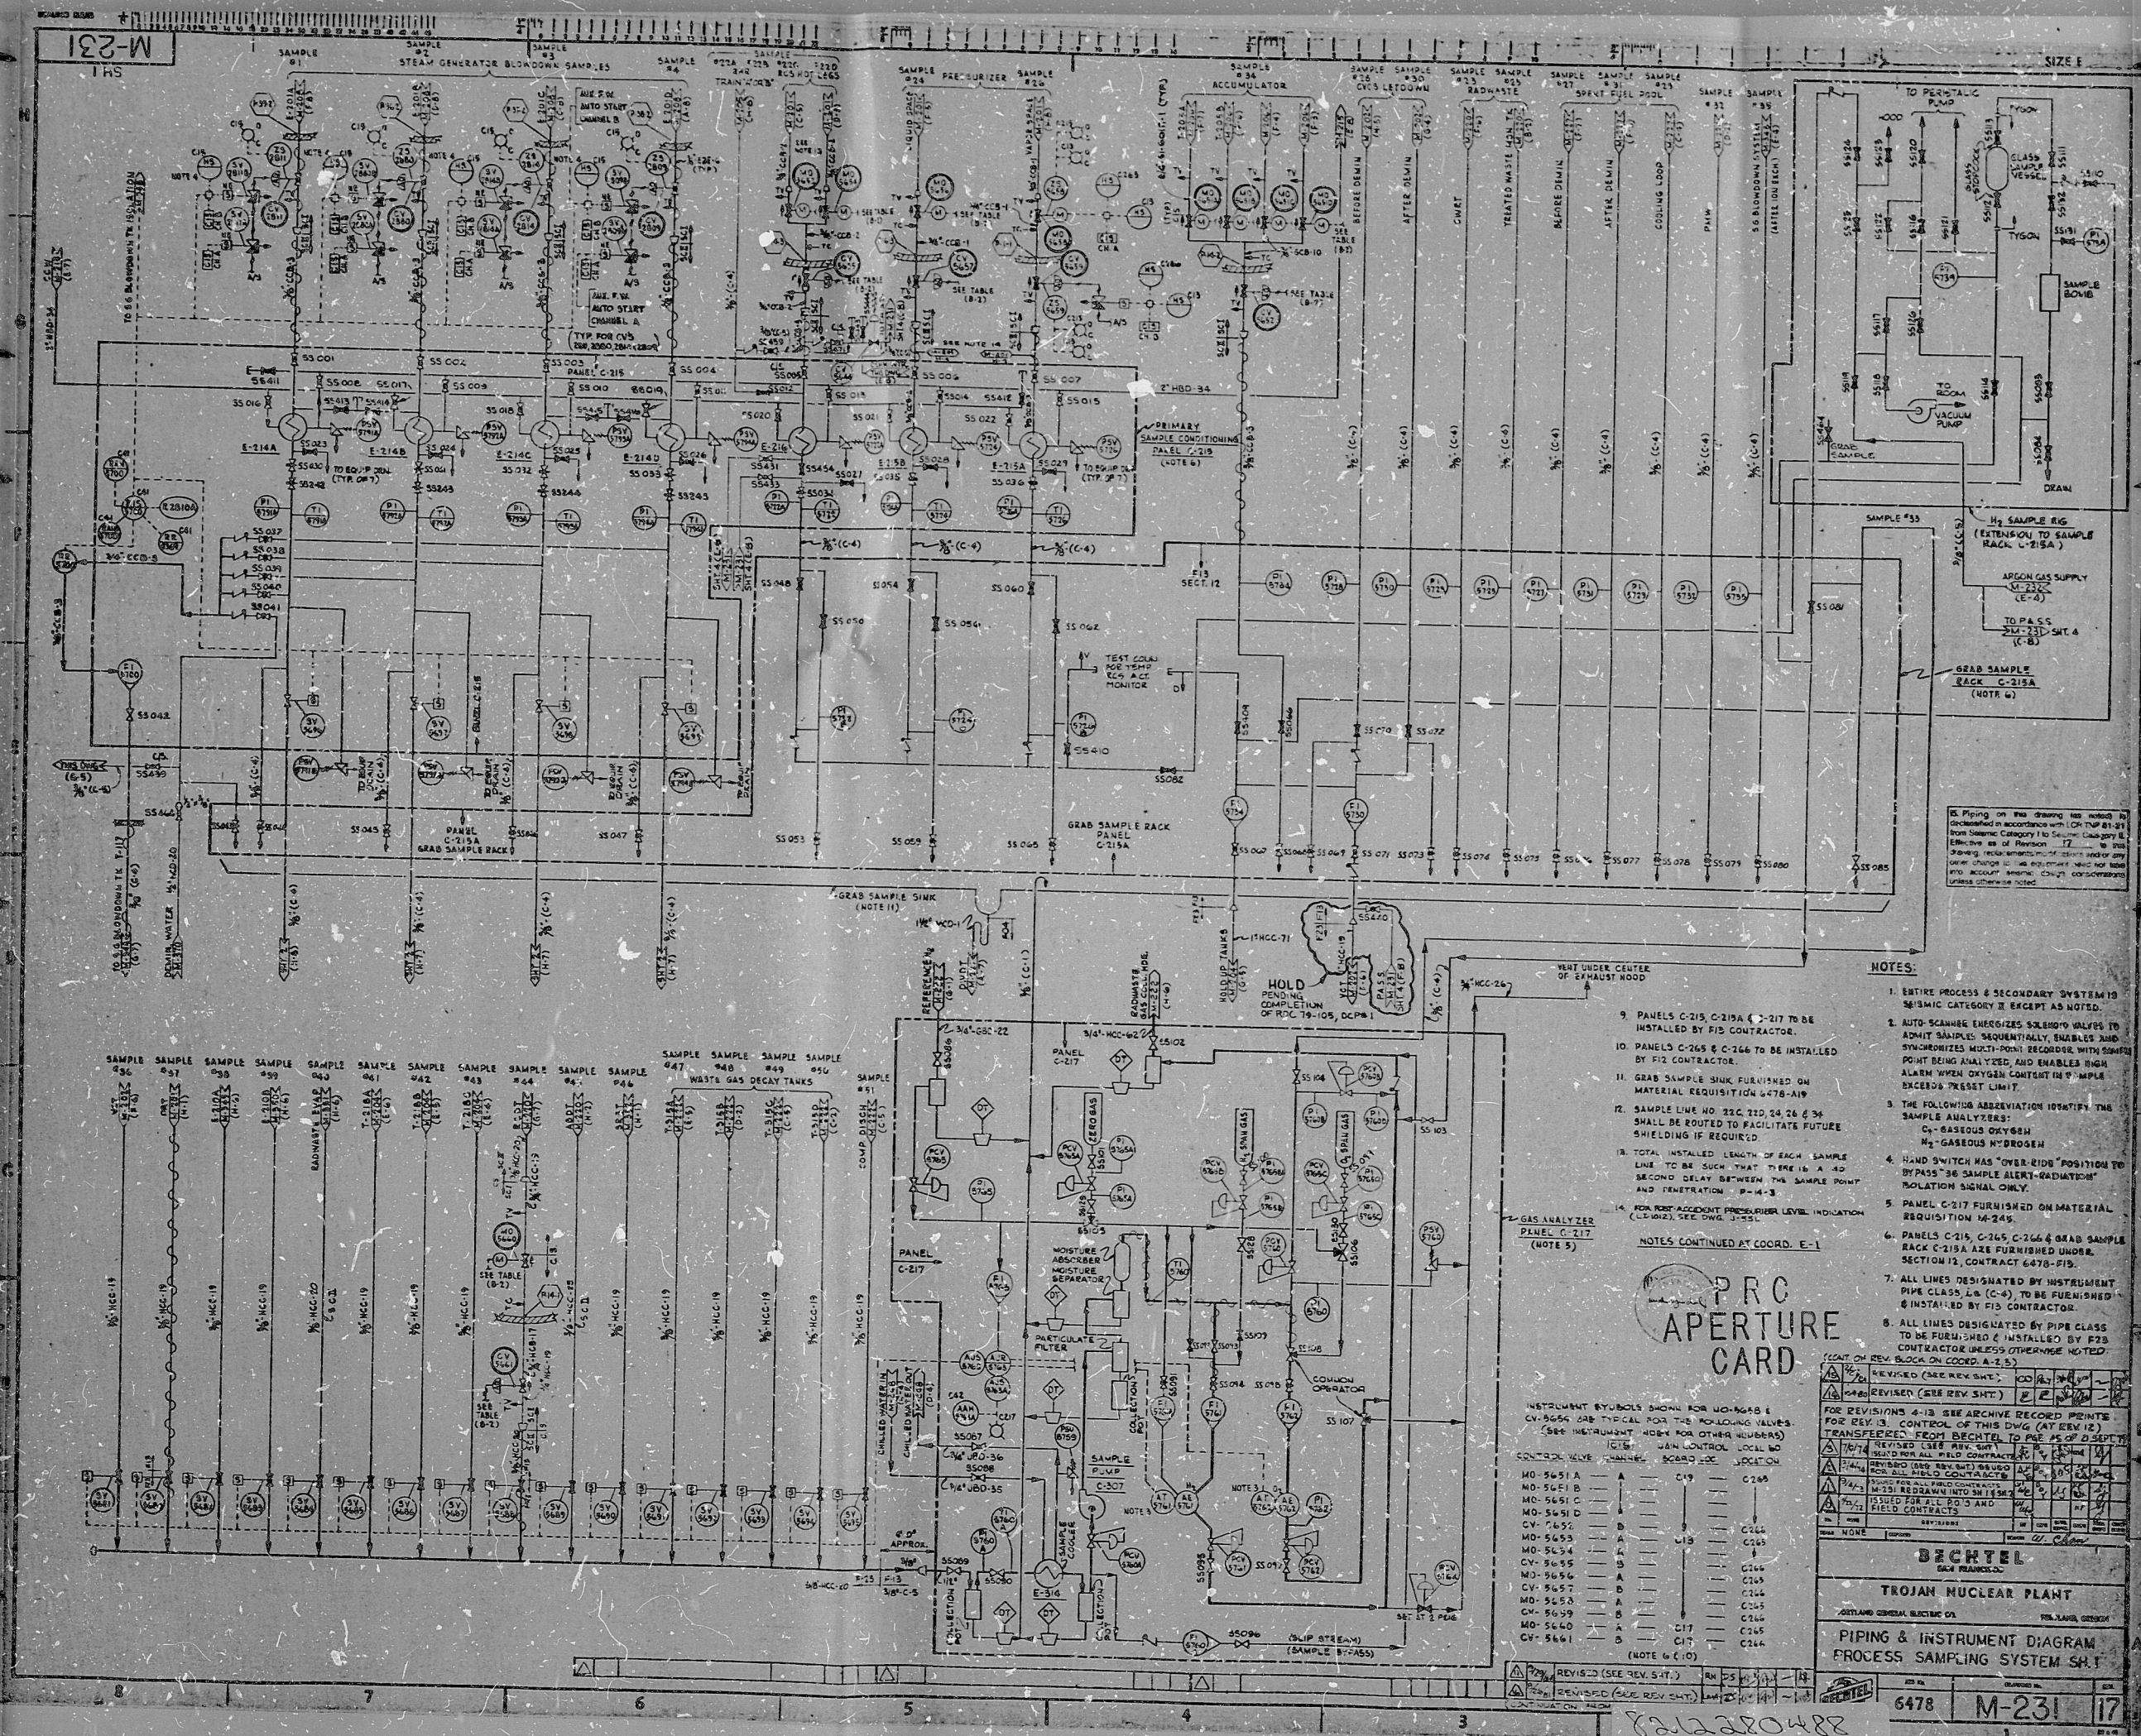

PRC
APERTURE
CARD

1. ENTIRE PROCESS & SECONDARY SYSTEM IS SEMI-MIC CATEGORY II EXCEPT AS NOTED.
3. THE FOLLOWING ABBREVIATION IDENTIFY THE SAMPLE ANALYZERS:
C- GASIOUS OXYGEN
M- GASIOUS HYDROGEN
4. HAND SWITCH HAS "OVER-RID" POSITION TO BYPASS "56 SAMPLE ALERT-REDUCTION" ISOLATION SIGNAL ONLY.
5. PANEL C-217 FURNISHED ON MATERIAL REQUISITION M-245.
6. PANELS C-215, C-245, C-266 & BRAD SAMPLE RACK C-215A ARE FURNISHED UNDER SECTION 12, CONTRACT 6478-215.
7. ALL LINES DESIGNATED BY INSTRUMENT PIPE CLASS L6 (C-6) TO BE FURNISHED & INSTALLED BY F13 CONTRACTOR.
8. ALL LINES DESIGNATED BY PIPE CLASS TO BE FURNISHED & INSTALLED BY F23 CONTRACTOR UNLESS OTHERWISE NOTED.

(CONT ON REV. BLOCK ON COVER)

[illegible]

RIDS™

8212280488

