

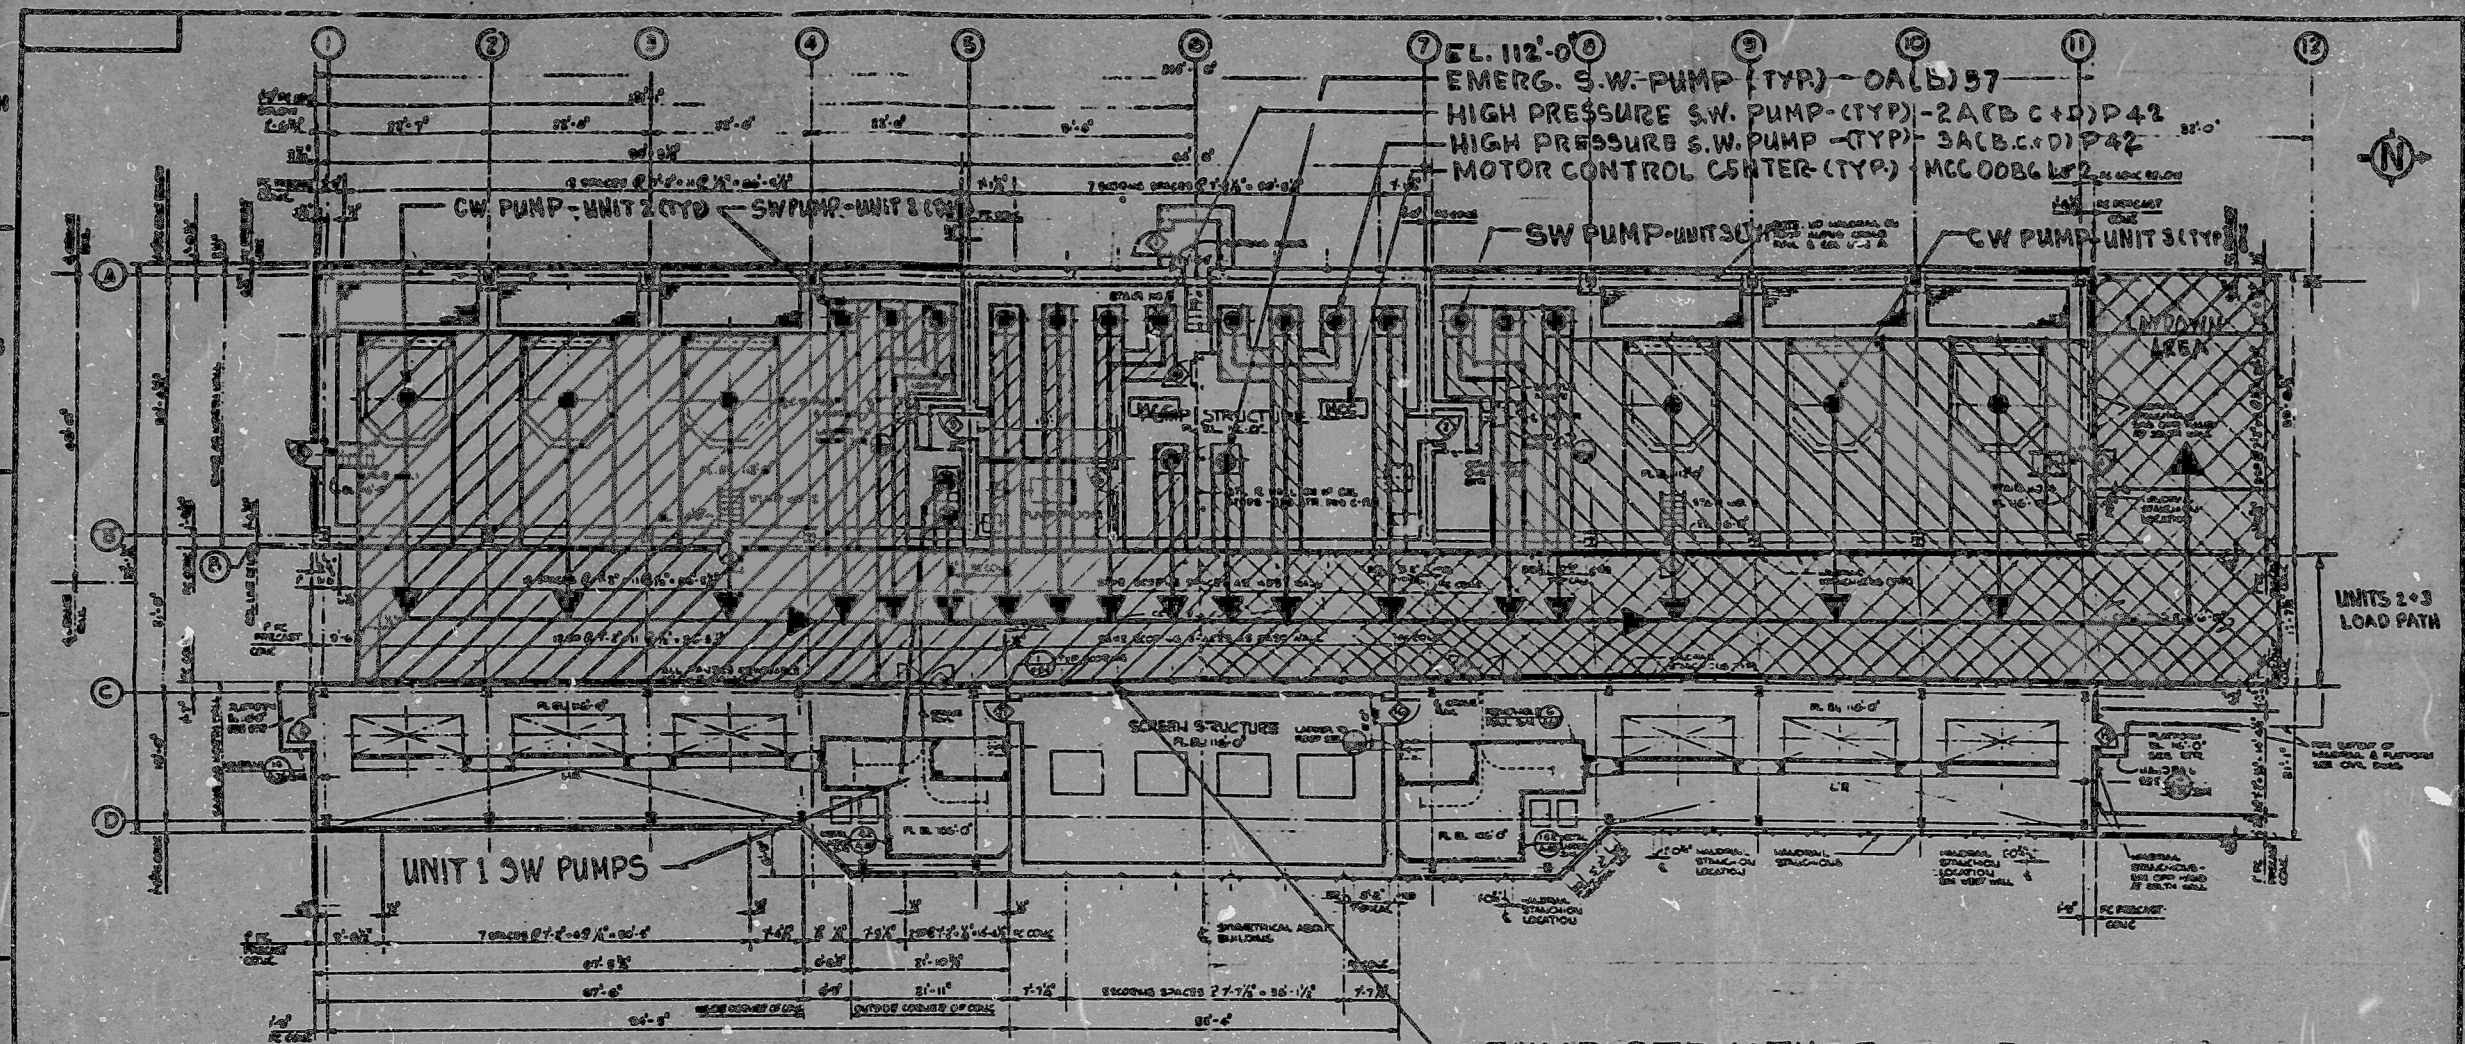
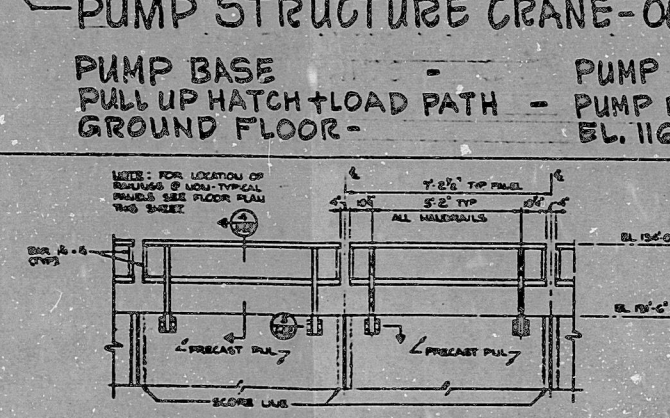
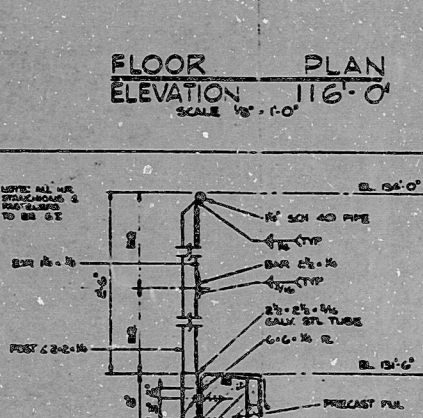


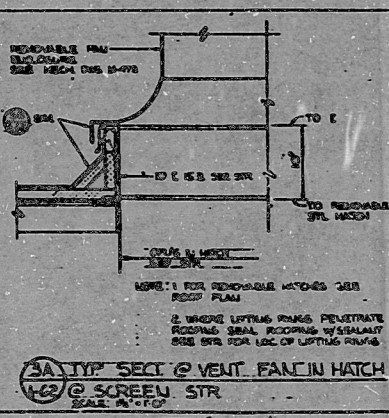





PUMP STRUCTURE CRANE-00H16 - LOAD PATH

FLOOR PLAN
ELEVATION 116'-0"

PUMP BASE
PULL UP HATCH + LOAD PATH - PUMP BLDG. FLOOR - EL. 112'-0"

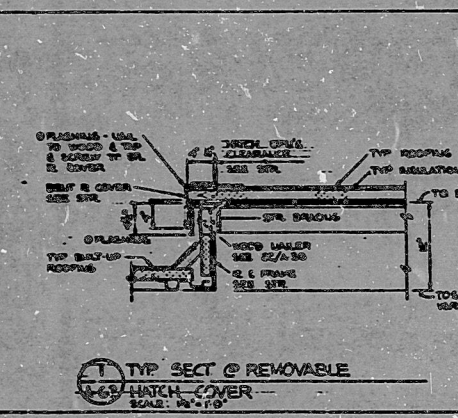

GENERAL NOTES
1. FOR LOCATION OF BUILDING ON SITE SEE SHEET C-1
2. PROVIDE TYPICAL BARS ON ALL ROOF HATCHES THAT OCCUR IN ROOFS WITH INSULATION
TERA APERTURE CARD

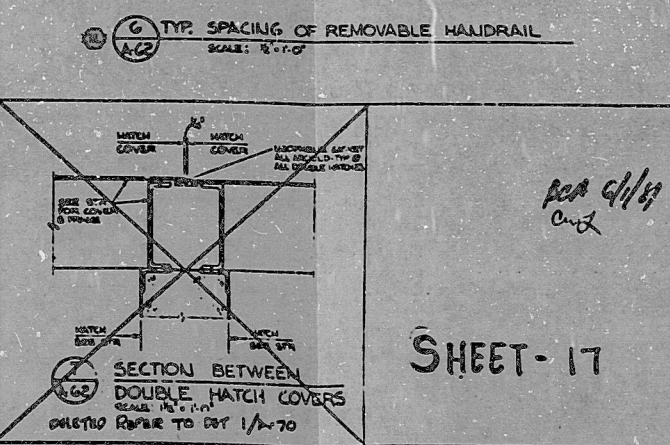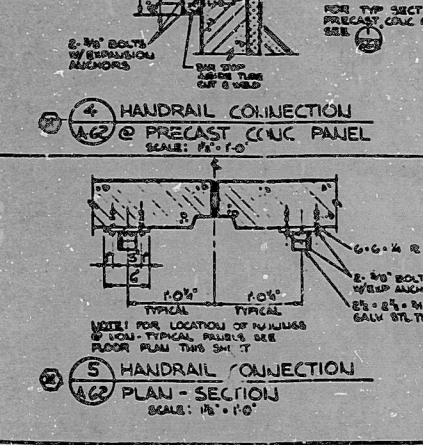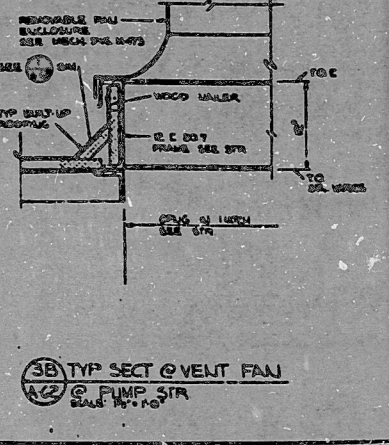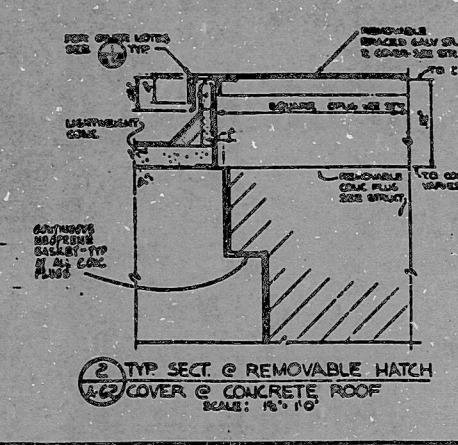

SHEET - 17	
C.W. PUMP STRUCTURE PLAN ELEV. 112'-0" & 116'-0" UNIT 3	
6280	A-62

8107160112

