



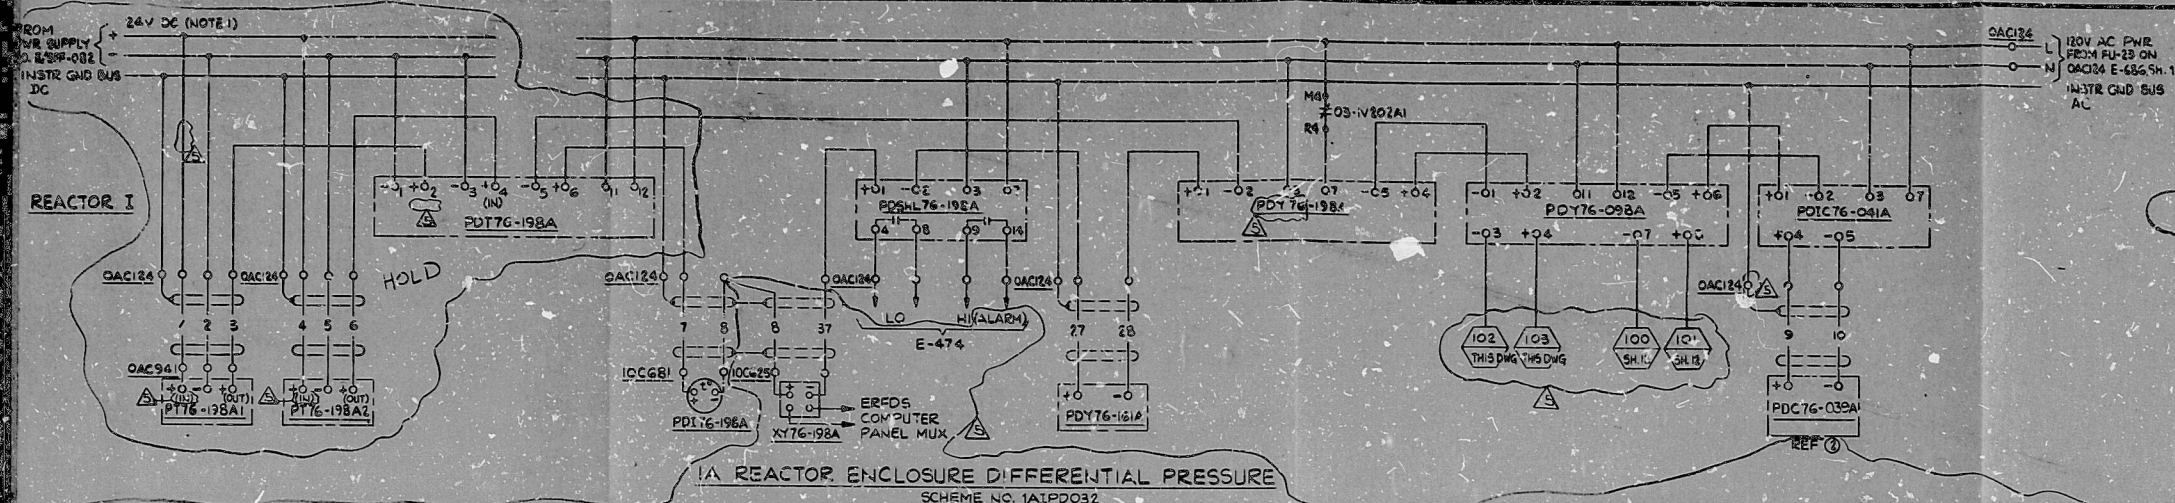

EQUIPMENT	Q NO.	SCHEME NO.	EQUARED REPARATION CHANNEL	DIFFERENTIAL PRESSURE						INDICATOR CONTROLLER	DISCRIMINATORS			
				SWITCHES	TRANSMITTERS		ISOLATOR	INDICATOR	CONTROLLER					
1A REACTOR ENCL UNIT 1 DIFFERENTIAL PRESSURE	M-76	1AIPD032	ZA	PD5HL76-198A	P76-198A	PD76-198A2	PD76-198A	X76-198A	PD176-198A	PDCT6-039A	PDIC76-041A	PDY76-098A	PDY76-161A	PDY76-198A
1B REACTOR ENCL UNIT 1 DIFFERENTIAL PRESSURE	M-76	1BIPD032	ZB	PD5HL76-198B	P76-198B	PD76-198B2	PD76-198B	X76-198B	PD176-198B	PDCT6-039B	PDIC76-041B	PDY76-098B	PDY76-161B	PDY76-198B

24V DC POWER SUPPLY NO.	120V INSTR AC		LOCATIONS							
	FUSE NO. & RATING	DWG NO.								
E/5FF-0B2	FU-23/6A	E-686,SH1	OAC94	PT7G-158A2	10C681	10C625	PDC76-039A	PDY76-161A	OAC124	24V
E/5FF-0B3	FU-24/6A	E-686,SH1	OBC94	PT16-188B2	10C681	10C625	PDC76-039B	PDY76-161B	OBC124	24V

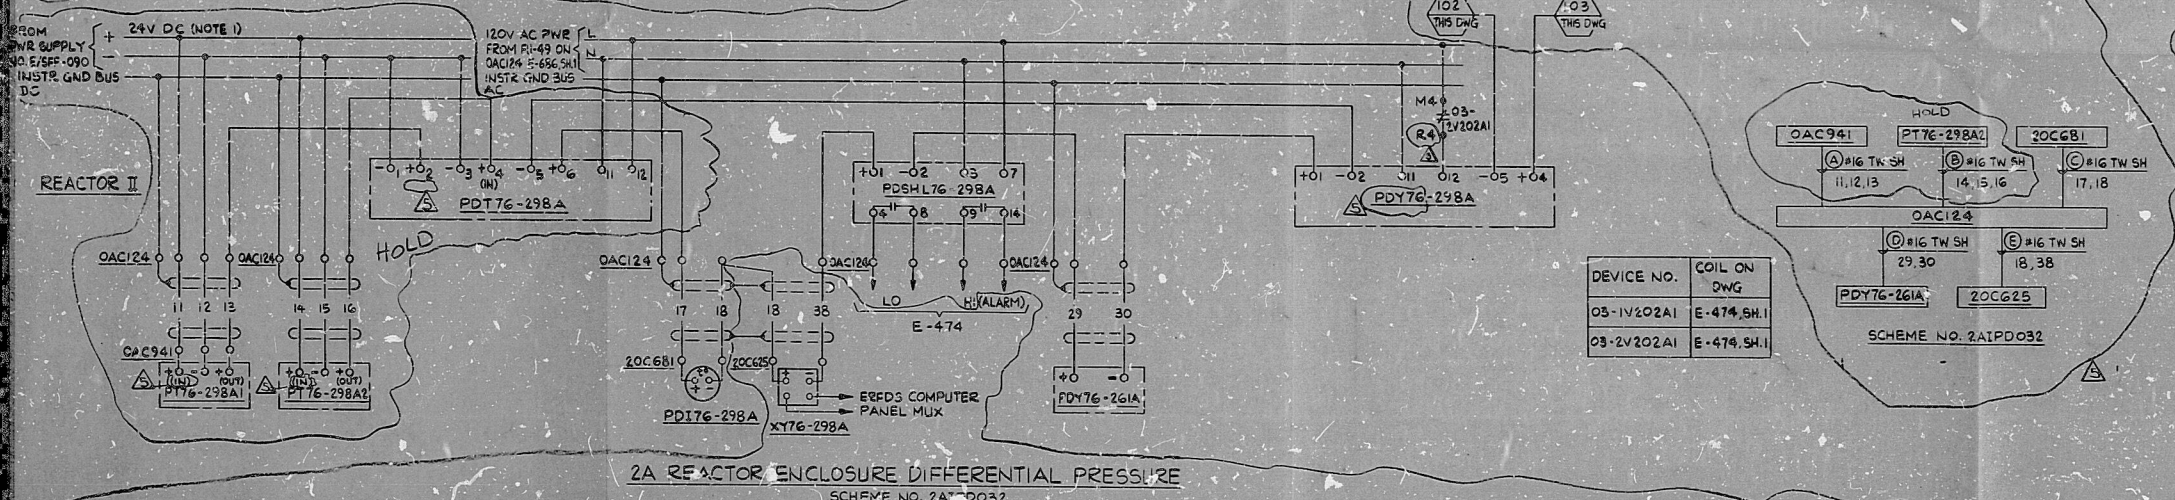

EQUIPMENT	Q NO.	SCHEME NO.	SAFEGUARD SEPARATION CHANNEL	DIFFERENTIAL PRESSURE								24V DC POWER SUPPLY NO.	120V INSTR AC FUSE NO. & RATING	DWG NO.	LOCATIONS					
				TRANSMITTERS				ISOLATOR INDICATOR								DISCRIMINATORS				

NOTES

1. FOR 24V DC POWER SUPPLY, SEE 5H.1, THIS DWG.
2. DELETED
3. DELETED

REFERENCE DRAWINGS

- ① FP=8031-M-1-B21-1090-E-23.5 ELEMENTARY DIAGRAM
(GE DWG #791-E-4010N(SH88)) NUCLEAR SYSTEM
SUPPLY SHUTOFF SYSTEM
- ② 8031-E-483, SH.2
- ③ SCHEMATIC DIAGRAM
STANDBY GAS
TREATMENT SYSTEM
EXHAUST FANS - COMMON

ADDS HUB & 340
DISCOP 1, 2, 3, 354E SPLIT
SCHEME CAPPO32 INTO
THREE SEPARATE SCHEMES,
RELATED PERUELING
PORTION OF SCHEME CAPPO32
TO 54 IS ADDED LOG DATA FOR
SERIES 5, 6, 7, 8, 9, 10, 11, 12
TABLE & BLOCK DATA
DELETED ROW 2, 12, 13, 14
TRANSFERRED SCHEME
(A/B/T/O/91 & C/D/O/1991)
FROM THIS SA TO 54, 10, 11, 12
AND 13, 14, 15, 

SIZE D

Rids

8301110104

