


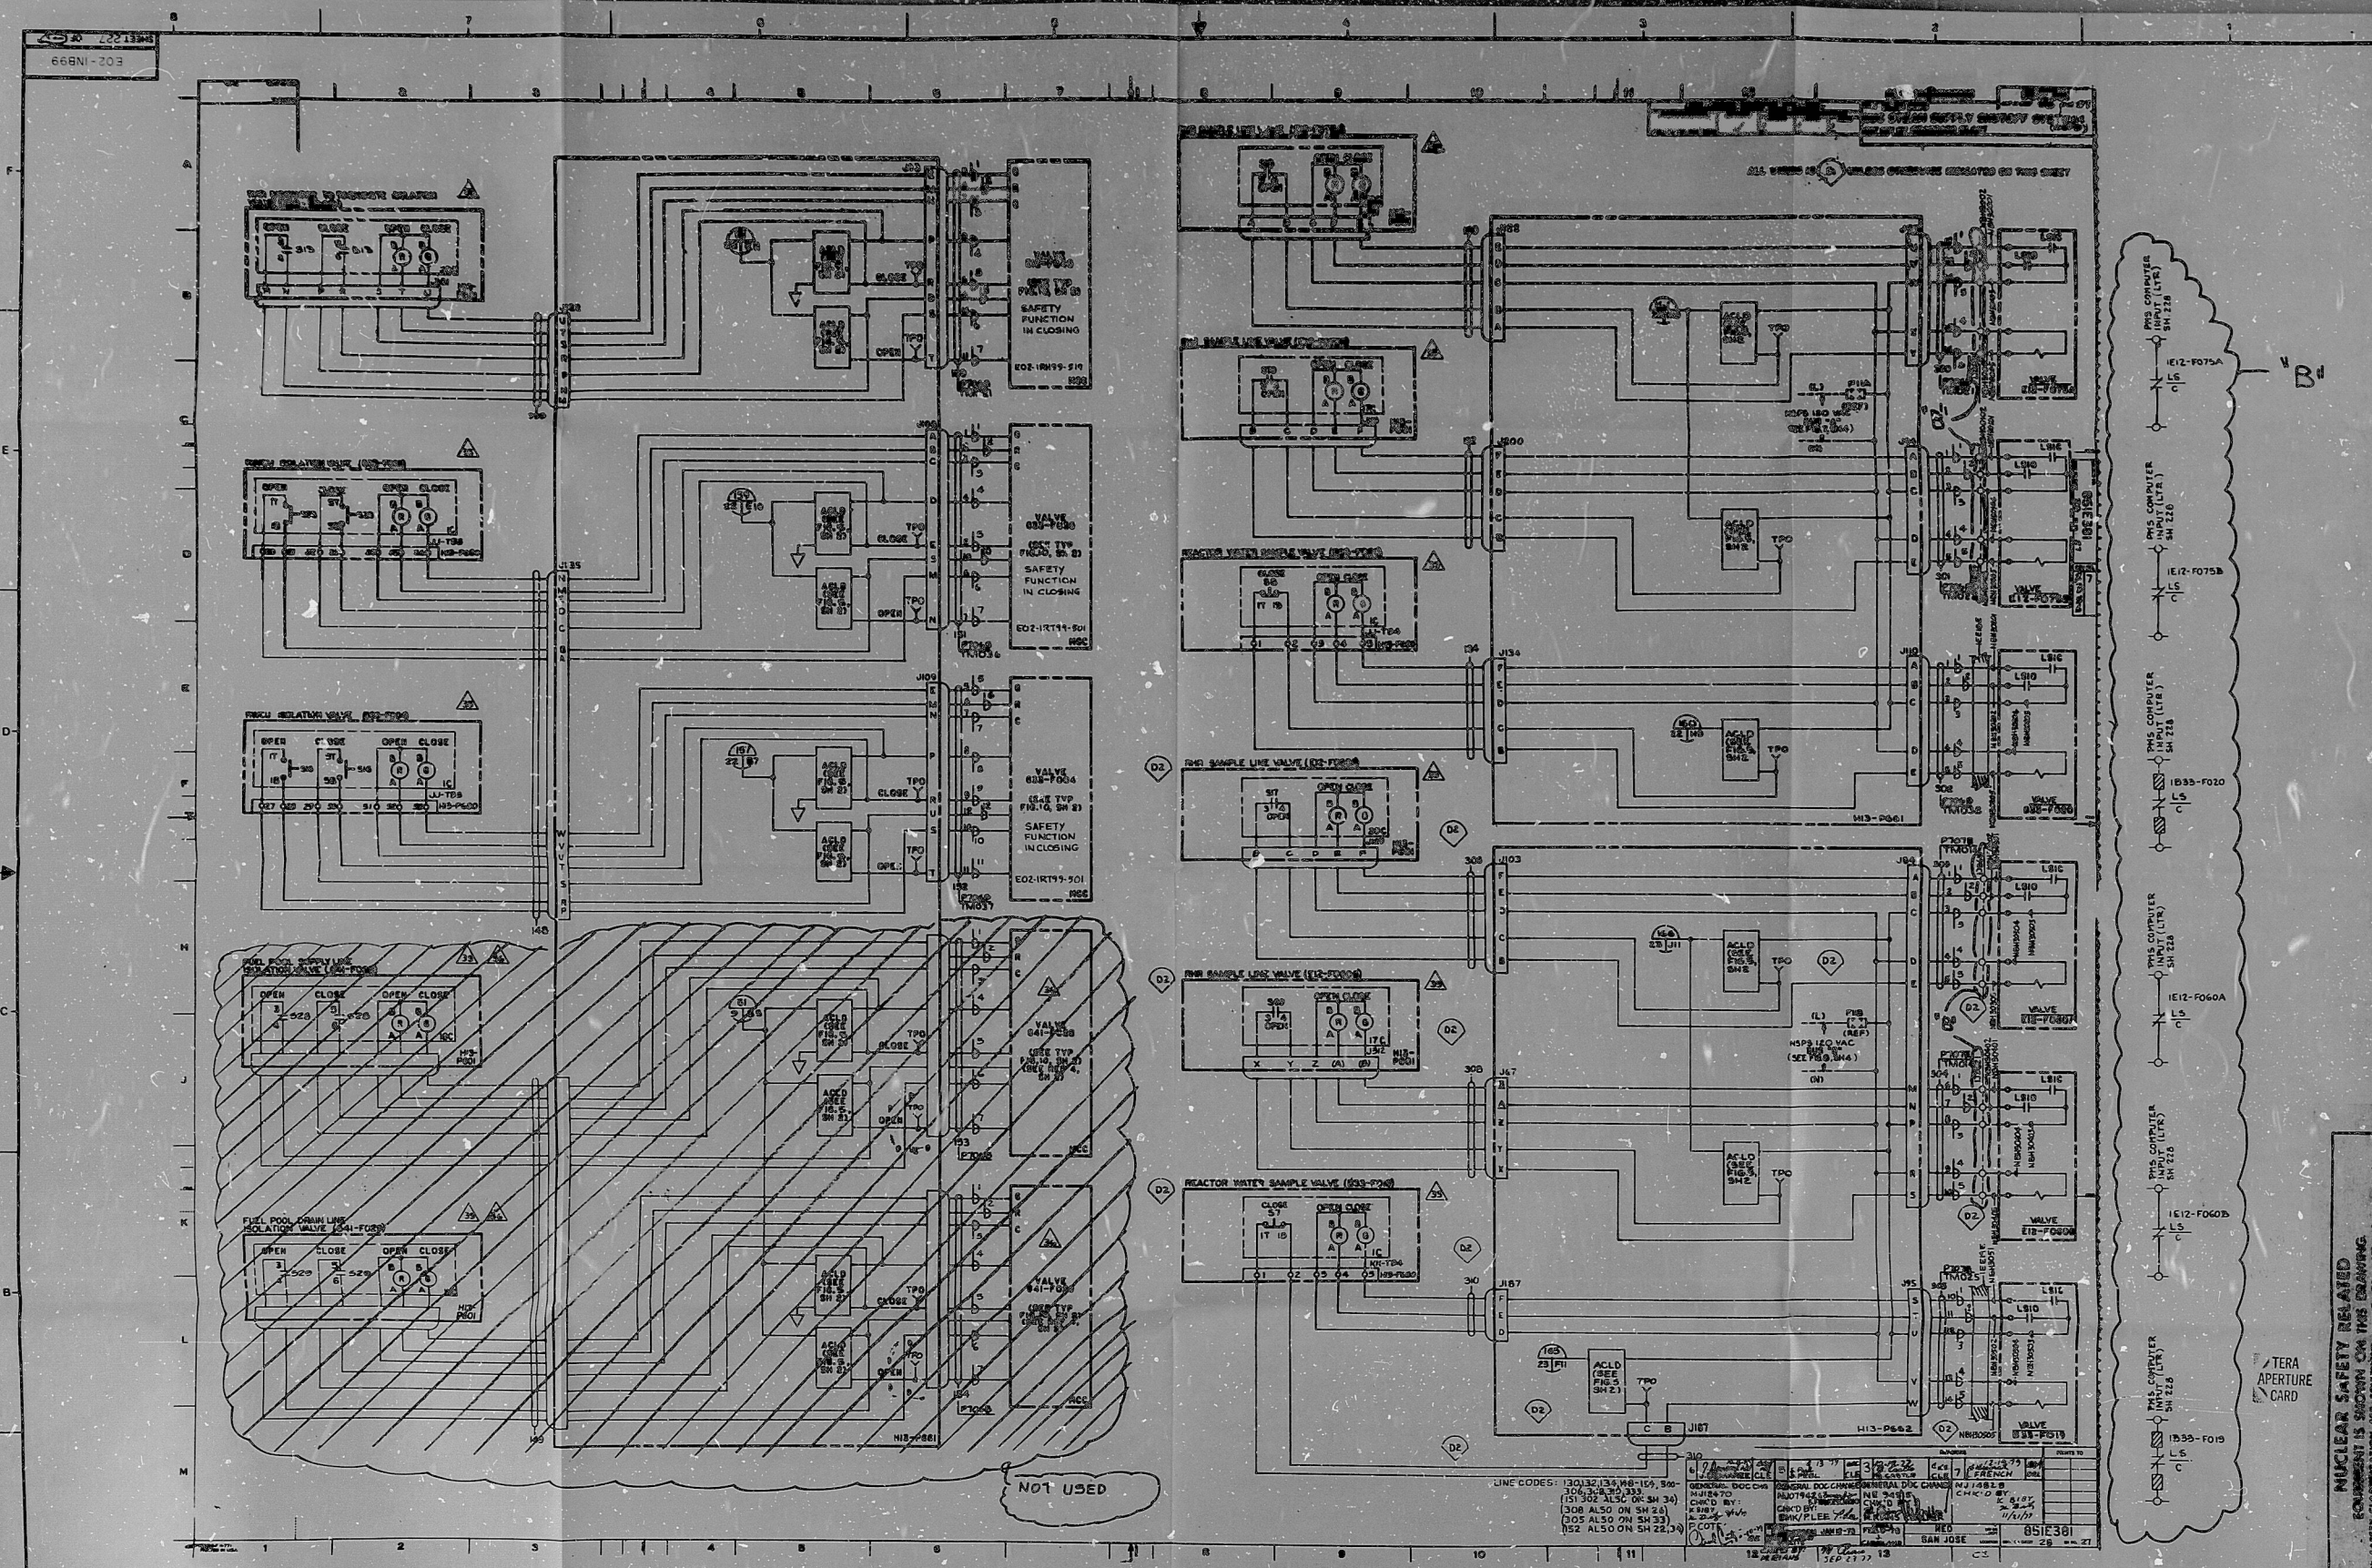



NUCLEAR SAFETY RELATED
EQUIPMENT IS SHOWN ON THIS DRAWING
FOR SAFETY CLASSIFICATION AND IDENTIFICATION PURPOSES ONLY

TERA APERTURE CARD

NUCLEAR SAFETY RELATED
EQUIPMENT IS SHOWN ON THIS DRAWING
FOR SAFETY CLASSIFICATION AND IDENTIFICATION PURPOSES ONLY

SARGENT & LUNDY
CHICAGO, ILLINOIS

DRAWING NO. E02-INB99
REV. B
SHEET 227 OF 228

CLINTON POWER STATION UNIT 1
ILLINOIS POWER COMPANY
CLINTON, ILLINOIS



