


13-10-2091-823

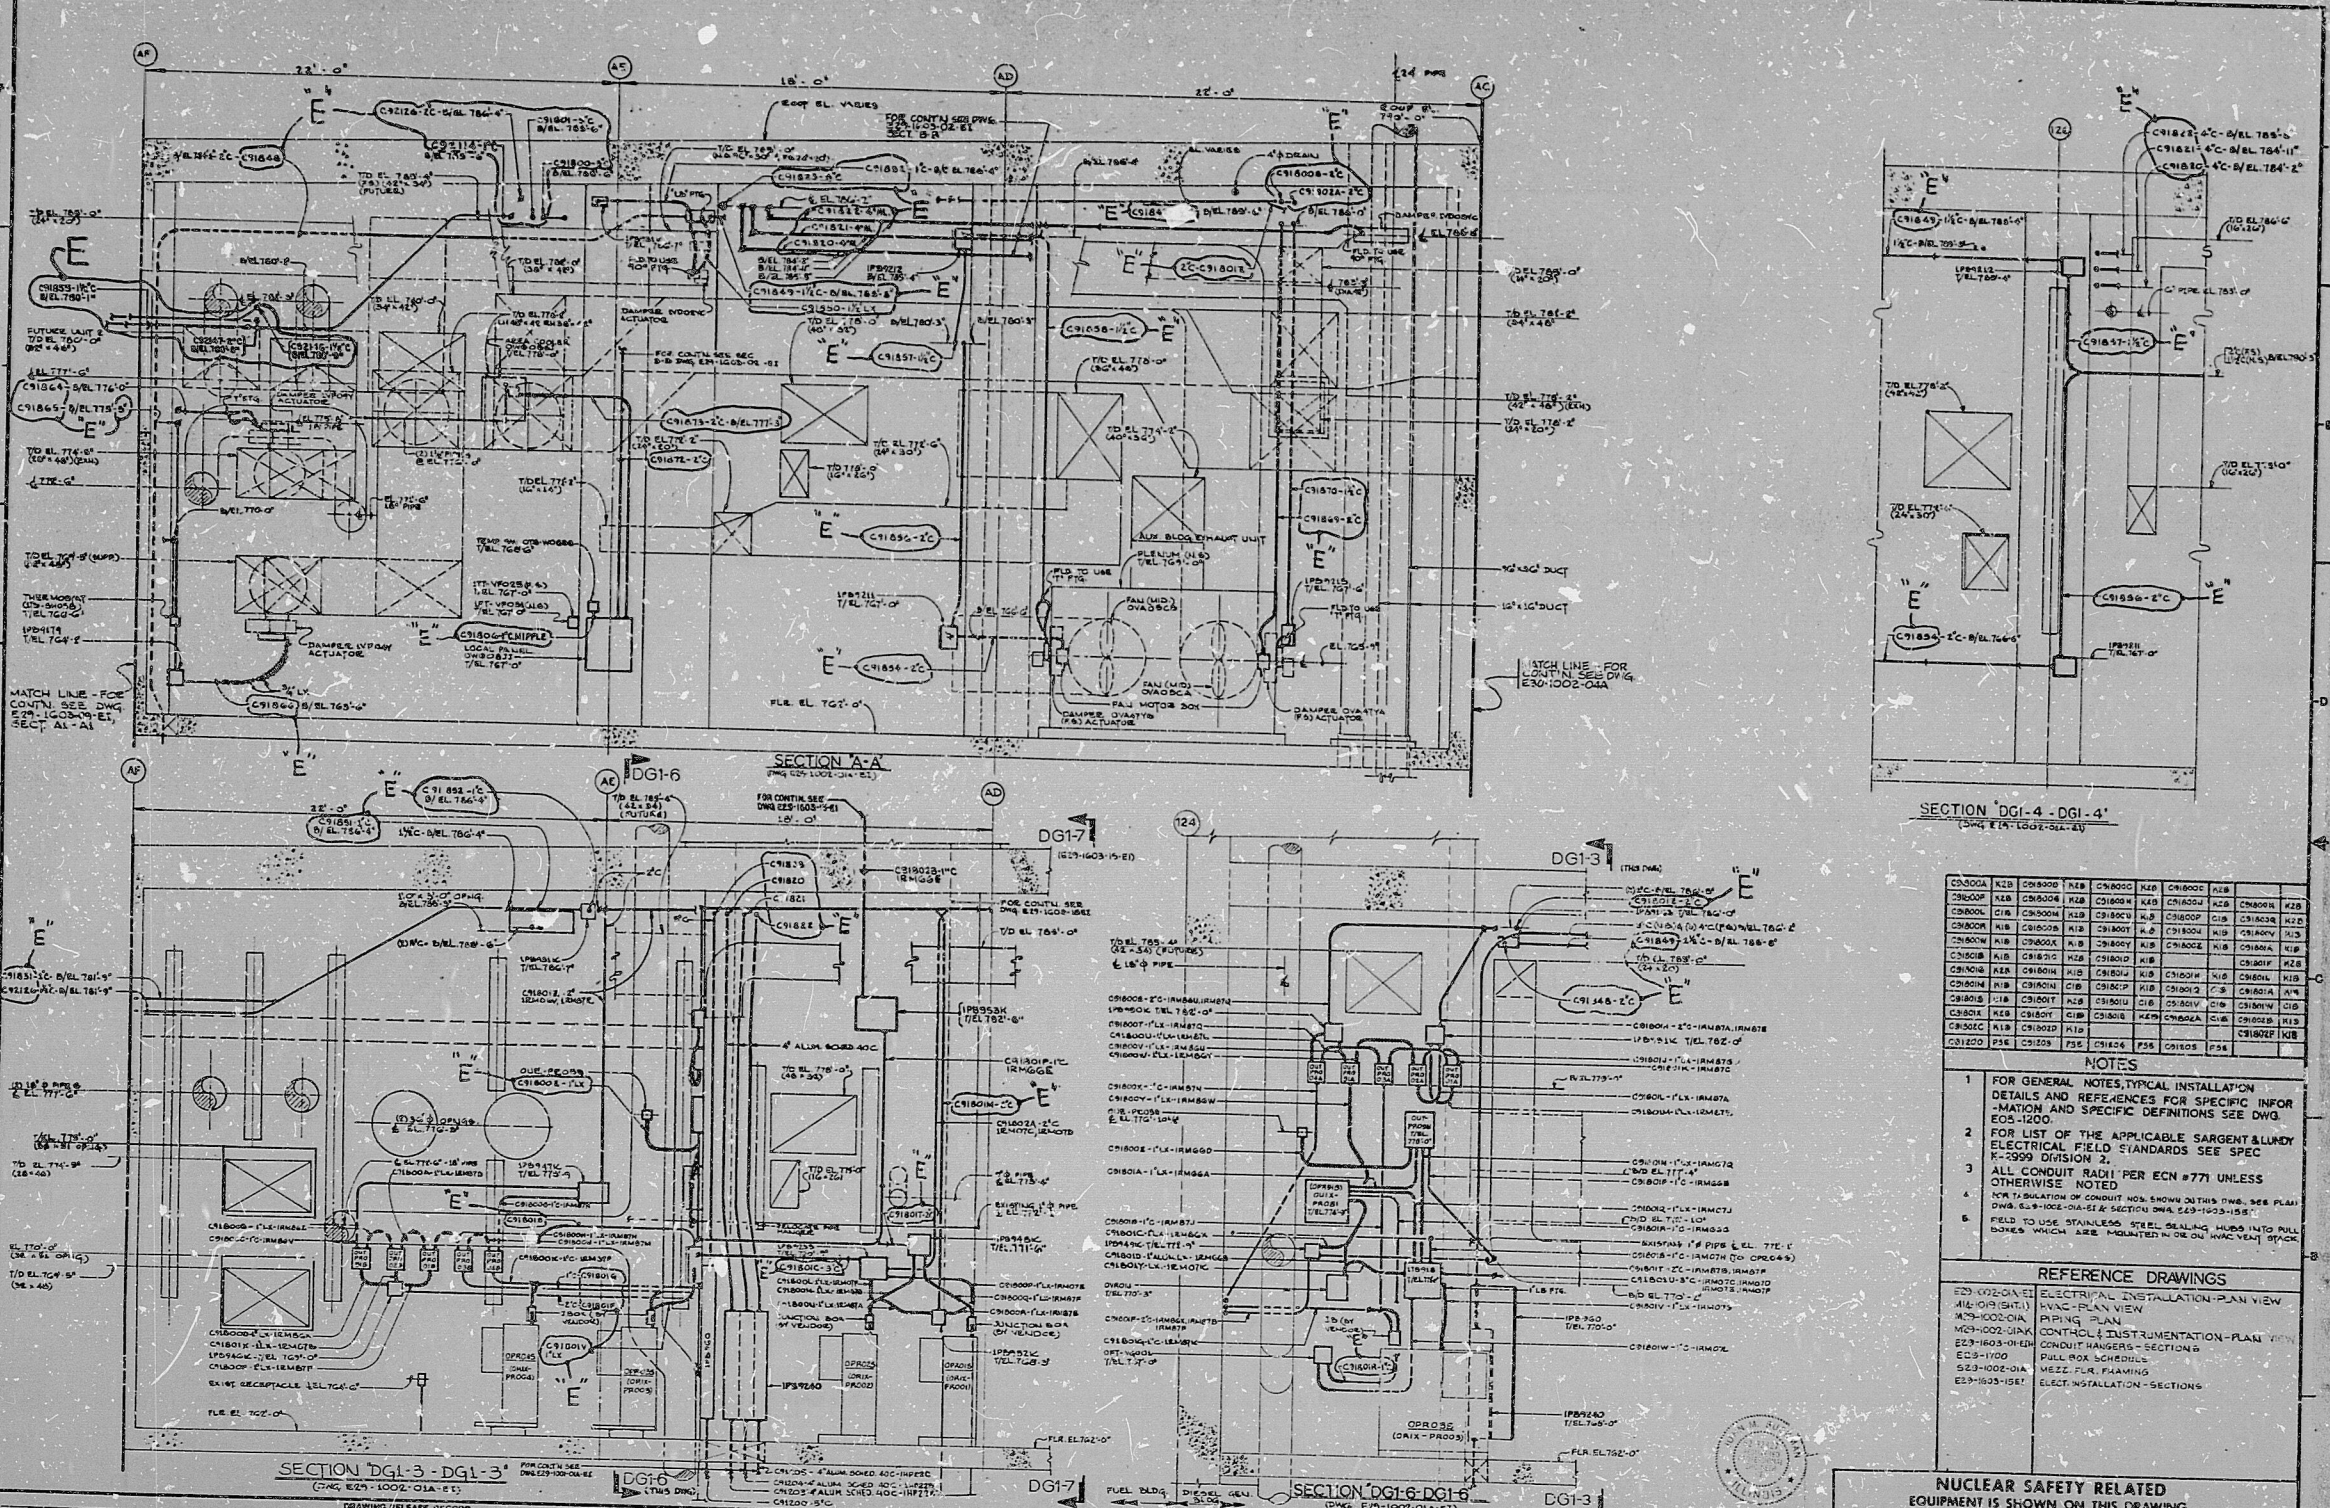

| |
|---|
|---|

- NOTES
  - ALL CONDUIT RADI PER ECN #771 UNLESS OTHERWISE NOTED.

| REFERENCE DRAWINGS                             |
|------------------------------------------------|
NUCLEAR SAFETY RELATED EQUIPMENT IS SHOWN ON THIS DRAWING. (FOR SAFETY CLASSIFICATION SEE EQUIPMENT, VALVE OR INSTRUMENT LISTS.)

ELECTRICAL INSTALLATION DIESEL GEN/HVAC BLDG. SECTIONS MEZZ. FLR. EL. 762'-0" CLINTON POWER STATION UNIT-1 ILLINOIS POWER COMPANY CLINTON, ILLINOIS

SARGENT & LUNDY

DRAWING NO. E03-1003-01-EI

SHEET OF E

PRC APERTURE CARD

RIDS

8301110197

