


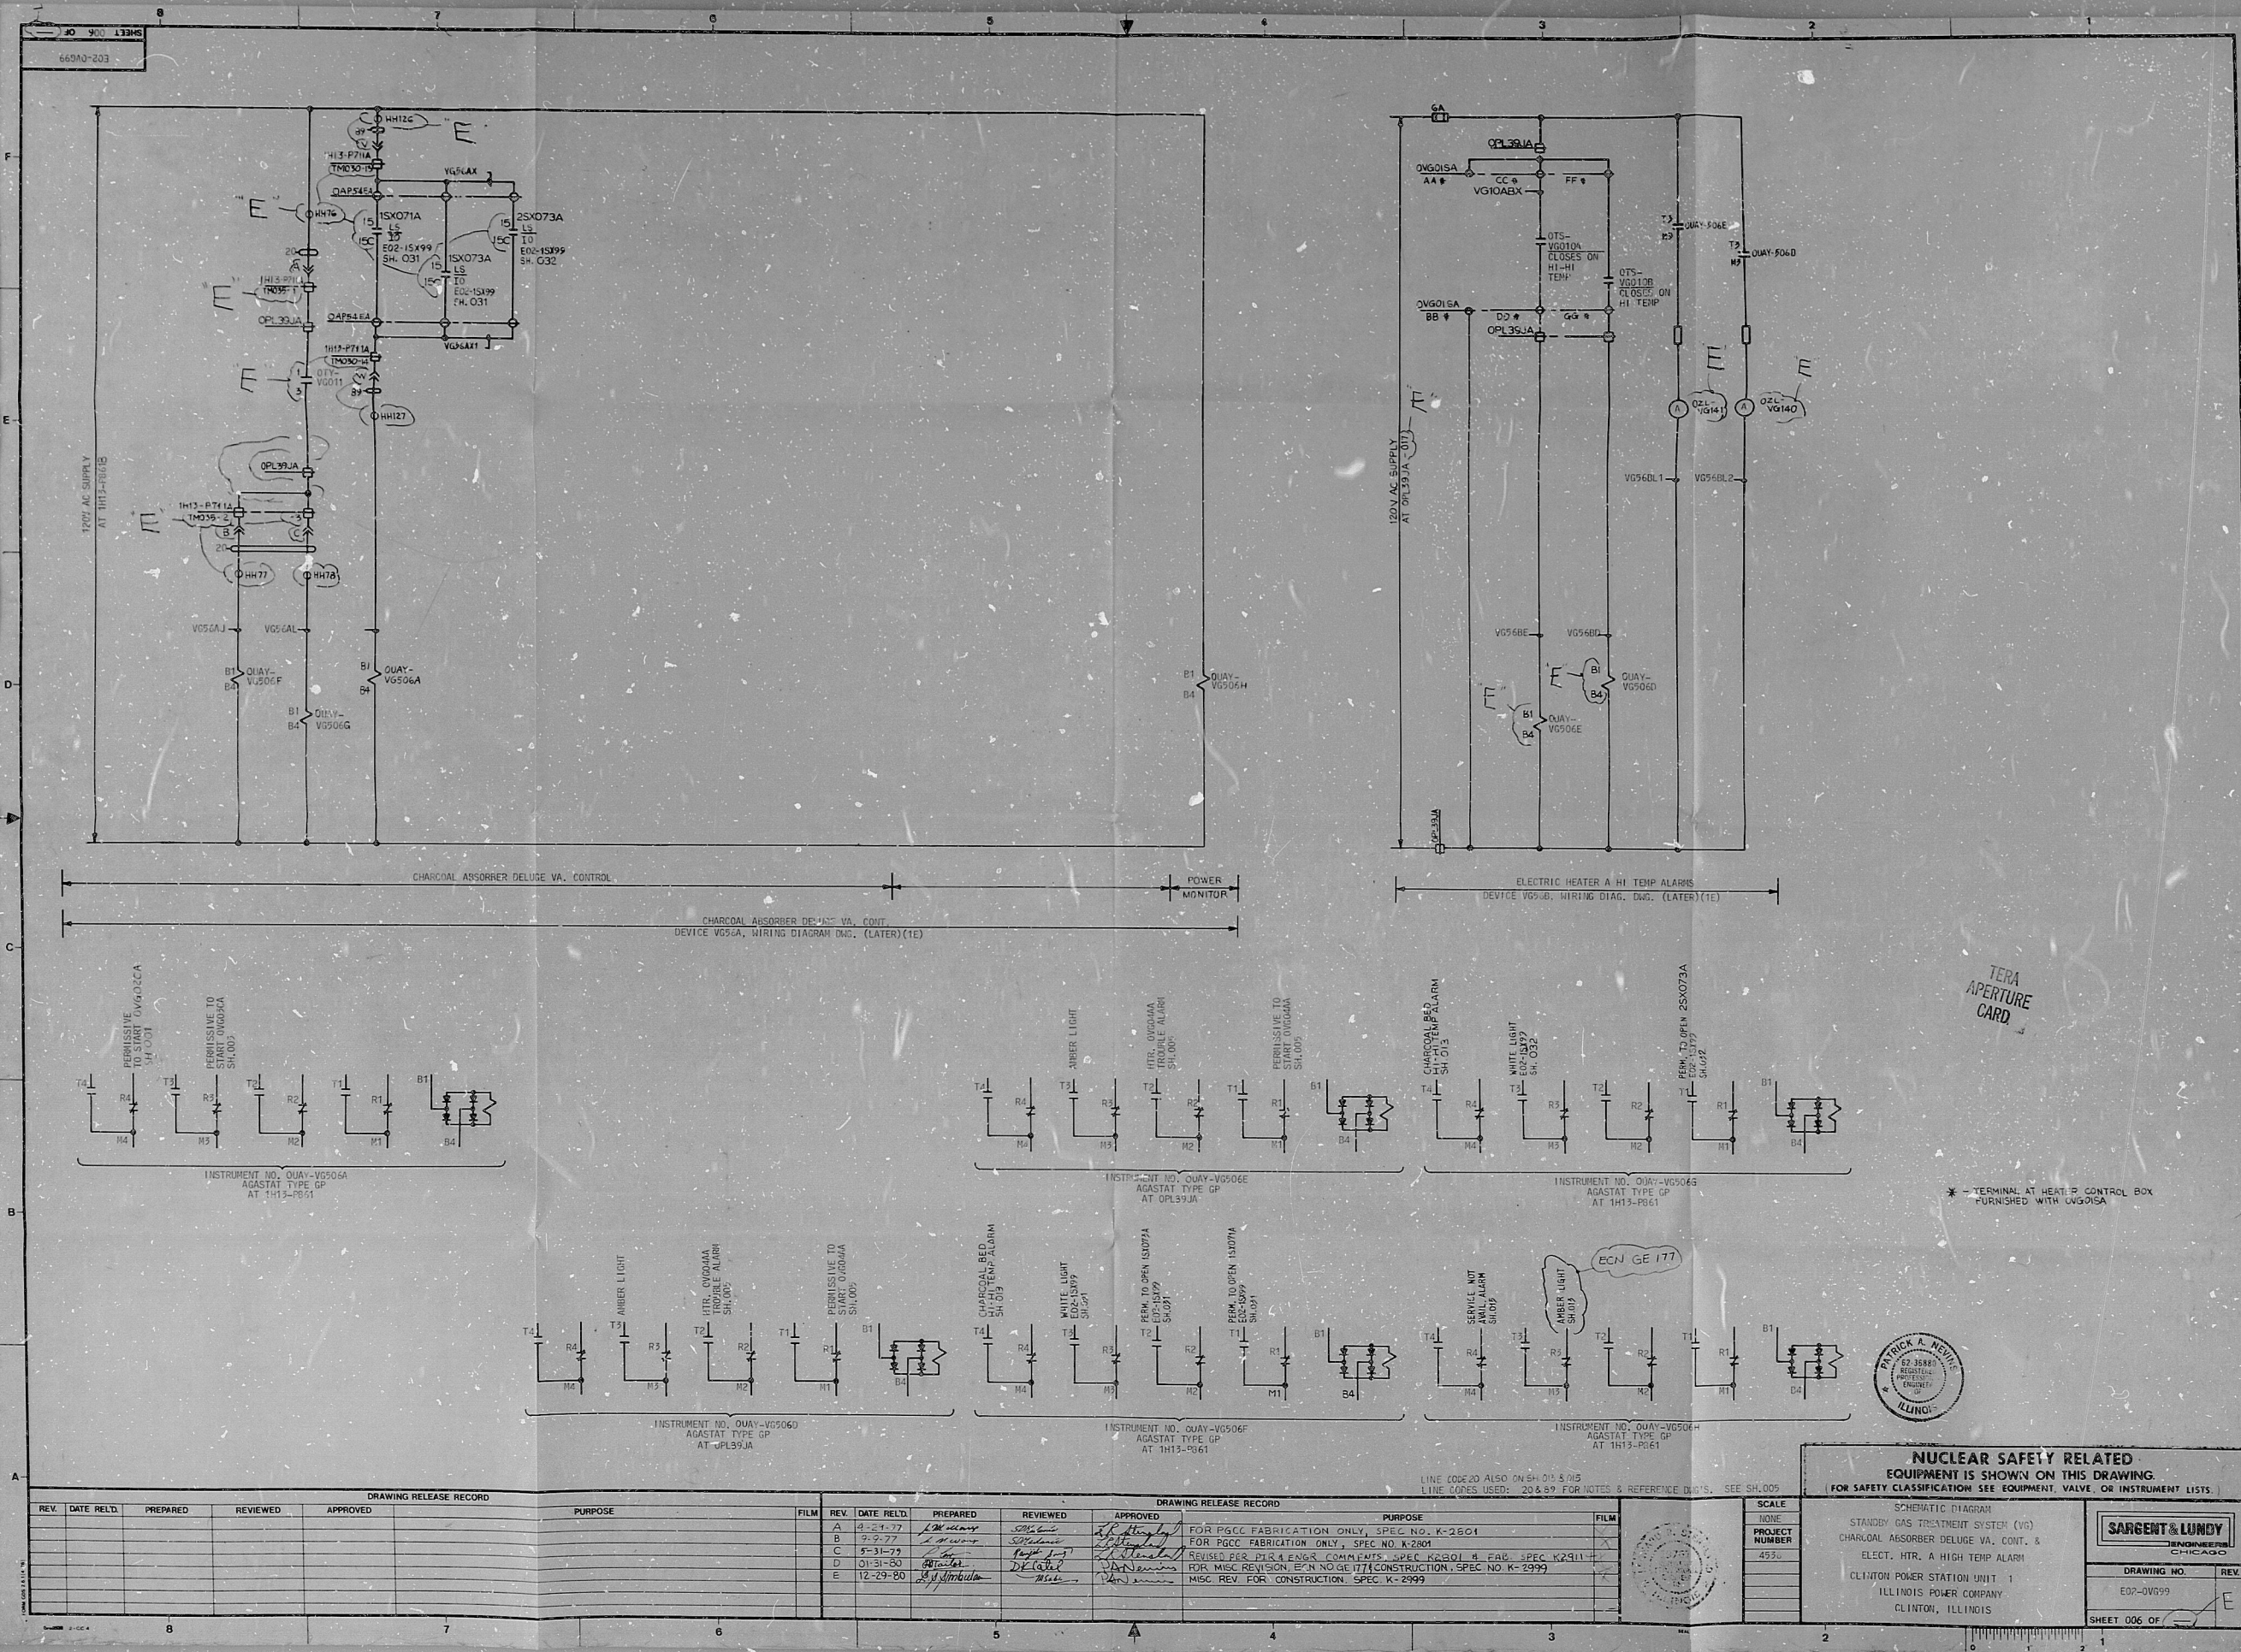



Ribf

8107160267

