


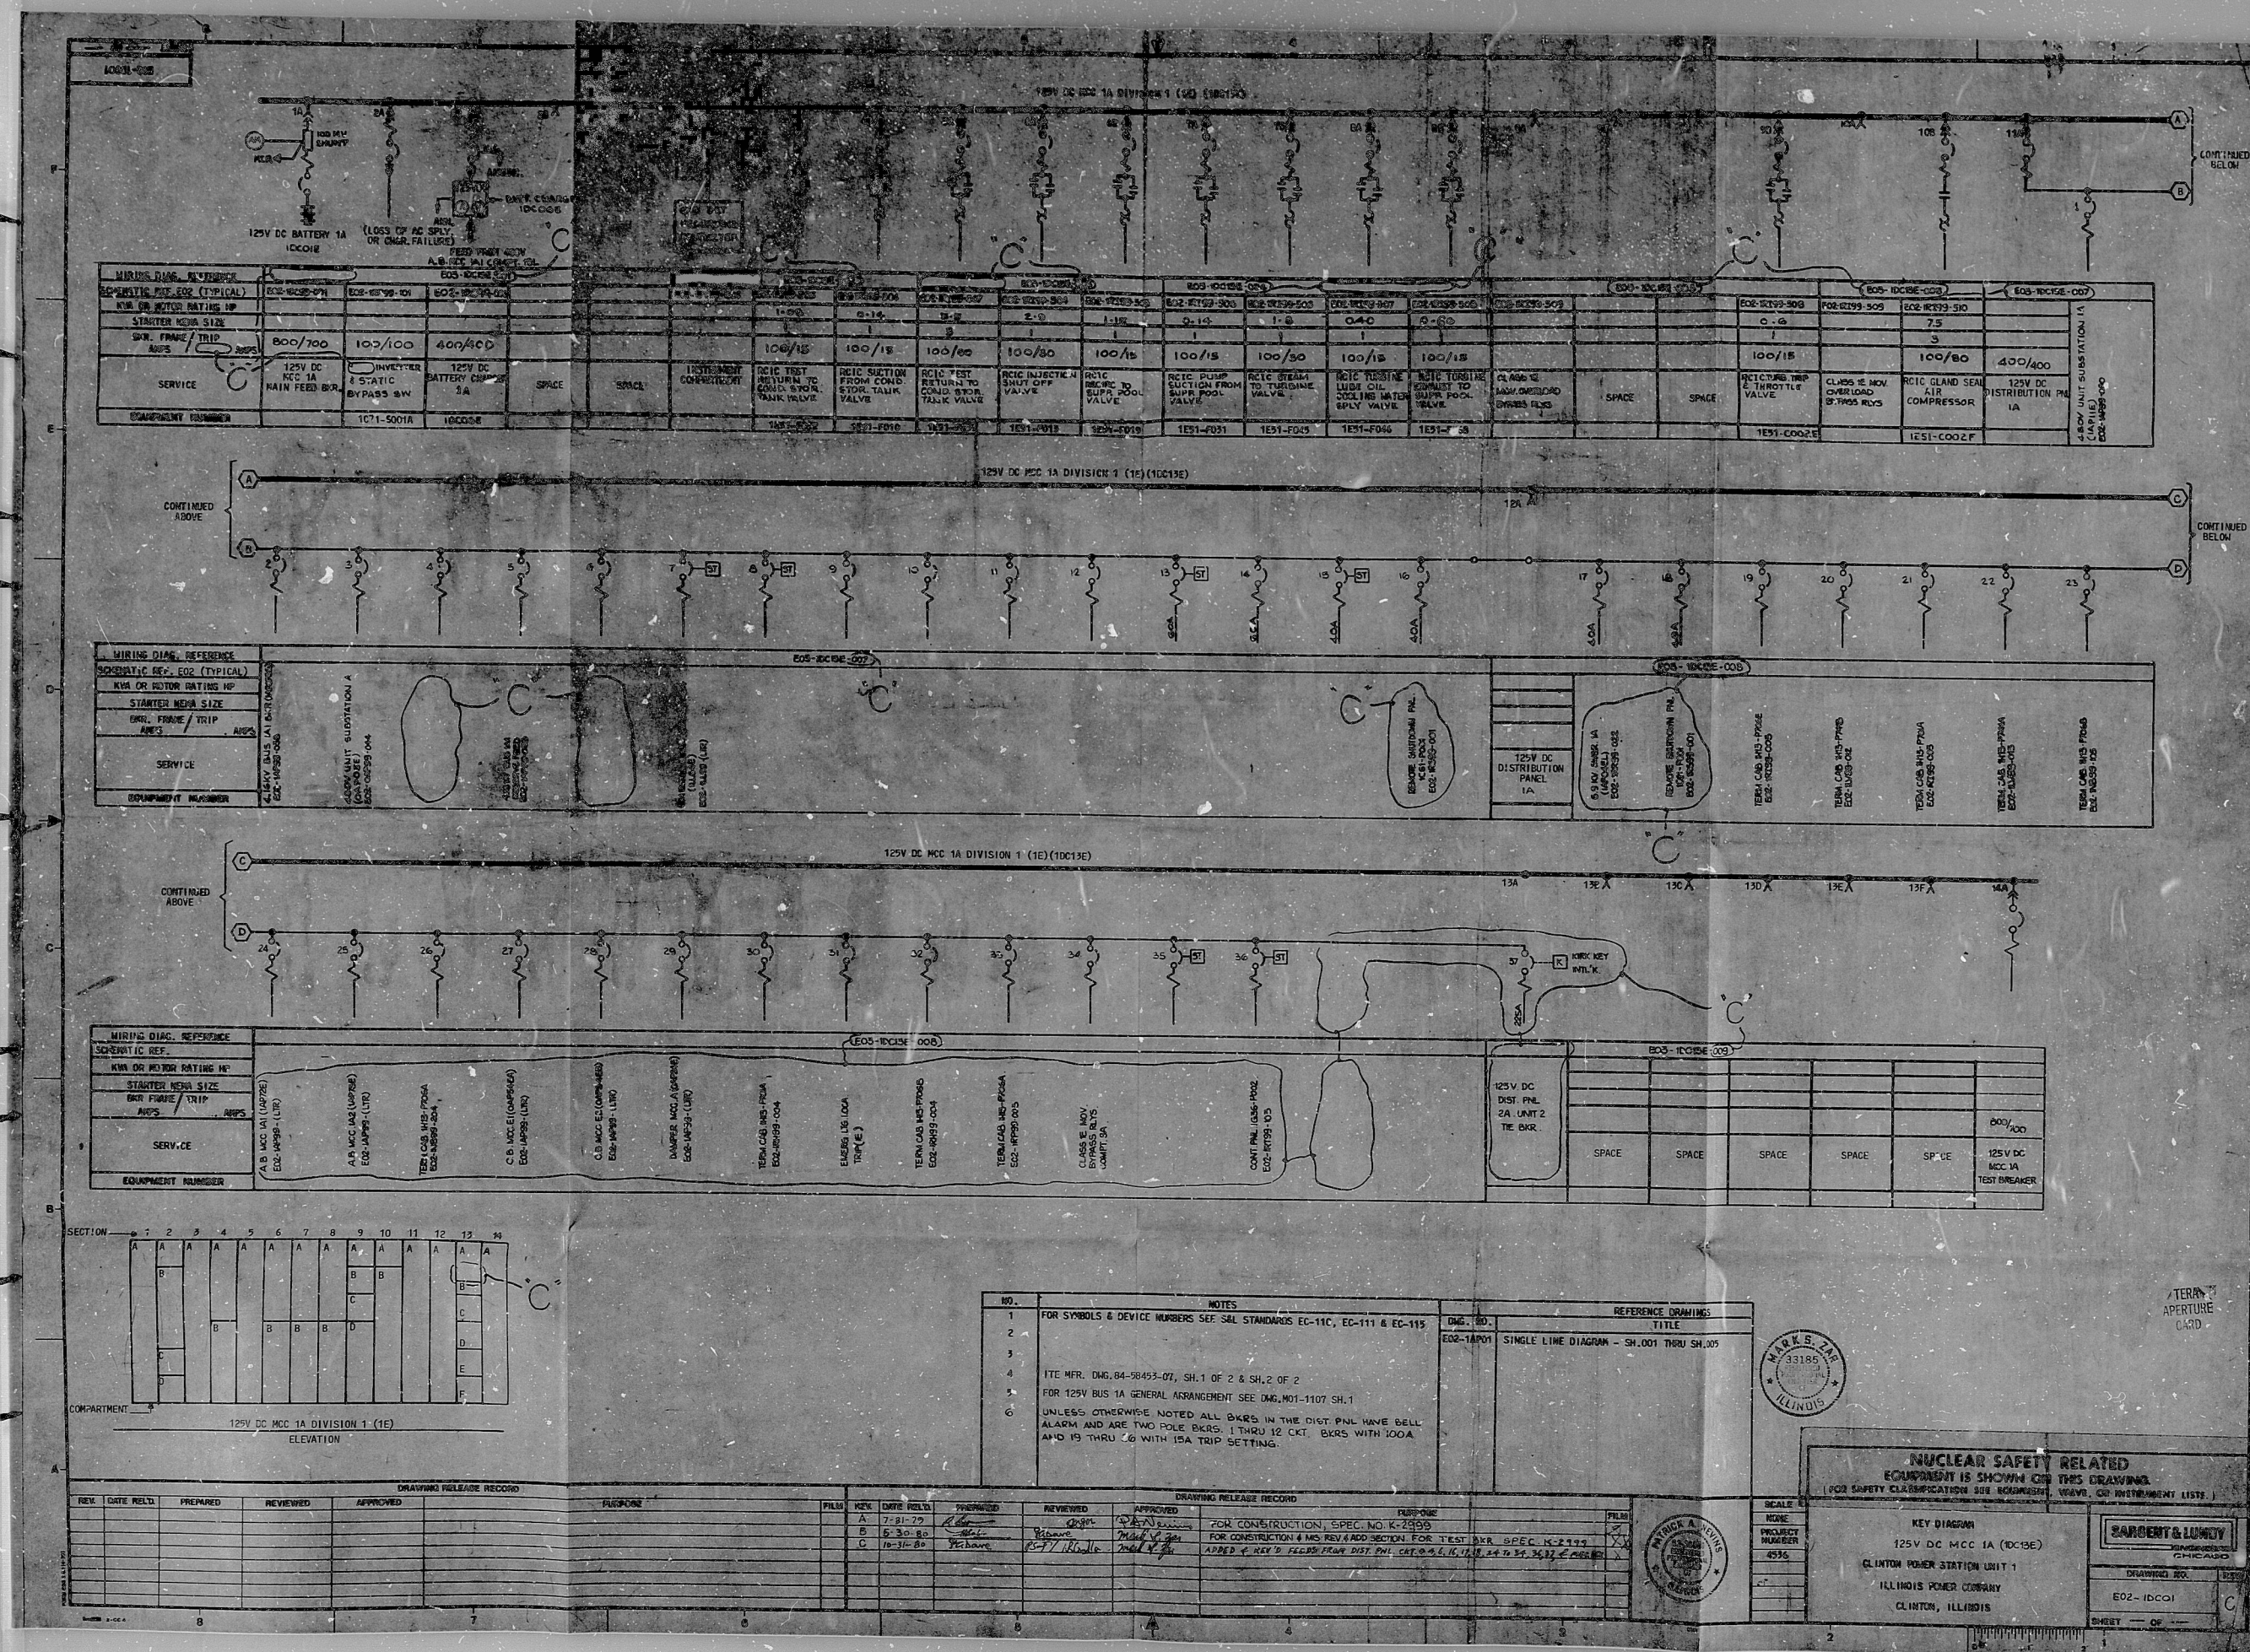

RDS

8107160337

