


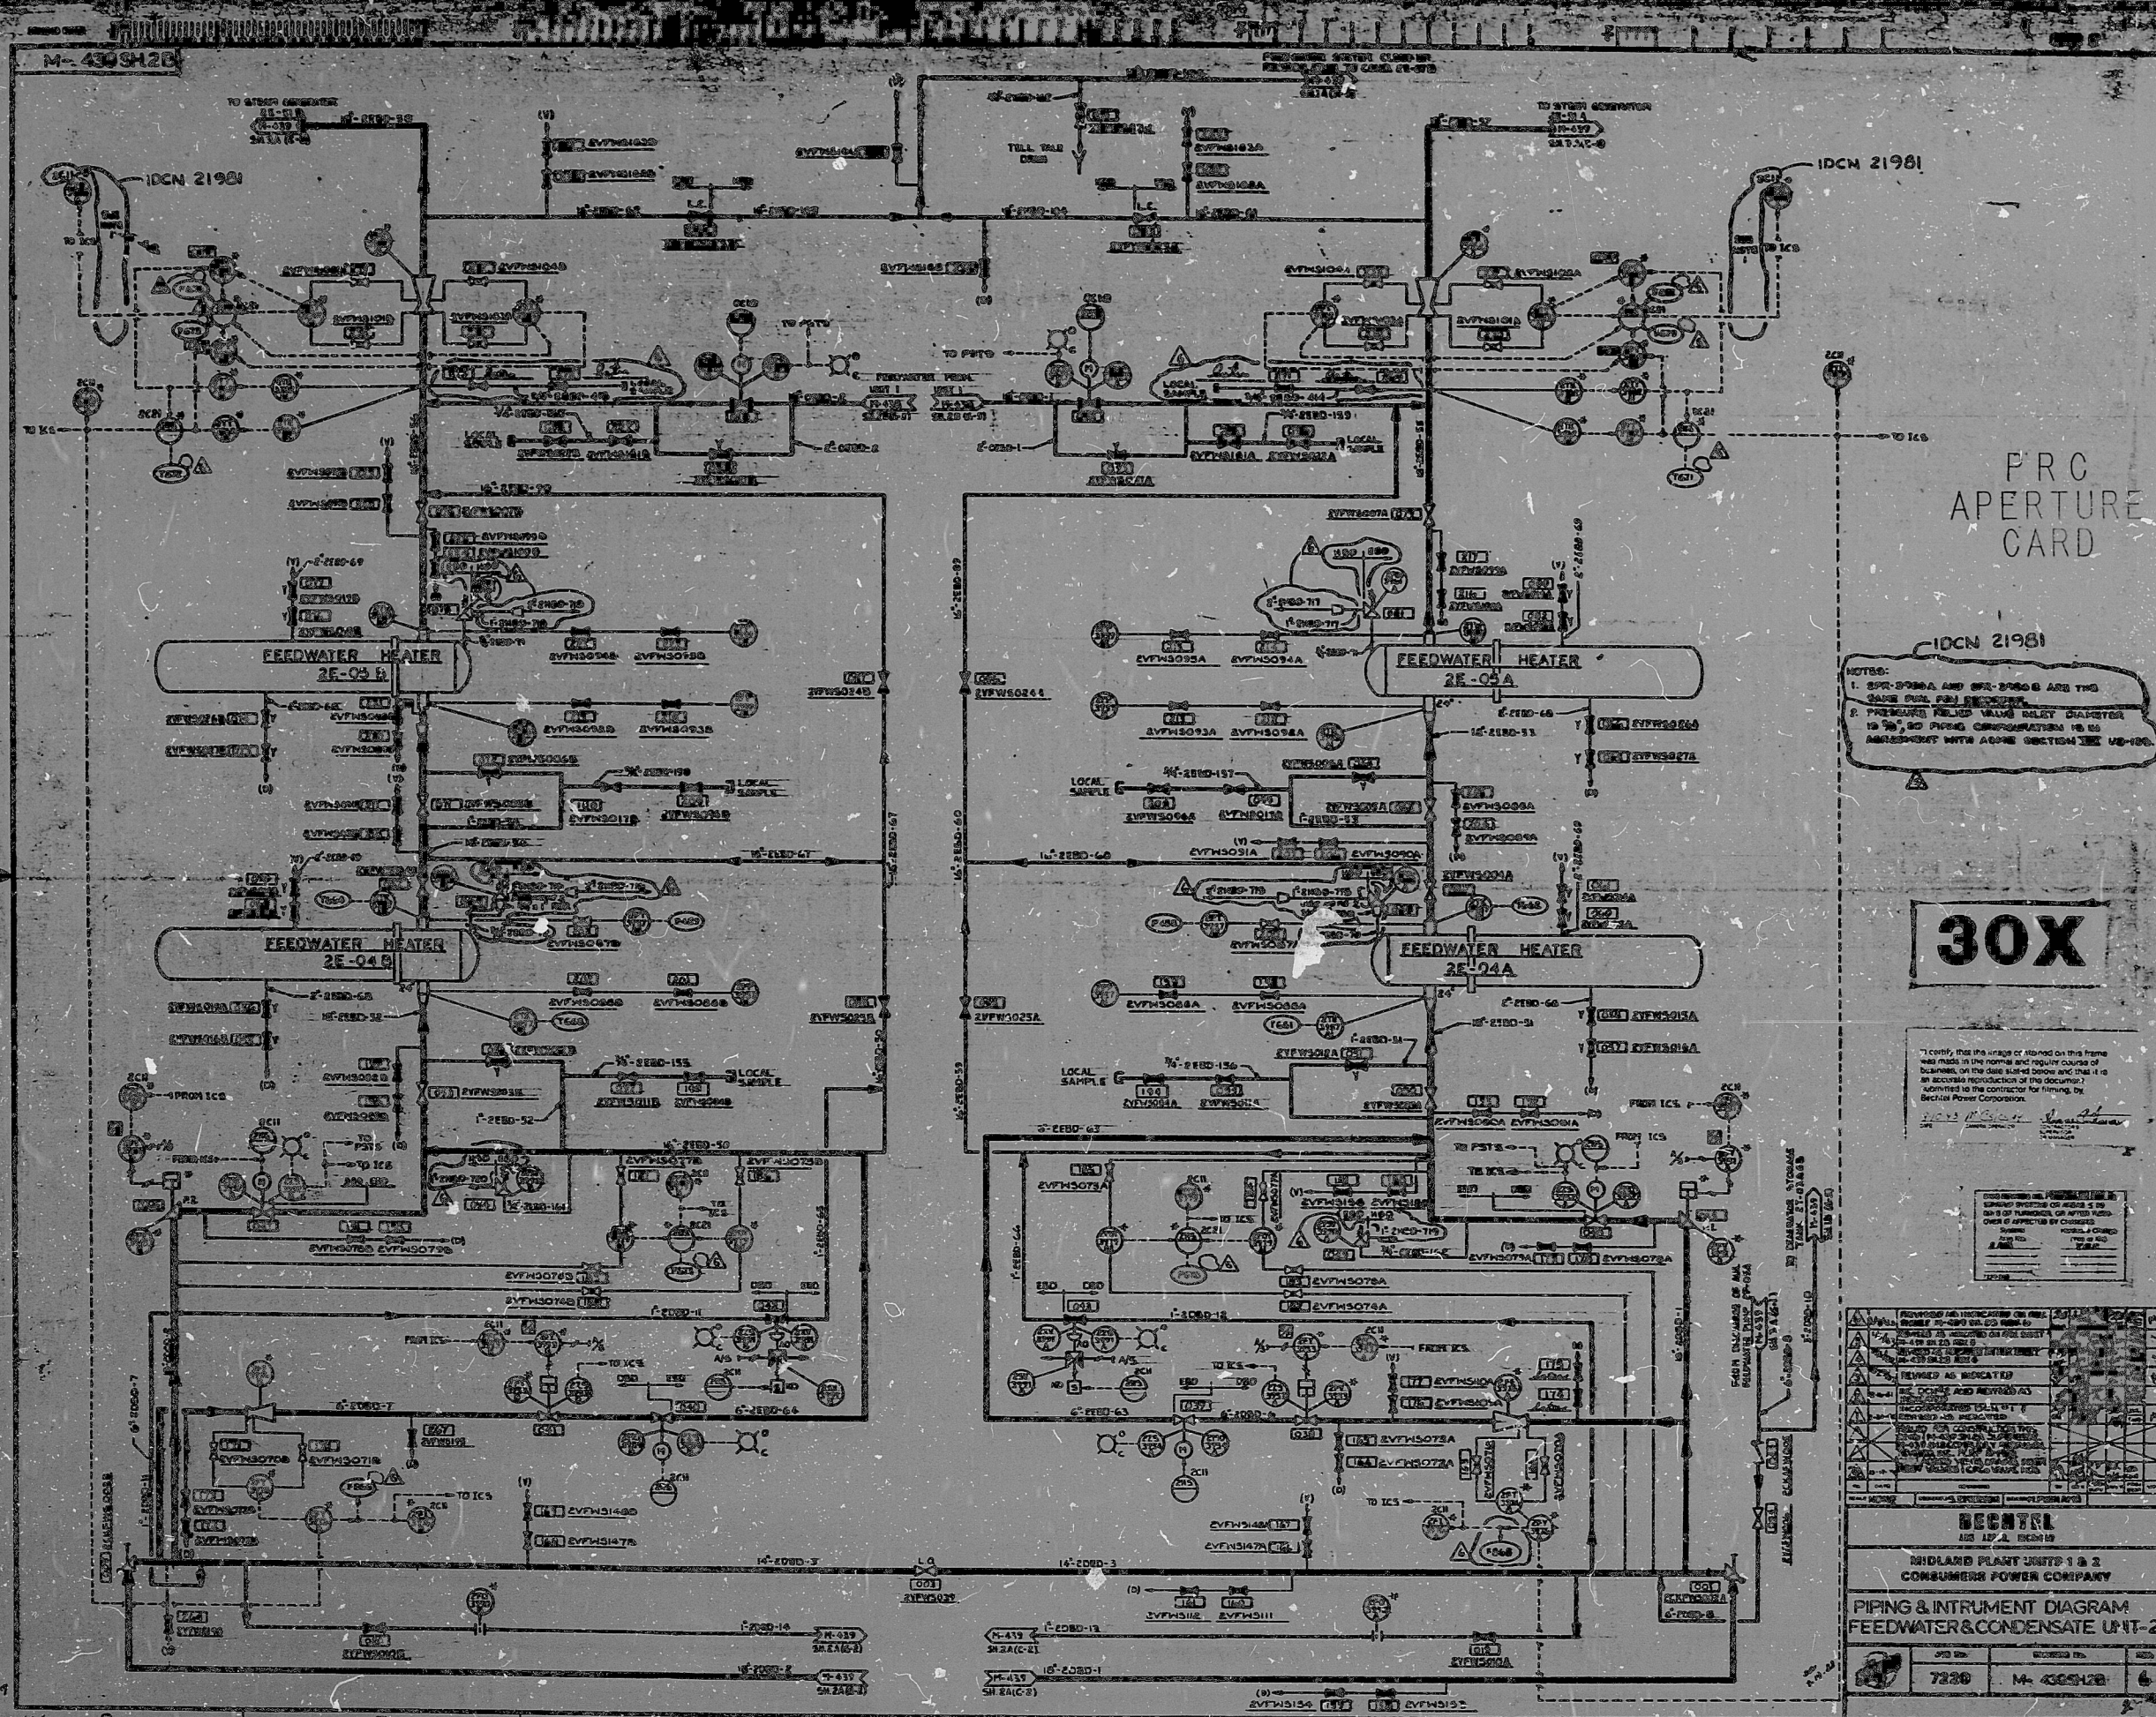

PRC
APERTURE
CARD

30X

[illegible]

PDR RIDS

8312230236

