


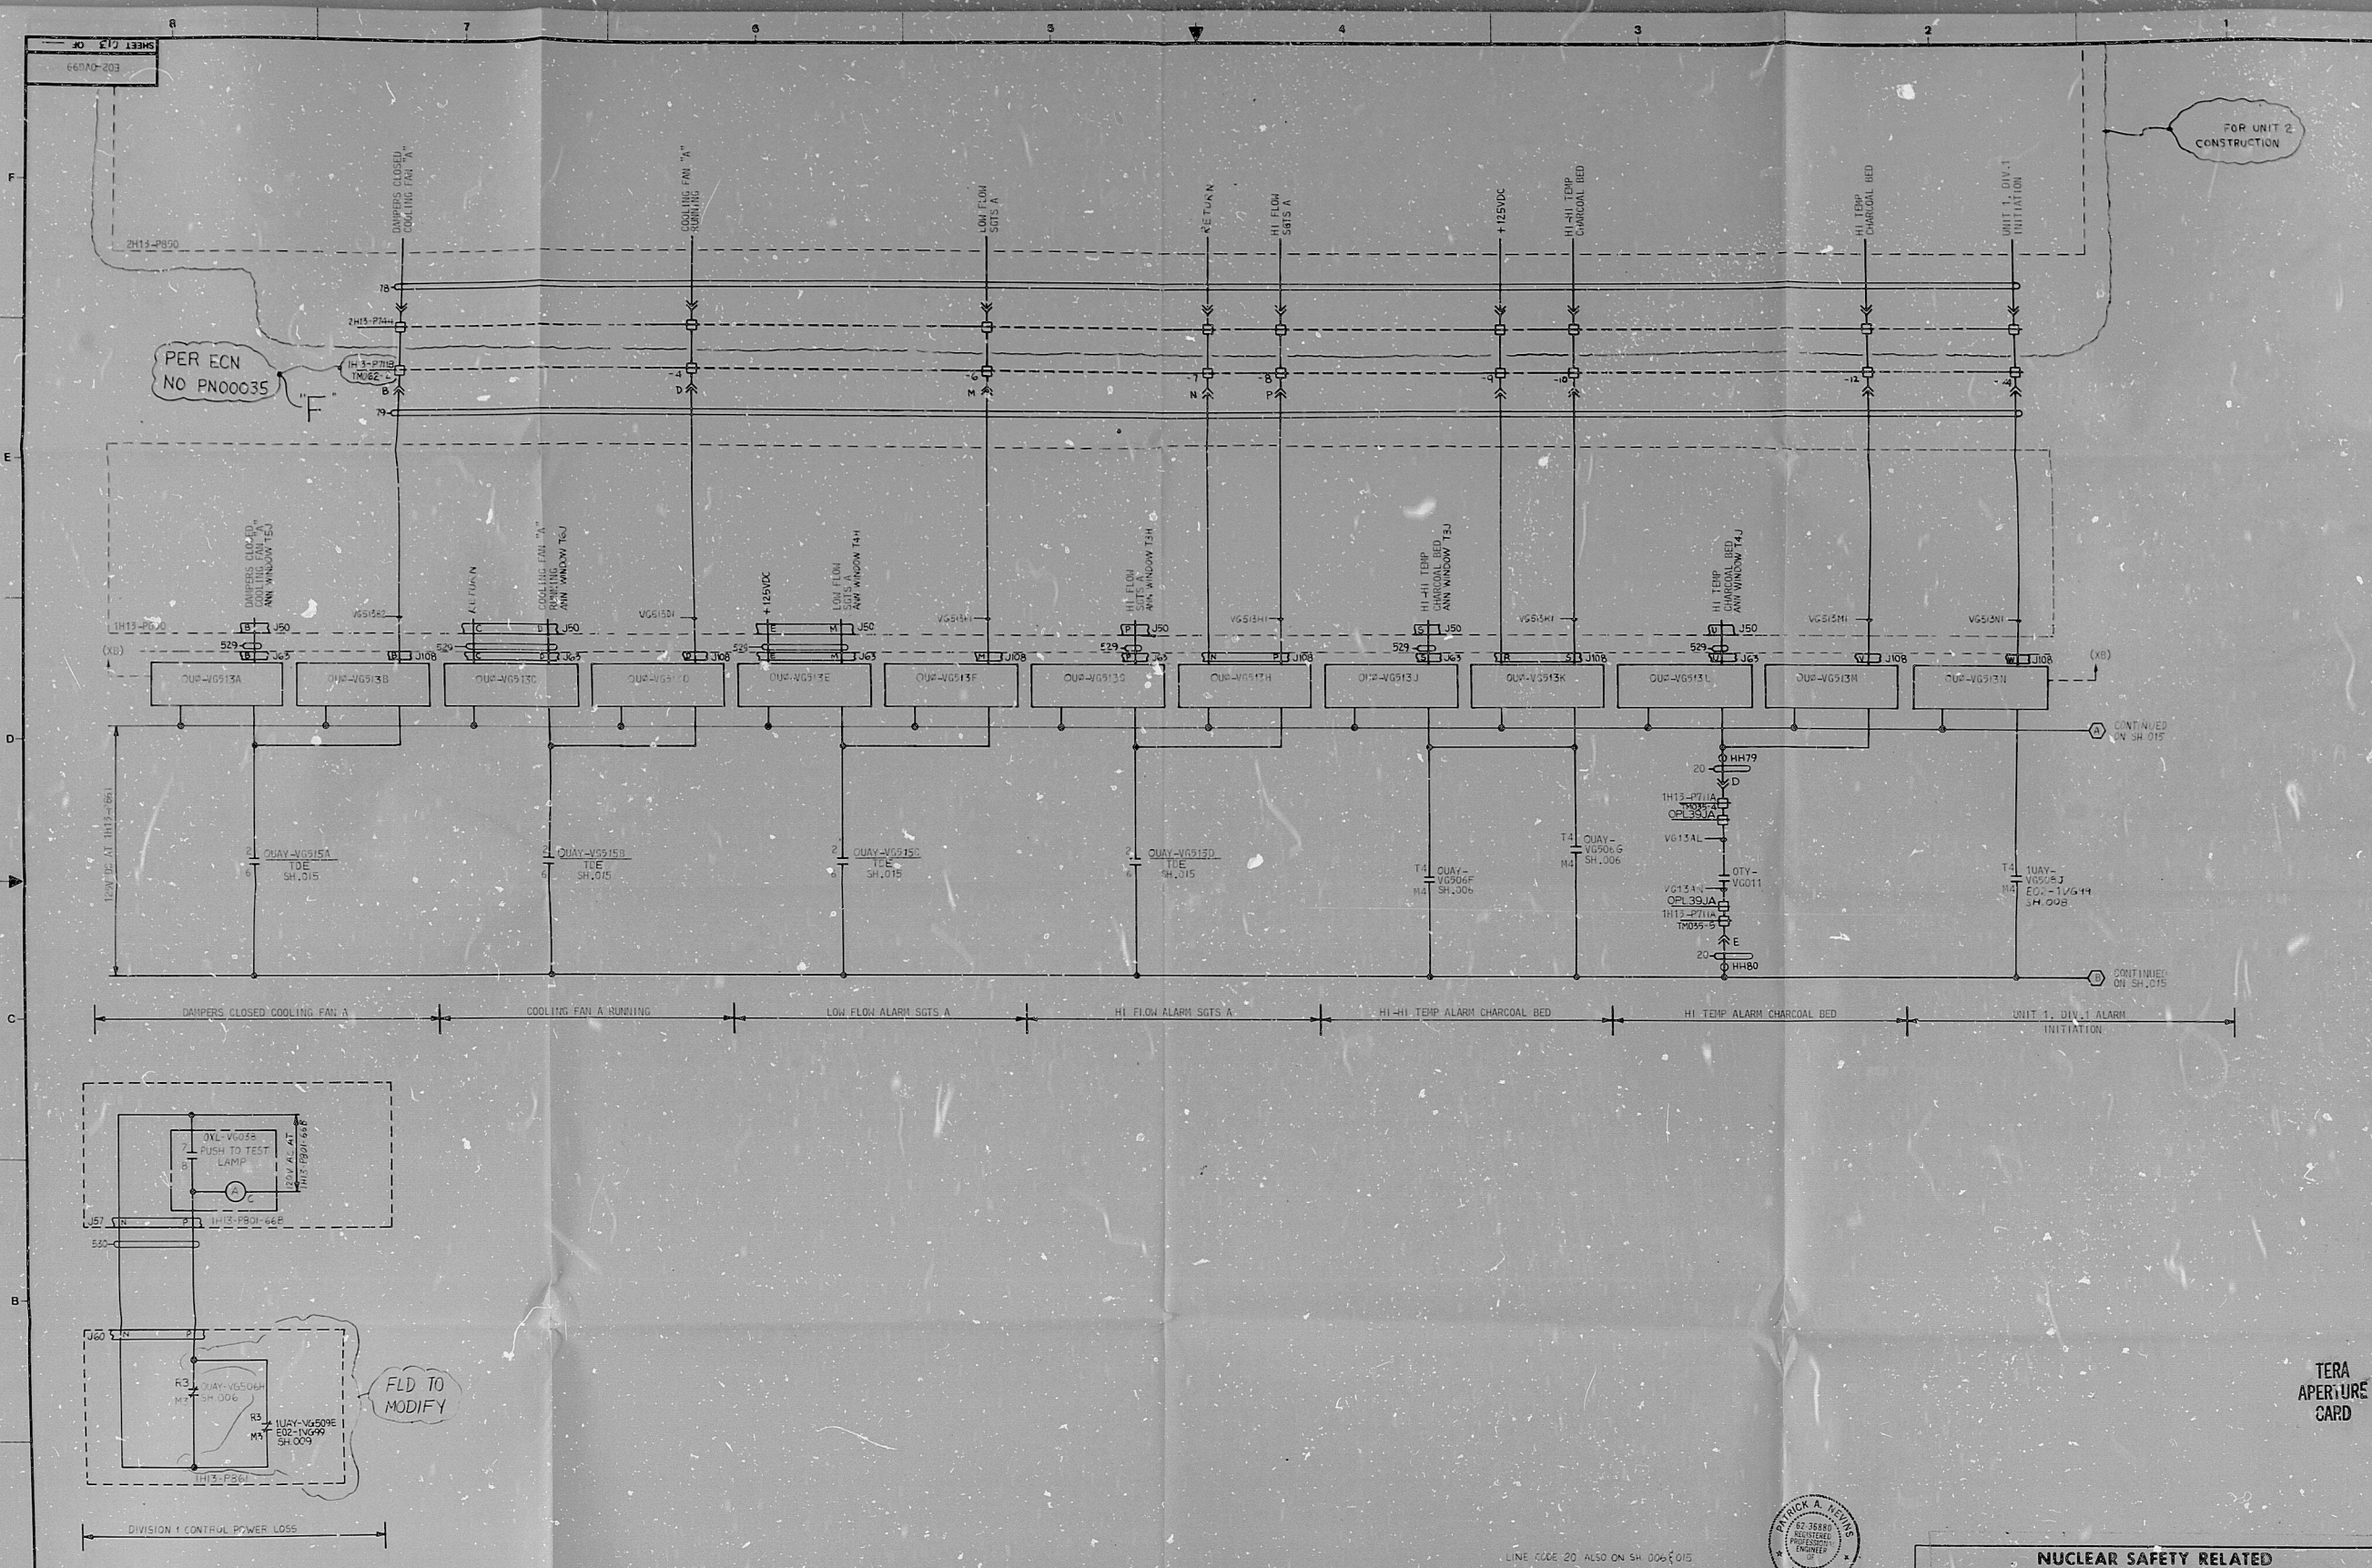

REV.	DATE	RELD.	PREPARED	REVIEWED	APPROVED	PURPOSE	FILM
A	4-24-77					FOR POC FABRICATION ONLY, SPEC. NO. K-2801	
B	7-7-77					FOR POC FABRICATION ONLY, SPEC. NO. K-2801	
C	5-31-77					FOR FABRICATION, SPEC. K-2911	
D	01-31-80					FOR MISC. REV. ECN NO. G-777 & CONSTRUCTION, SPEC. NO. K-2999	
E	12-29-80					MISC. REV. FOR CONSTRUCTION, SPEC. K-2999	
F	04-07-81					REV. PER ECN NO. PN00035 T.MISC. CONST. SPEC. K-2999	

NUCLEAR SAFETY RELATED EQUIPMENT IS SHOWN ON THIS DRAWING.
FOR SAFETY CLASSIFICATION SEE EQUIPMENT, VALVE, OR INSTRUMENT LISTS.)

SCHEMATIC DIAGRAM
STANDBY GAS TREATMENT SYSTEM (VG)
MISCELLANEOUS ALARMS

PART 1
CLINTON POWER STATION UNIT 1
ILLINOIS POWER COMPANY
CLINTON, ILLINOIS

SARGENT & LUNDY
ENGINEERS
CHICAGO

DRAWING NO. E02-0V699
REV. F
SHEET 013 OF 013

R:DS

8107160352

