


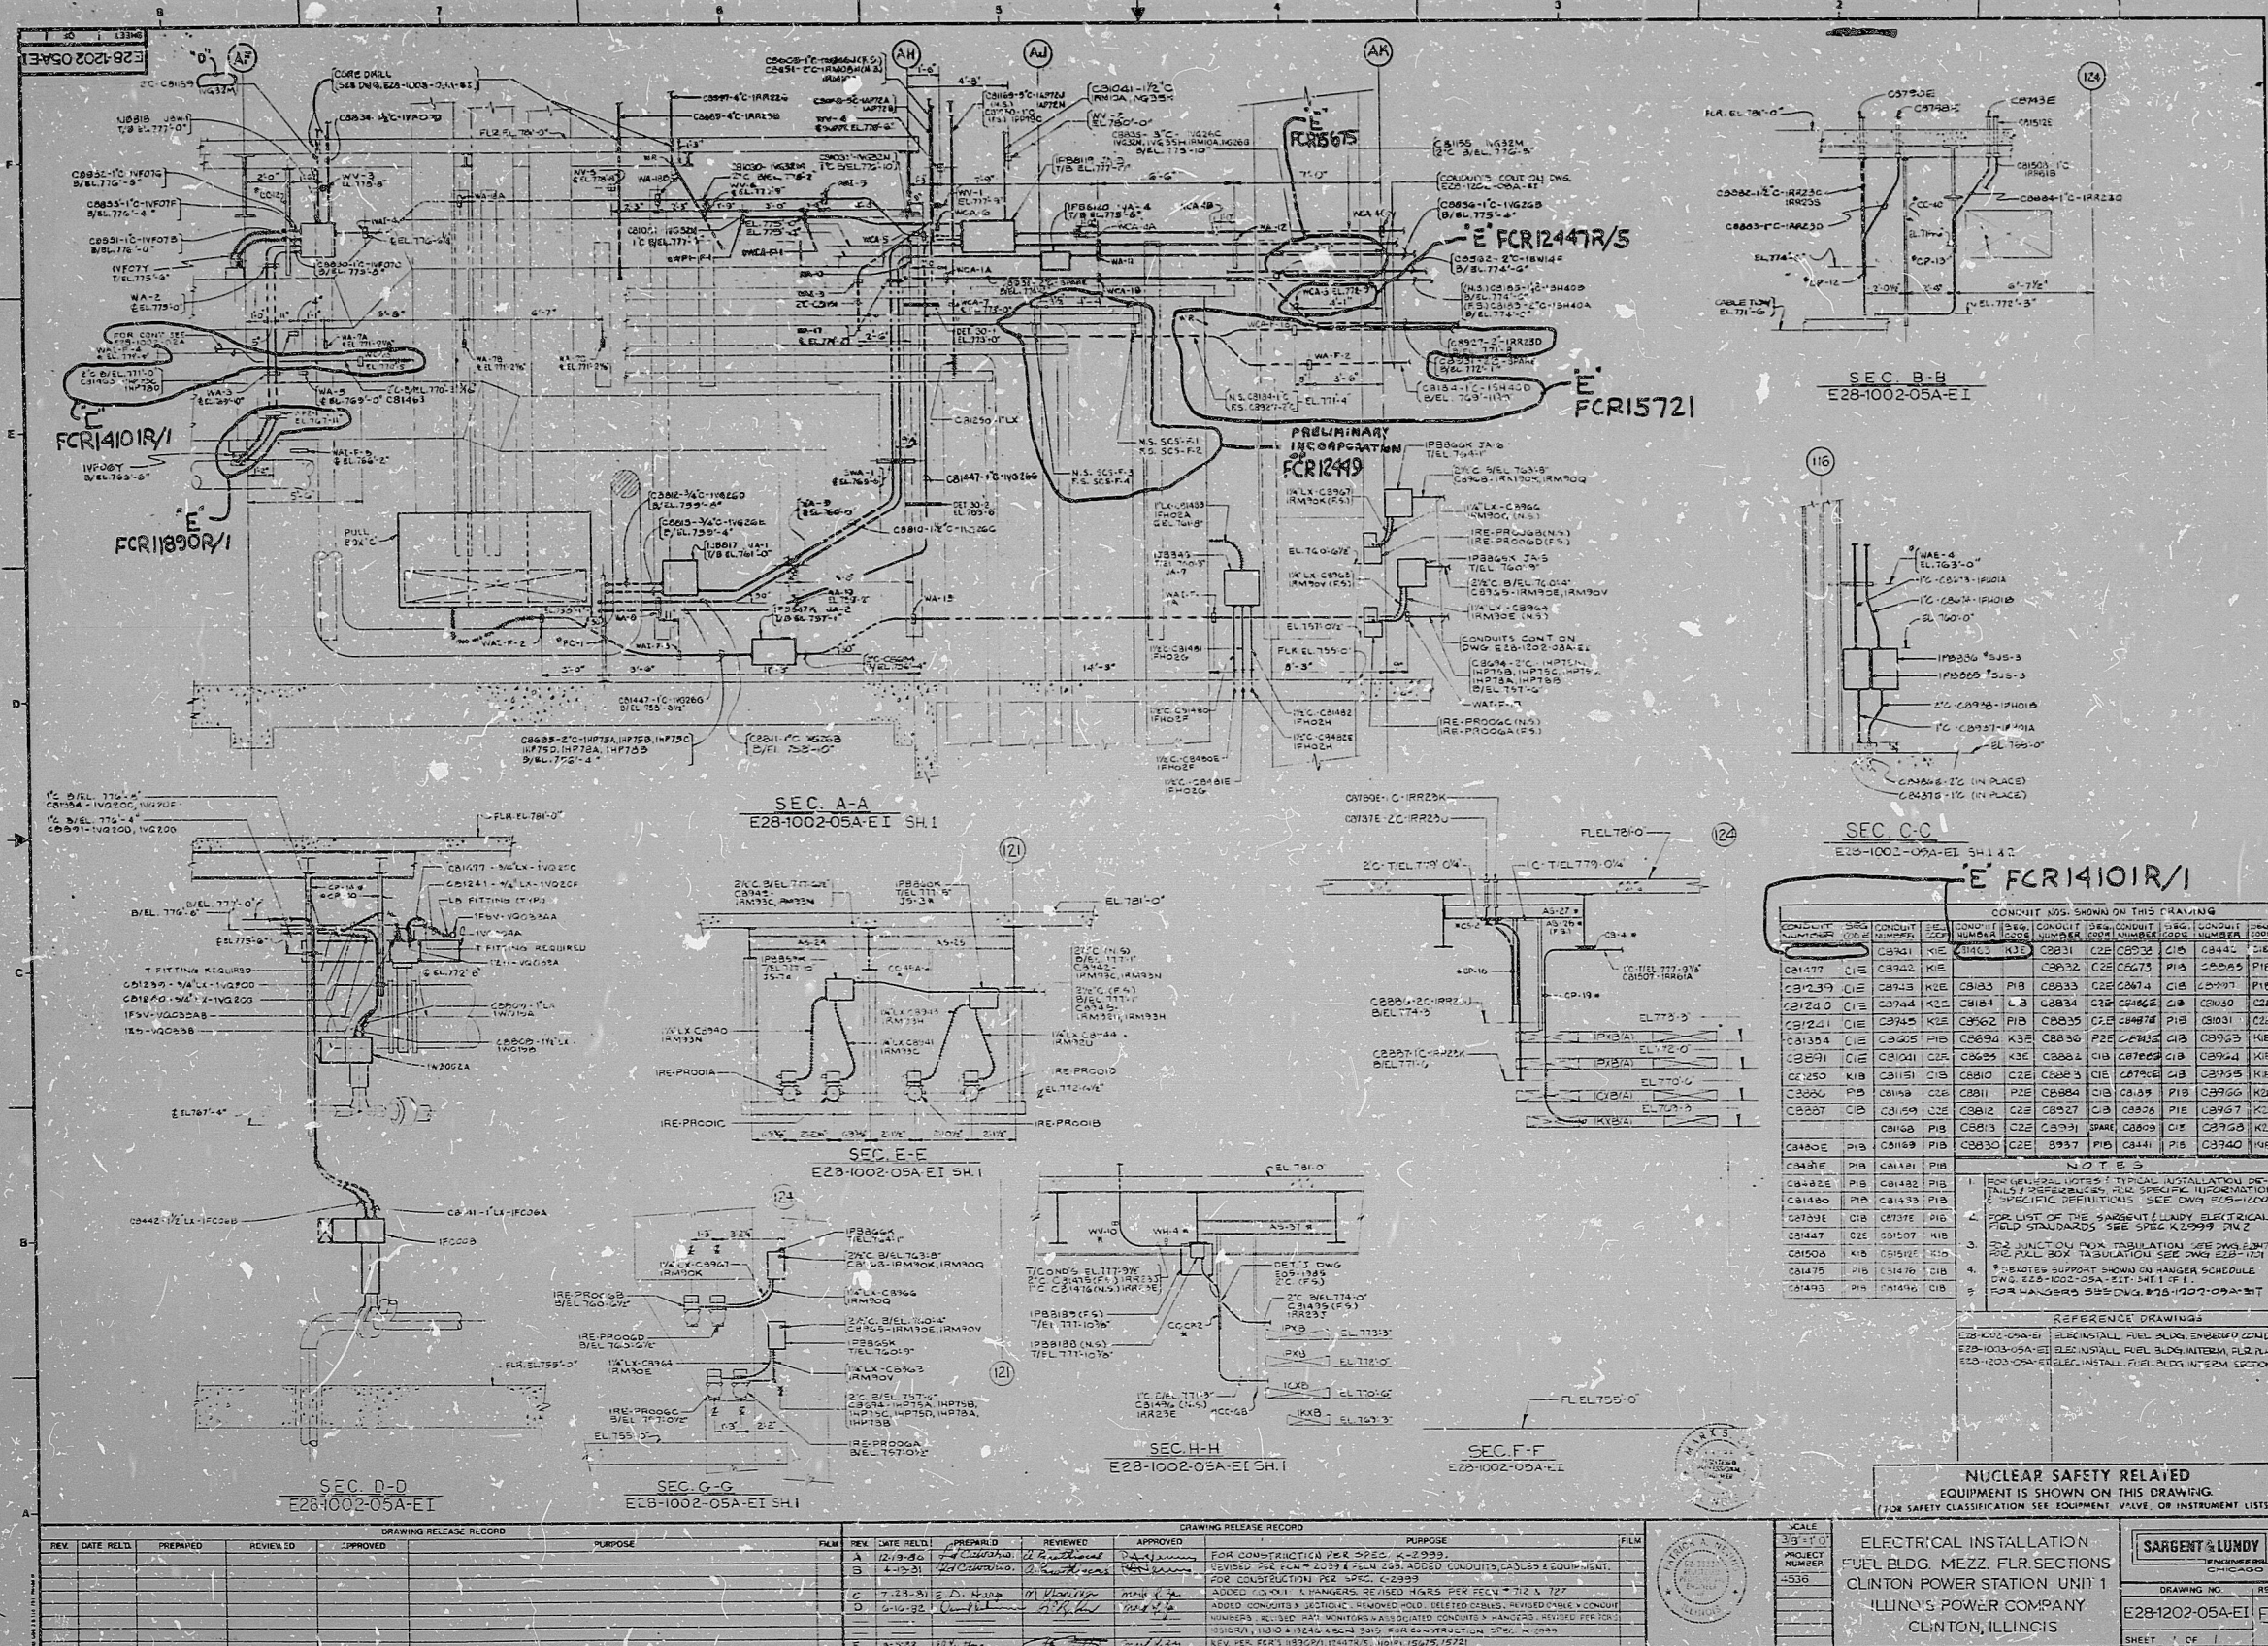

APERTURE
CARD

RIDS

8301110414

