
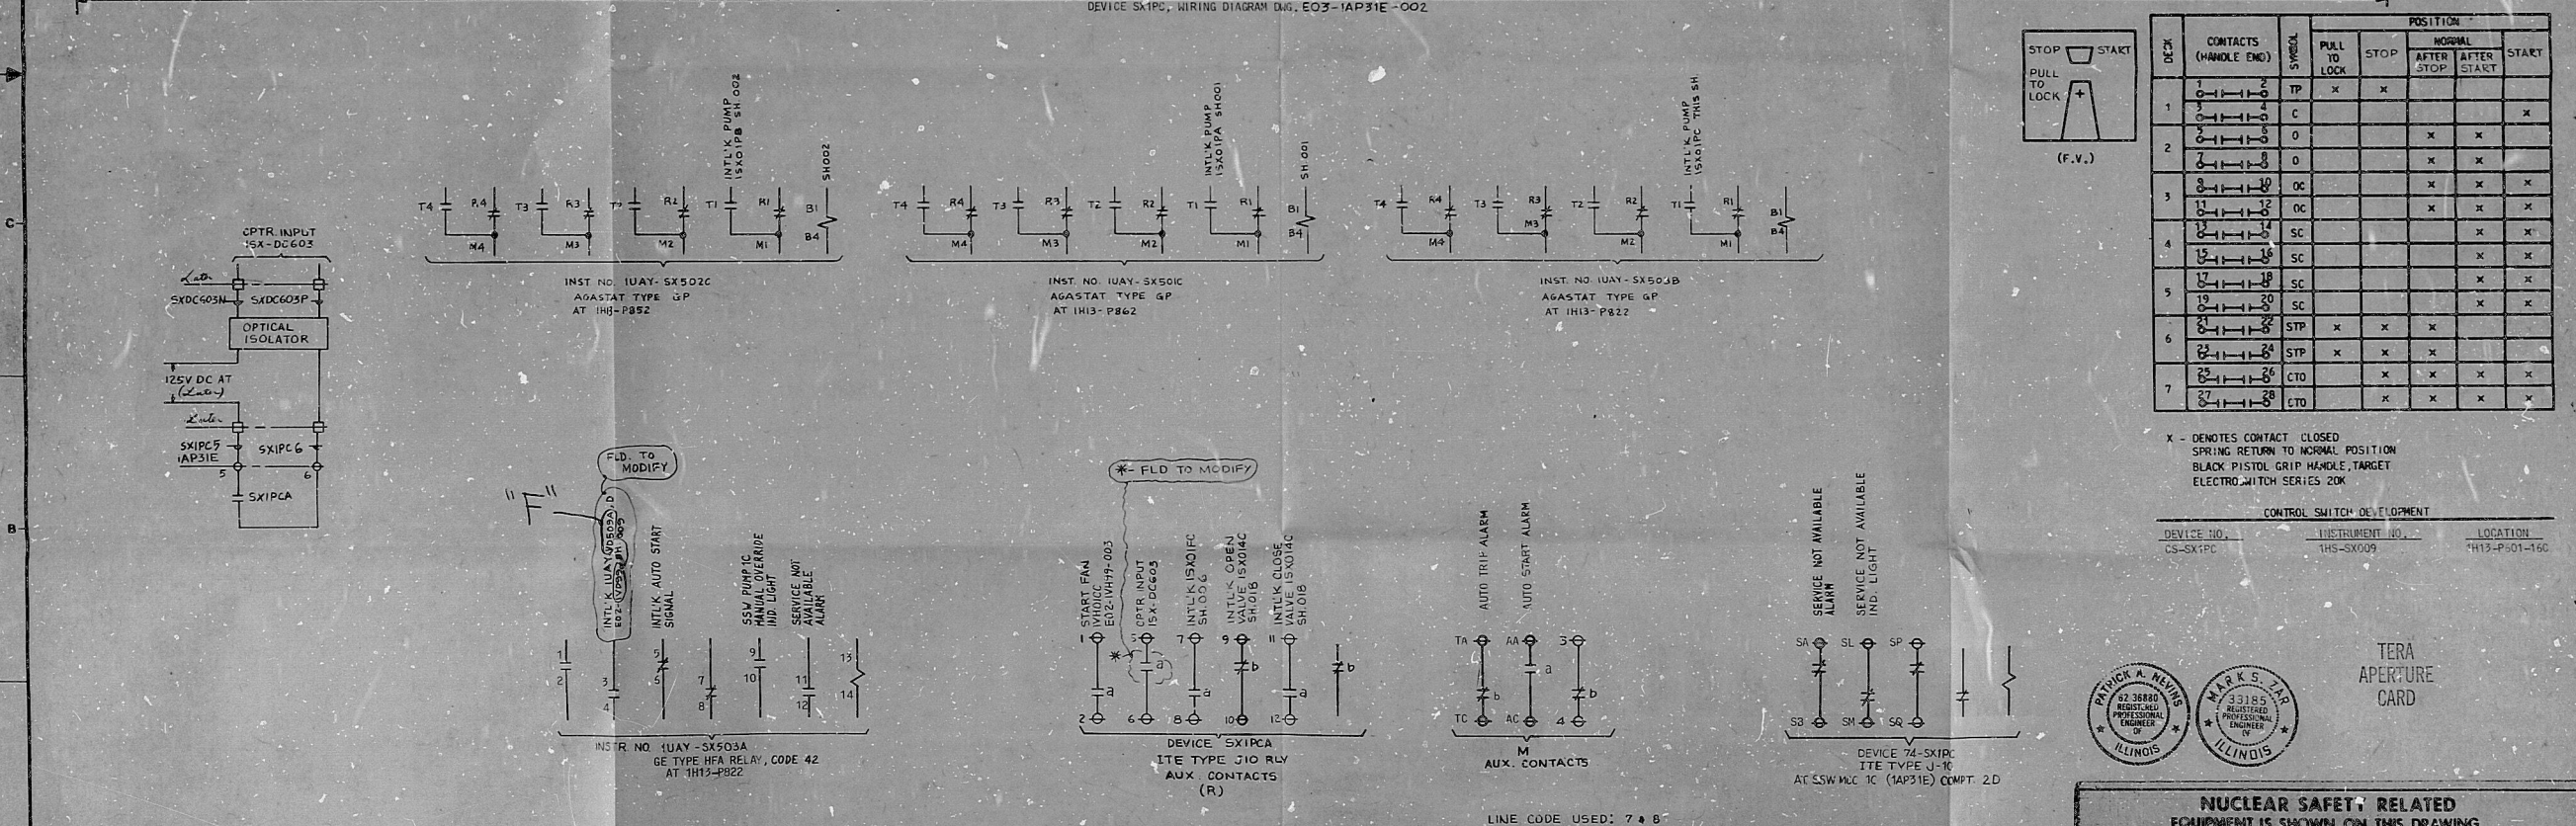


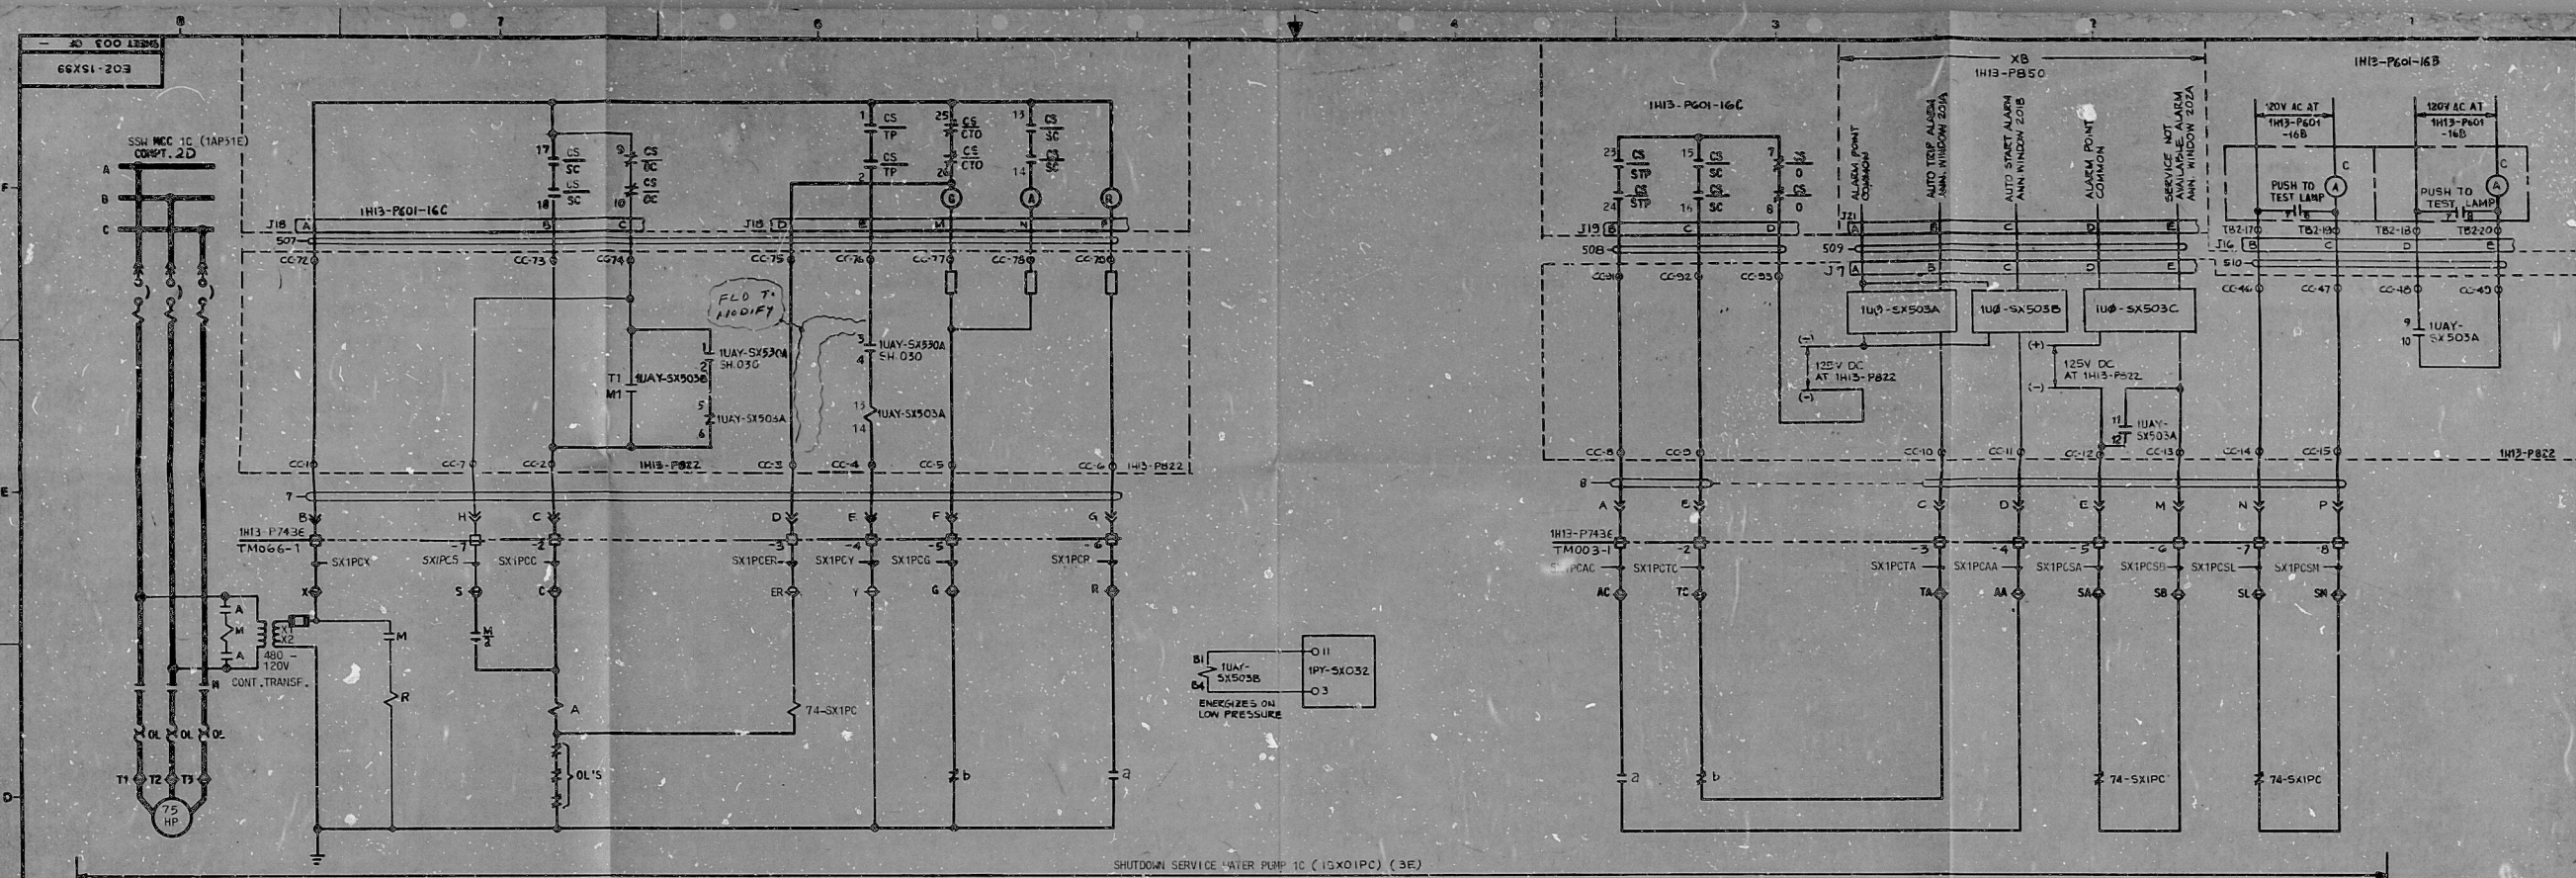

DECK	CONTACTS (HANDLE END)	SWITCH	PULL TO LOCK	POSITION		
				STOP	NORMAL AFTER STOP	START

X - DENOTES CONTACT CLOSED
SPRING RETURN TO NORMAL POSITION
BLACK PISTOL GRIP HANDLE, TARGET
ELECTRO-MATCH SERIES 20K

CONTROL SWITCH DEVELOPMENT

DEVICE NO.	INSTRUMENT NO.	LOCATION
CS-SX1PC	1HS-SX009	1H13-P601-16C

TERA APERTURE CARD



REV.	DATE	RECD.	PREPARED	REVIEWED	APPROVED	PURPOSE	FILM
A	7-27-77					FOR PULL FABRICATION ONLY, SPEC. NO. K-2801	
B	9-9-77					REVISED PER SITS/FITS & ENGR. COMMENTS, SPEC. NO. K-2801	
C	7-28-78					FOR CONSTRUCTION, SPEC. NO. K-2999	
D	9-28-79					MISC. REV. FOR CONSTRUCTION, SPEC. NO. K-2999	
E	1-10-81					REVISED FOR CONSTRUCTION, SPEC. NO. K-2999	
F	4-3-81						


LINE CODE USED: 7 & 8

FOR NOTES & REFERENCE DWS, SEE SH-004

SCALE: NONE

PROJECT NUMBER: 4556

SCHEMATIC DIAGRAM

SHUTDOWN SERVICE WATER SYS. (SX)

SHUTDOWN SERVICE WATER PUMP 1C

CLINTON POWER STATION UNIT 1

ILLINOIS POWER COMPANY

CLINTON, ILLINOIS

SARGENT & LUNDY

DRAWING NO. E02-15X99

SHEET 003 OF 01

RIDS

8107160505

