



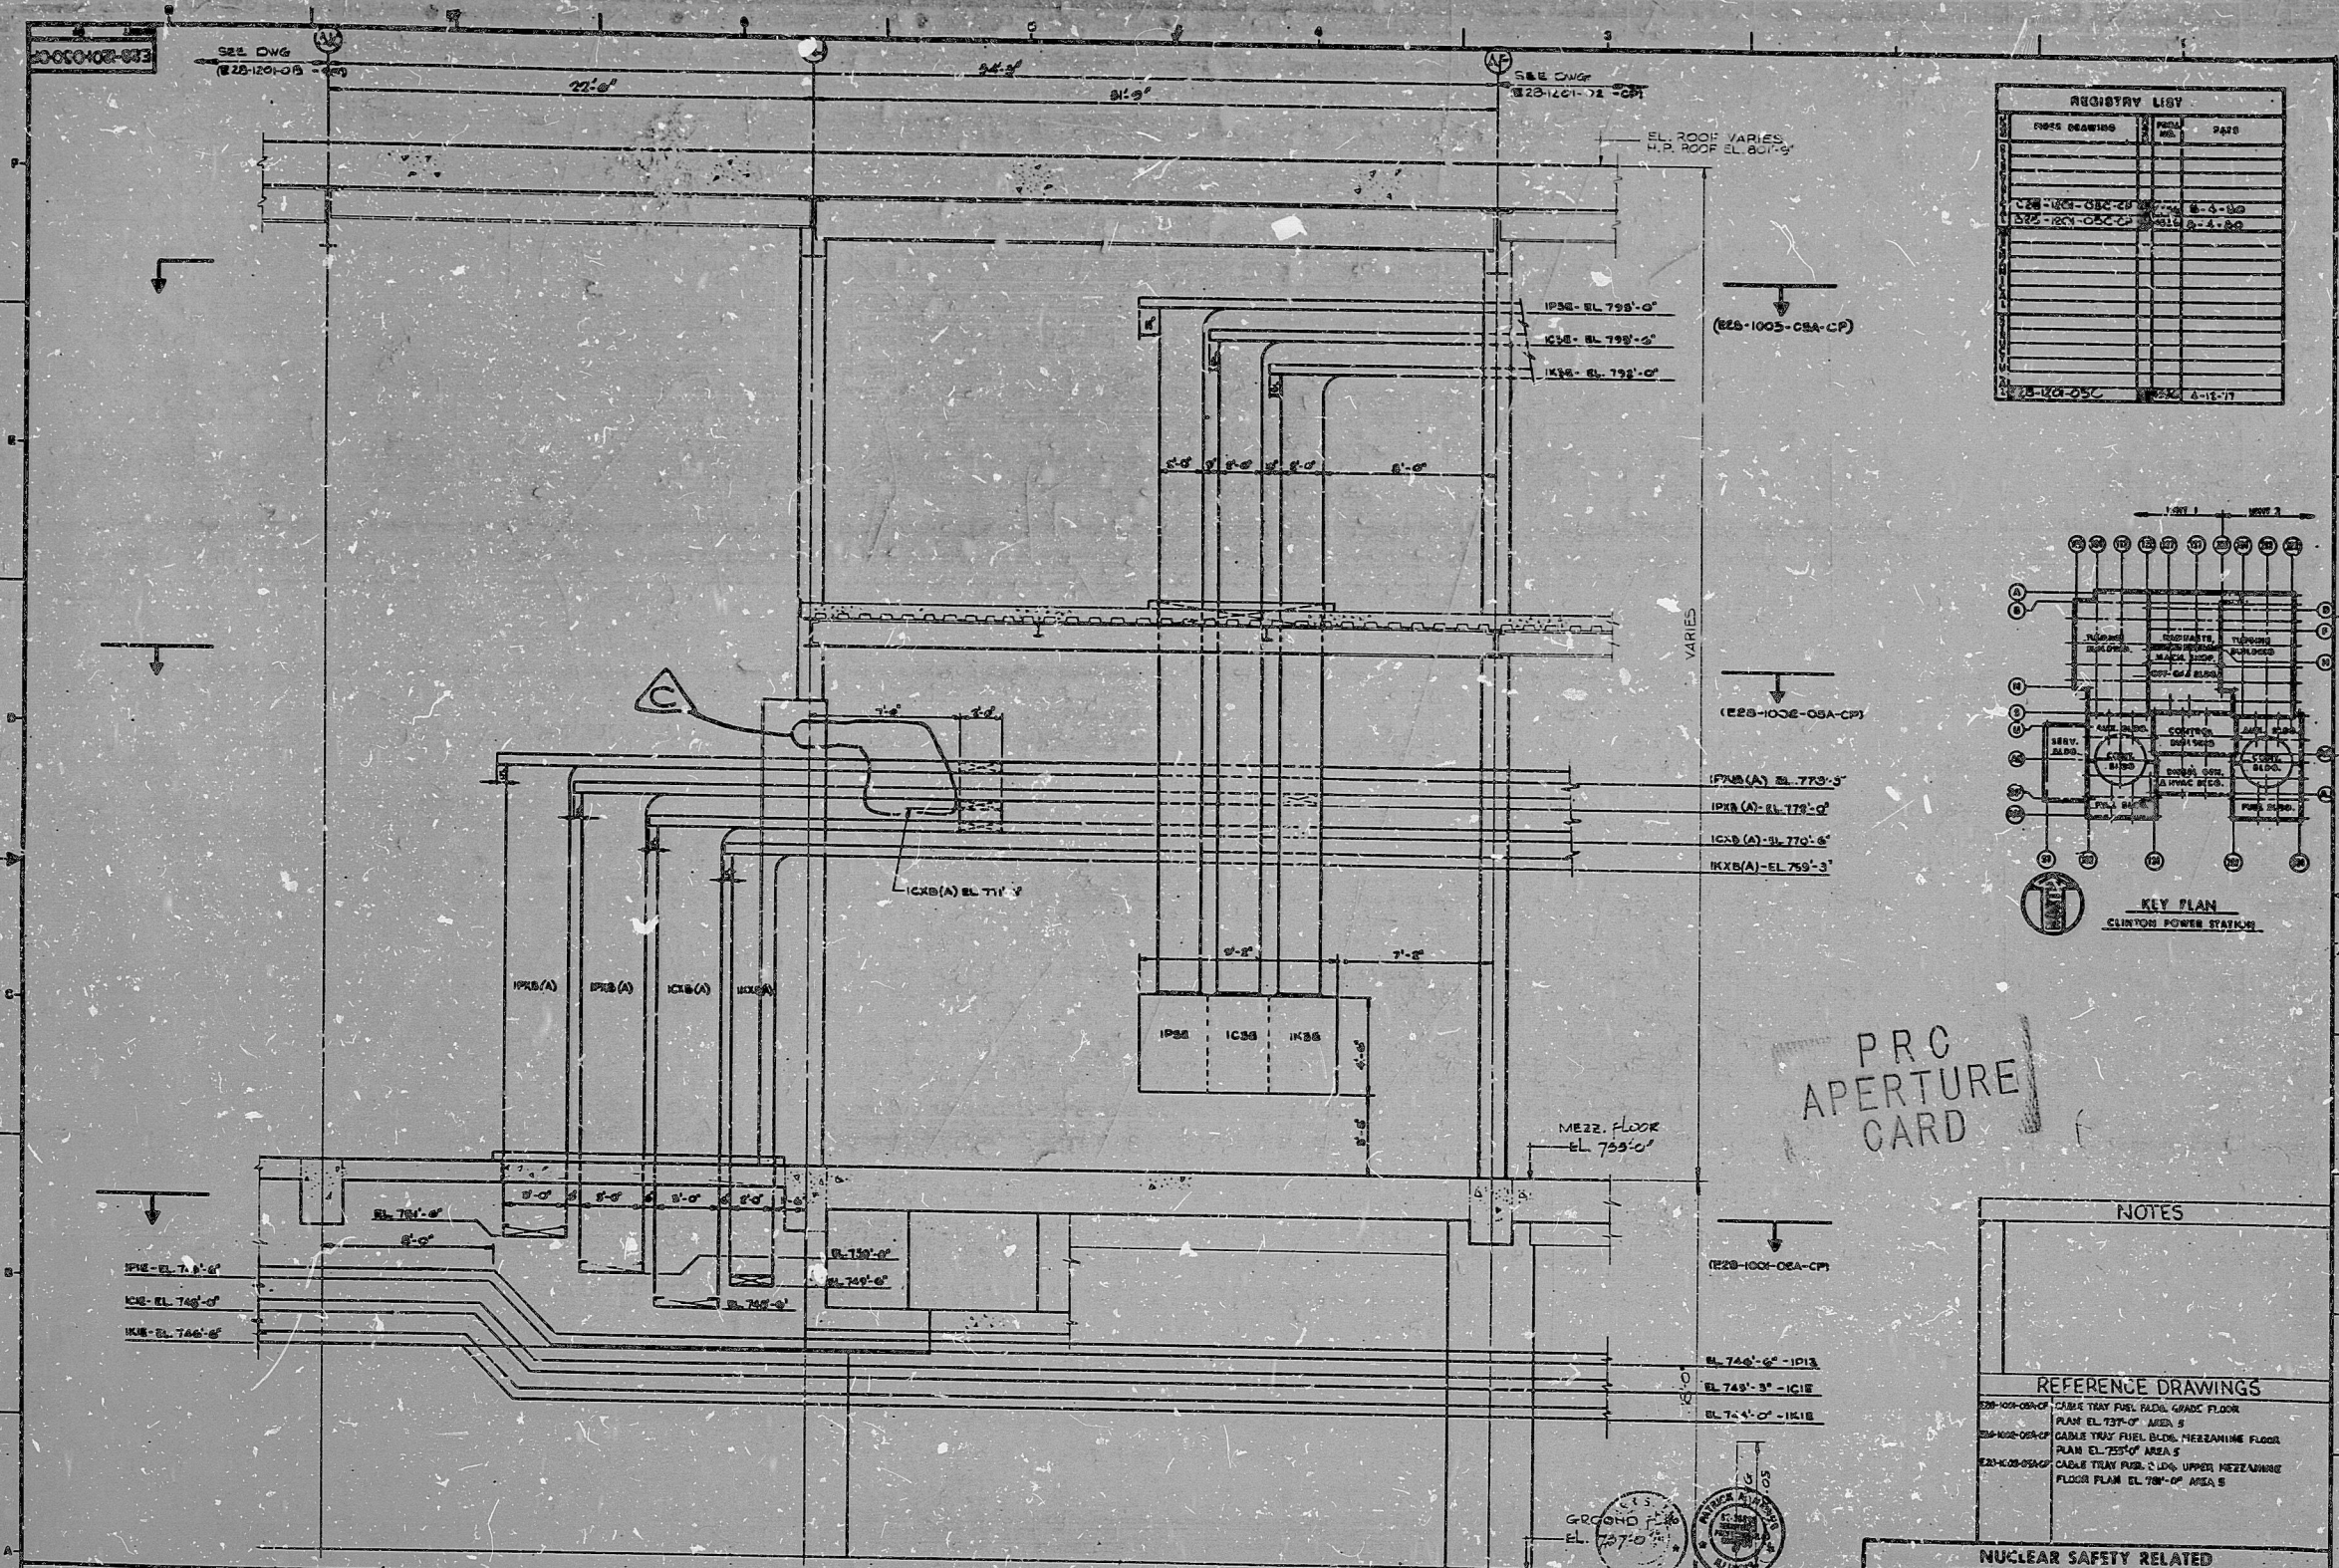

REGISTRY LIST		
FILE NUMBER	DATE	REVISION
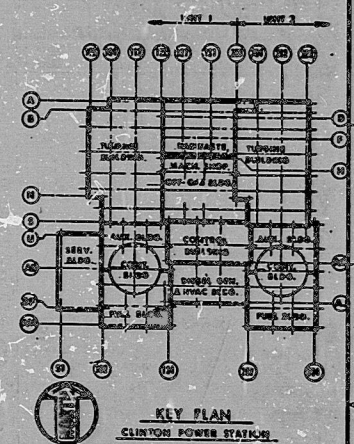

PRC
APERTURE
CARD

NOTES	
REFERENCE DRAWINGS	

DRAWING RELEASE RECORD									
NUCLEAR SAFETY RELATED
EQUIPMENT IS SHOWN ON THIS DRAWING
(FOR SAFETY CLASSIFICATION SEE EQUIPMENT, VARIOUS, OR EQUIPMENT LIST.)

CABLE TRAY - FUEL BLDG
SEC 10-00
AREA 5 - UPPER
CLINTON POWER STATION UNIT 1
CLINTON, ILLINOIS

128-1005-050-CP

RIDS

8301110492

