


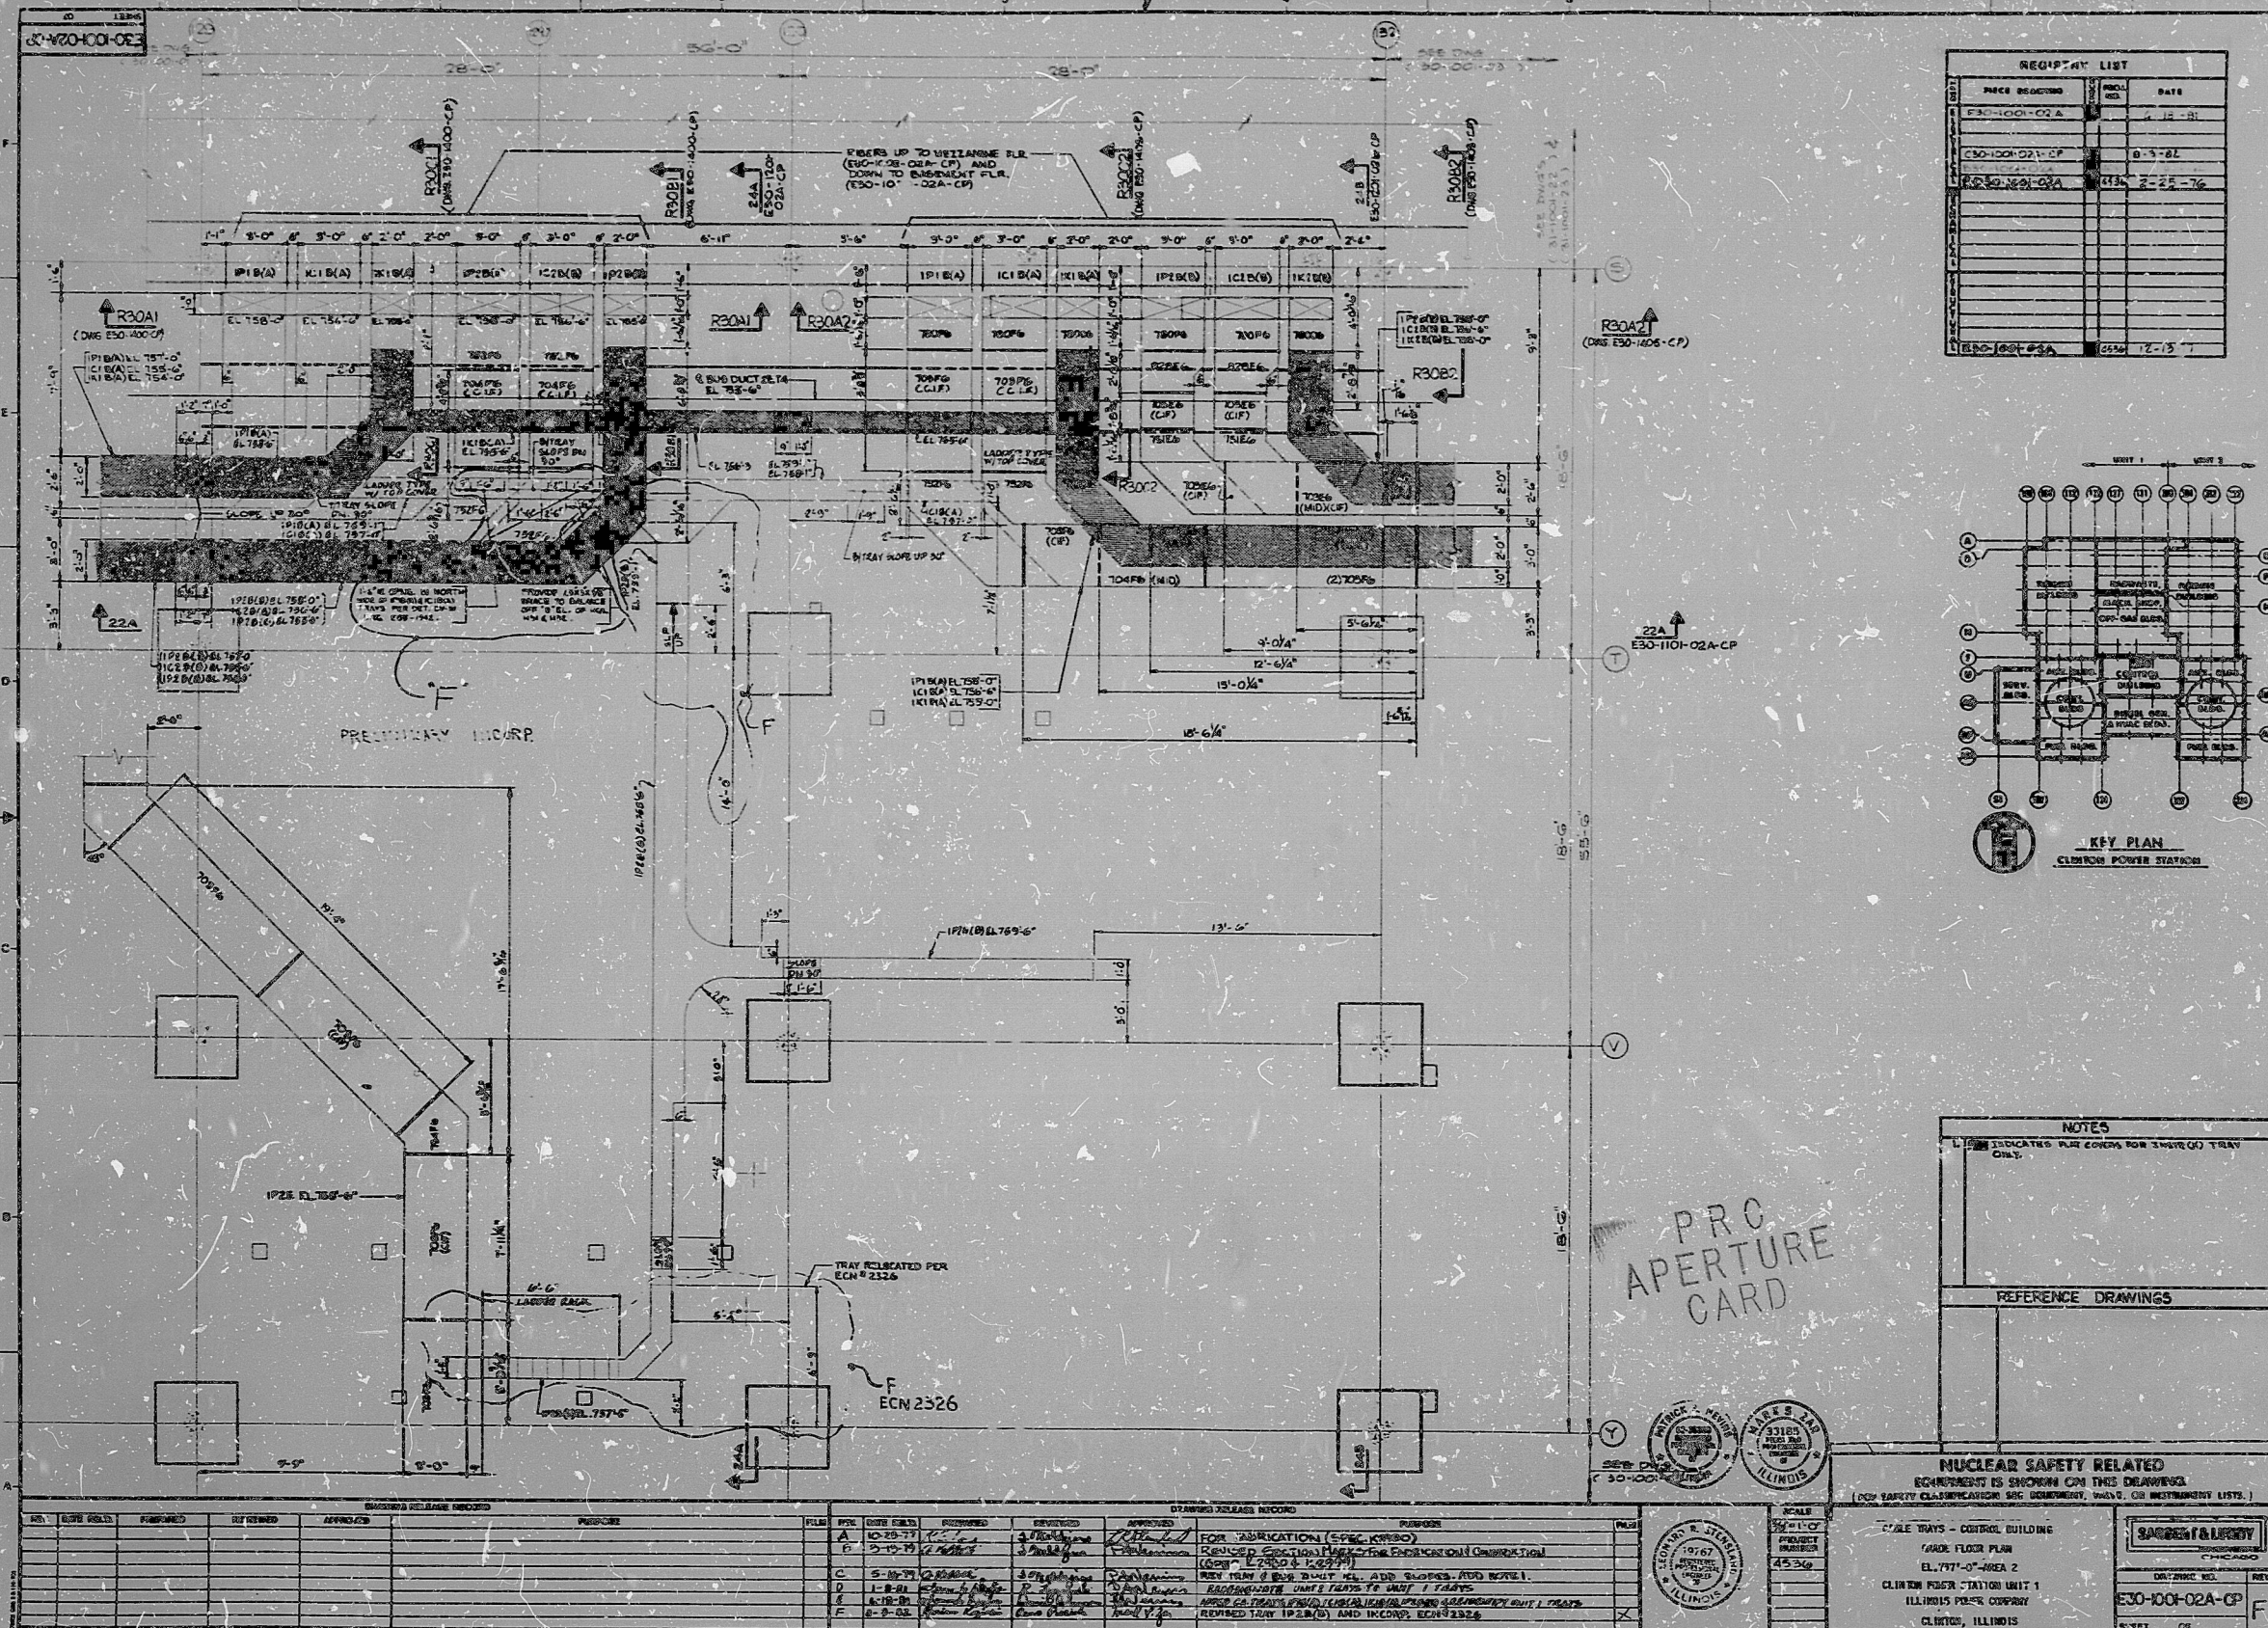



RIDS

8301120018

