


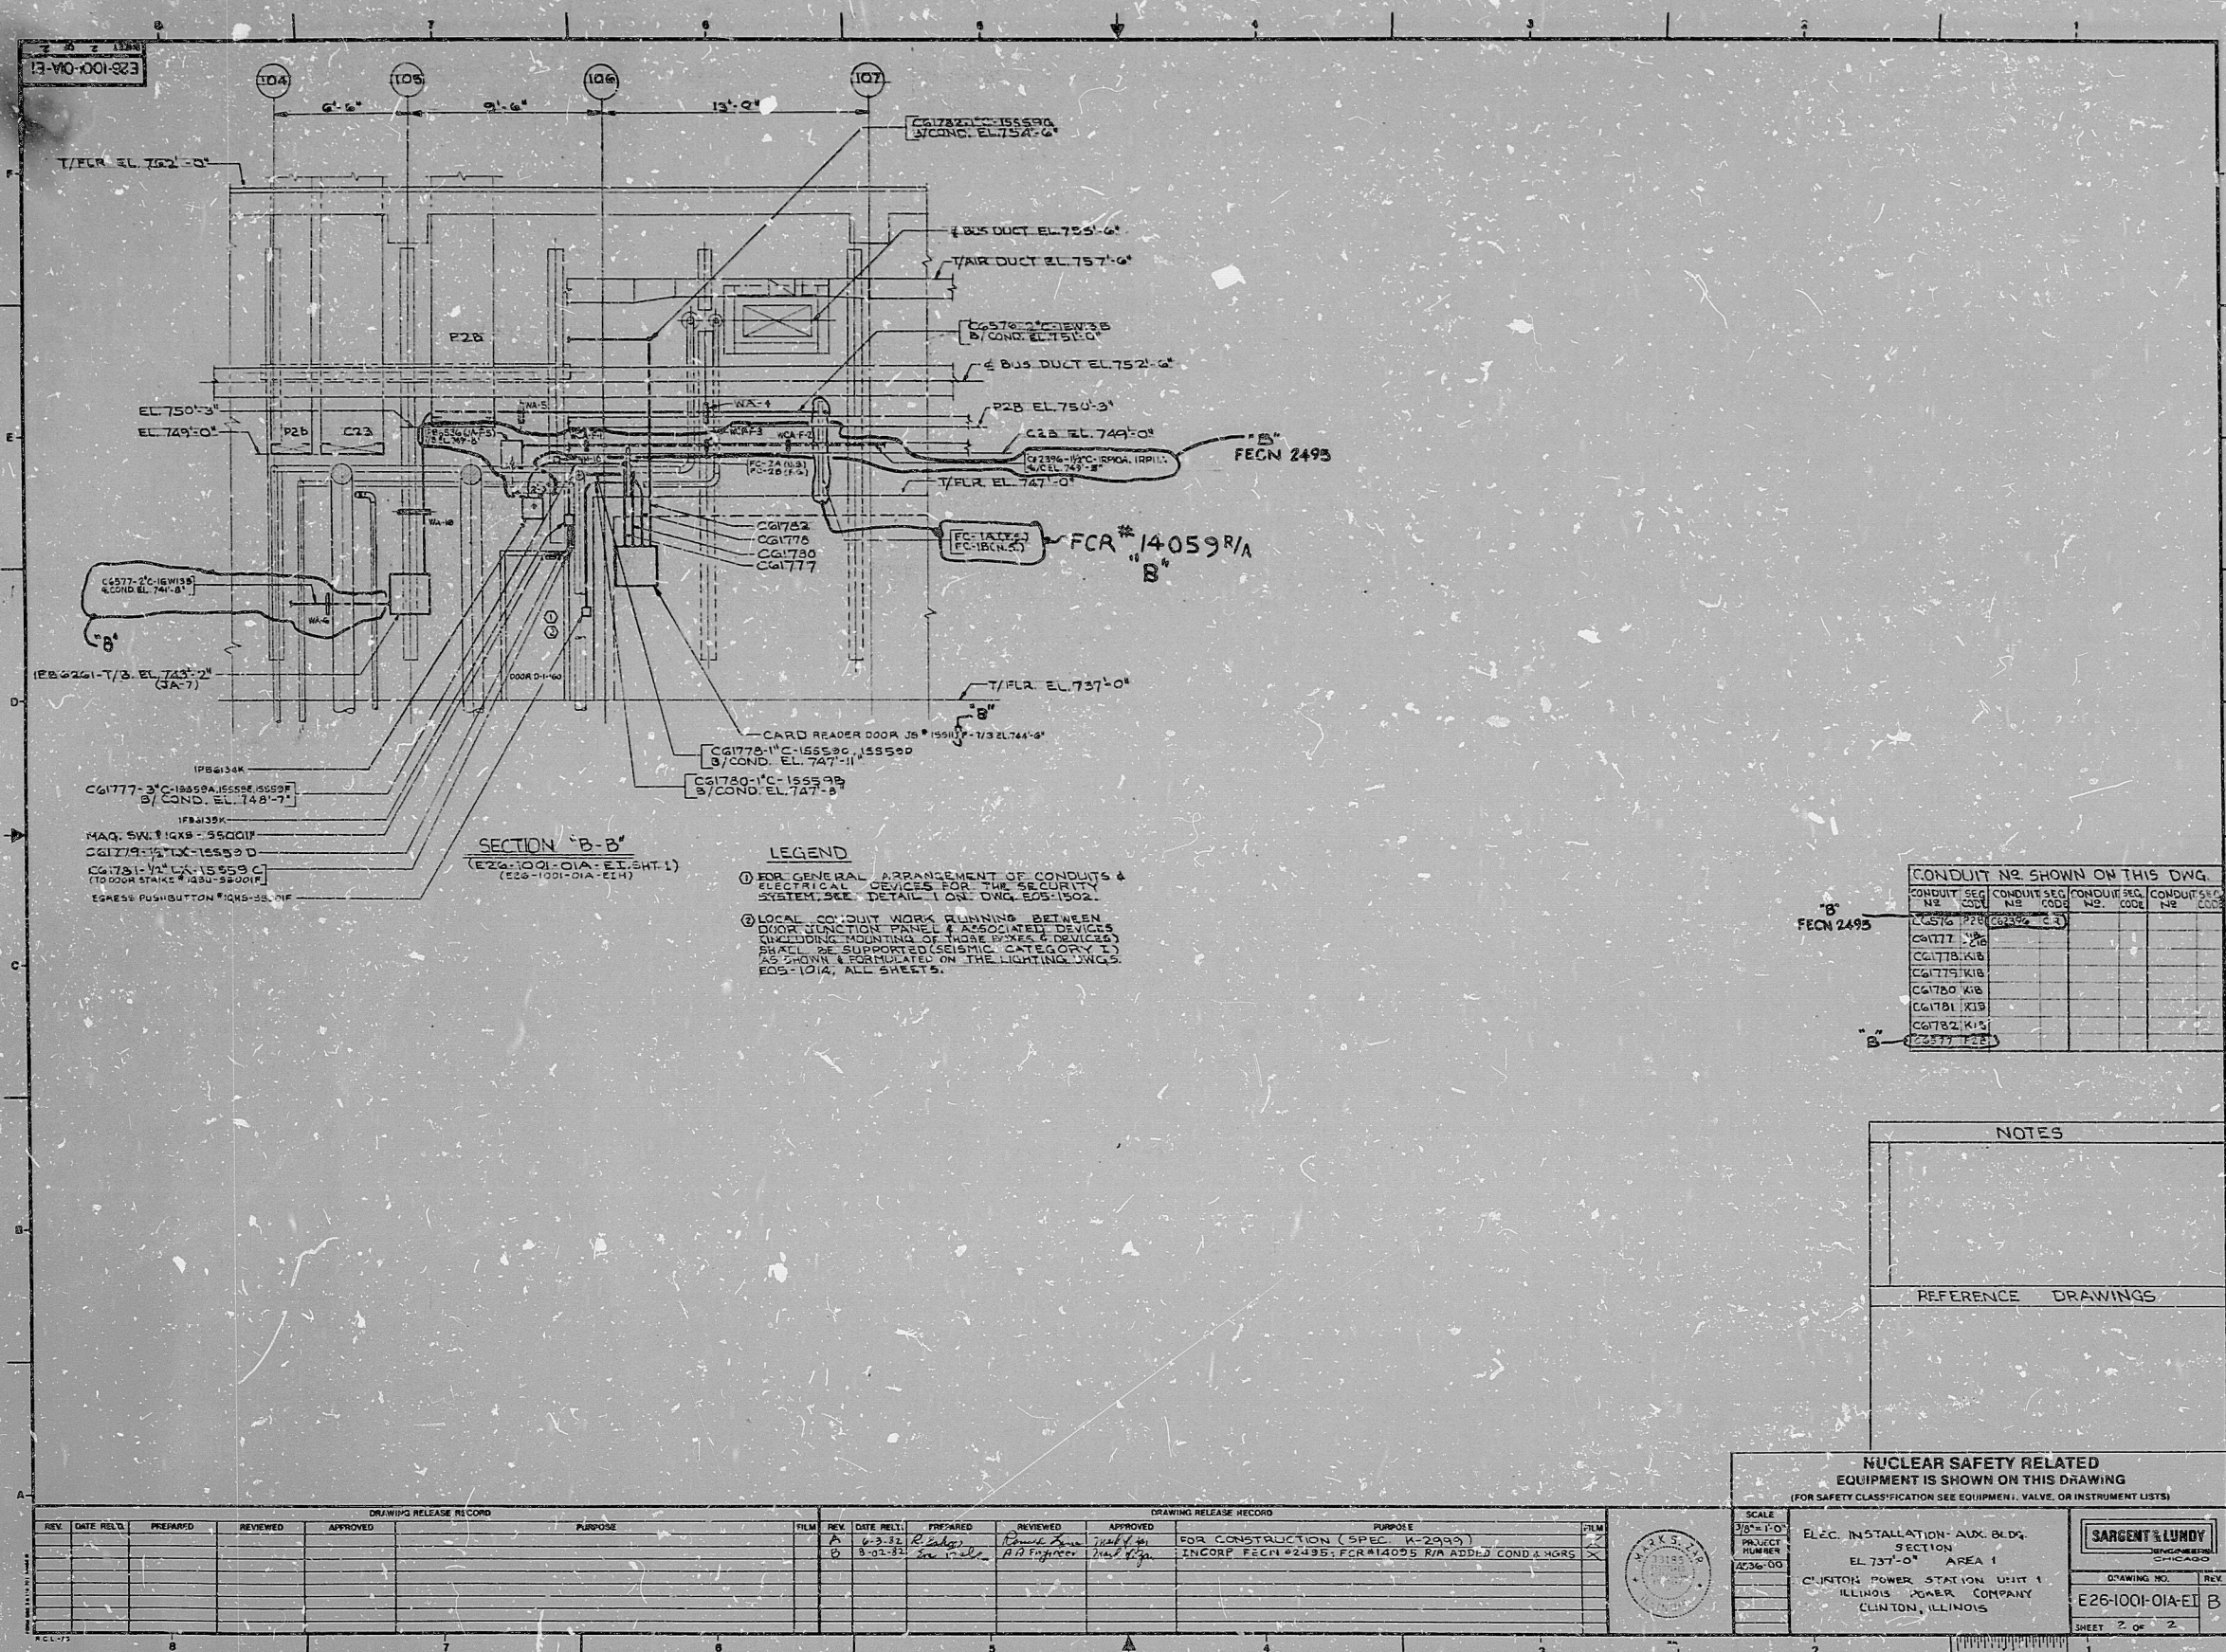

RIDS

8301120093

