
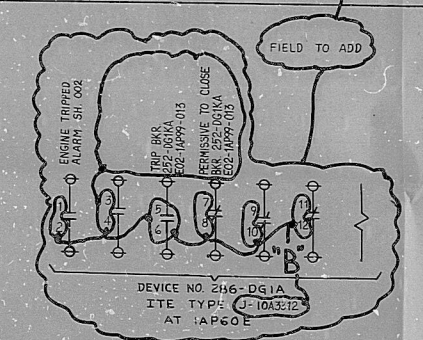


[illegible]

STEWART & STEVENSON SERVICES P. O. BOX 1637 HOUSTON, TEXAS, U.S.A.			
TITLE CLIXTON POWER STATION UNIT NO.1			
D.C. SCHEMATIC			
3875 KW, 4160V, 3Ø, 60 HZ, 8 PF.			
EMERGENCY DIESEL GENERATOR			
REV.	DATE	BY	APP.
D	8/31/81	61092	B
		SH. 0C3	
			
DRAWING NO.		REV.	
EQ2-10699		B	
POWER COMPANY		B	
MILWAUKEE			

RIDS

810770028

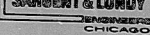