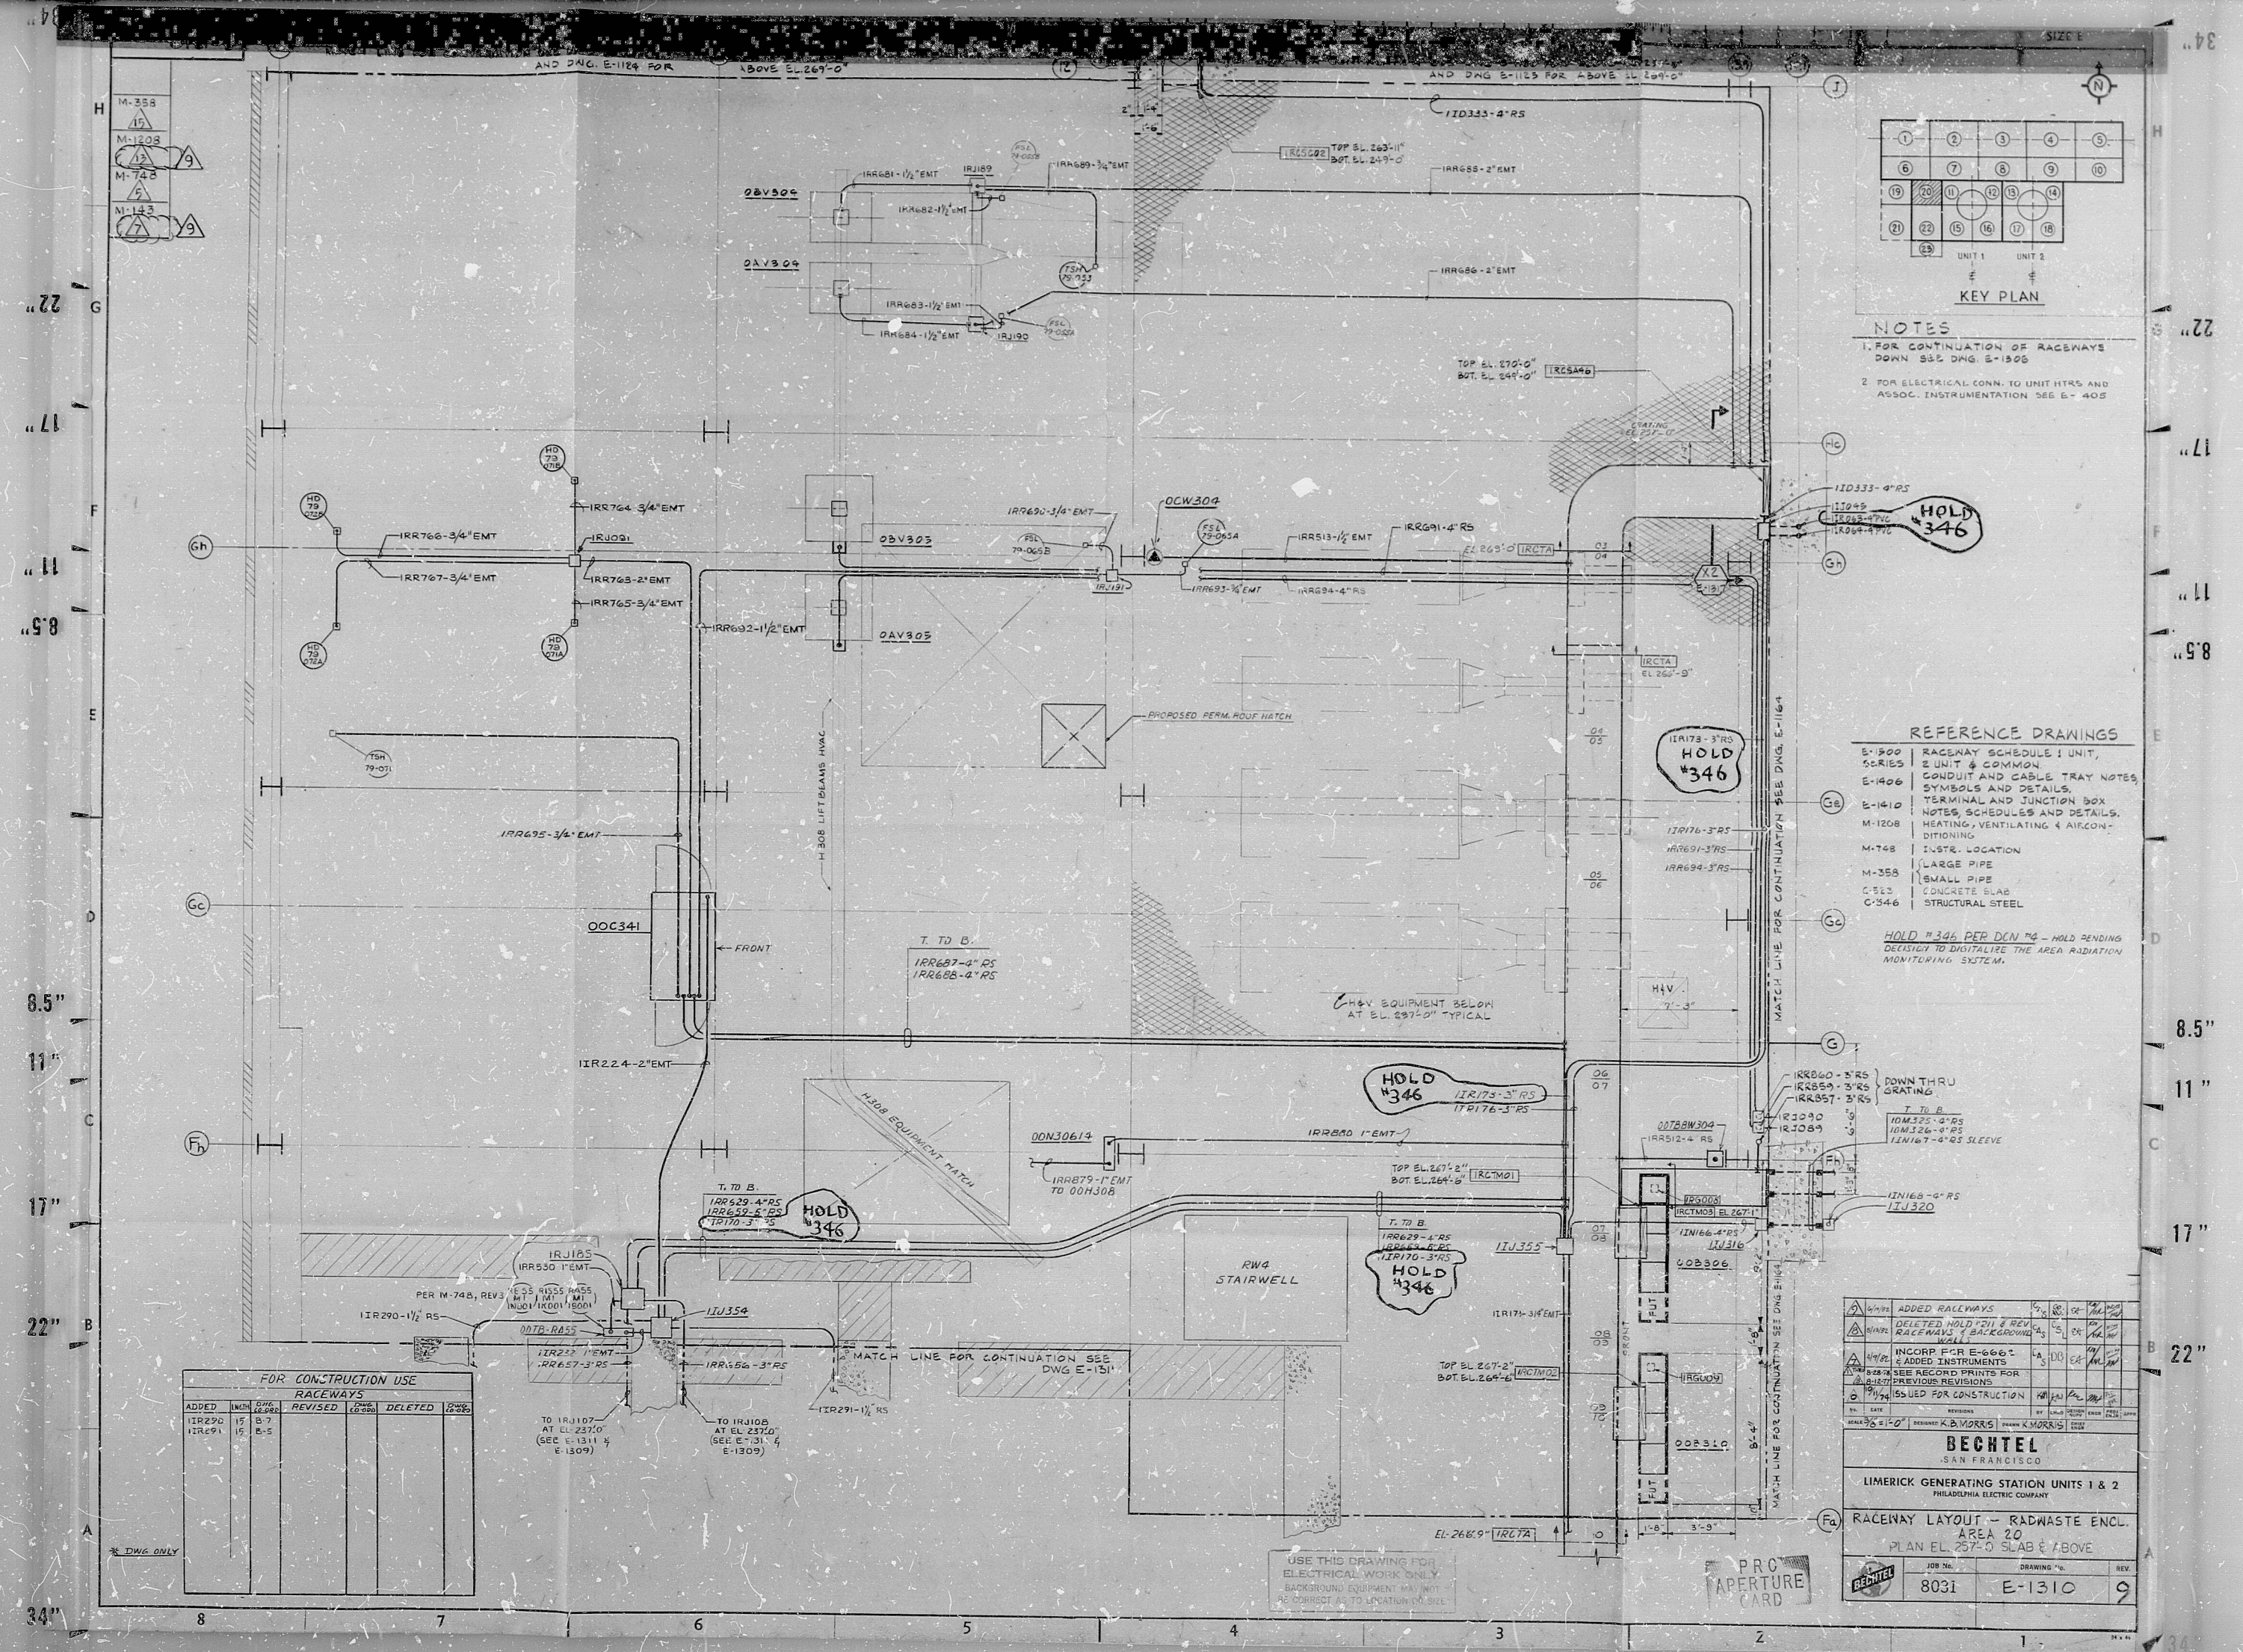


NOTES

1. FOR CONTINUATION OF RACEWAYS DOWN SEE DWG. E-1308

2. FOR ELECTRICAL CONN. TO UNIT HTS AND ASSOC. INSTRUMENTATION SEE E-405

REFERENCE DRAWINGS

E-1300 RACEWAY SCHEDULE: UNIT, 2 UNIT & COMMON

E-1406 CONDUIT AND CABLE TRAY NOTES, SYMBOLS AND DETAILS

E-1410 TERMINAL AND JUNCTION BOX NOTES, SCHEDULES AND DETAILS

M-1208 HEATING, VENTILATING & AIR CONDITIONING

M-748 INSTR. LOCATION

M-358 LARGE PIPE



C-346 STRUCTURAL STEEL

HOLD #346 PER DCN #4 - HOLD PENDING DECISION TO DIGITALIZE THE AREA RADIATION MONITORING SYSTEM.

FOR CONSTRUCTION USE				
RACEWAYS				
ADDED	REMOVED	REVISED	DELETED	DATE
IRR290	15	B-7		
IRR291	15	B-5		


BECHTEL SAN FRANCISCO		
LIMERICK GENERATING STATION UNITS 1 & 2 PHILADELPHIA ELECTRIC COMPANY		
RACEWAY LAYOUT - RADWASTE ENCL. AREA 20 PLAN EL. 257'-0" SLAB & ABOVE		
JOB NO.	DRAWING NO.	REV.
8031	E-1310	9

USE THIS DRAWING FOR ELECTRICAL WORK ONLY. BACKGROUND EQUIPMENT MAY NOT BE CORRECT AS TO LOCATION OR SIZE.

PRO APERTURE CARD

Rids

8301120615

