
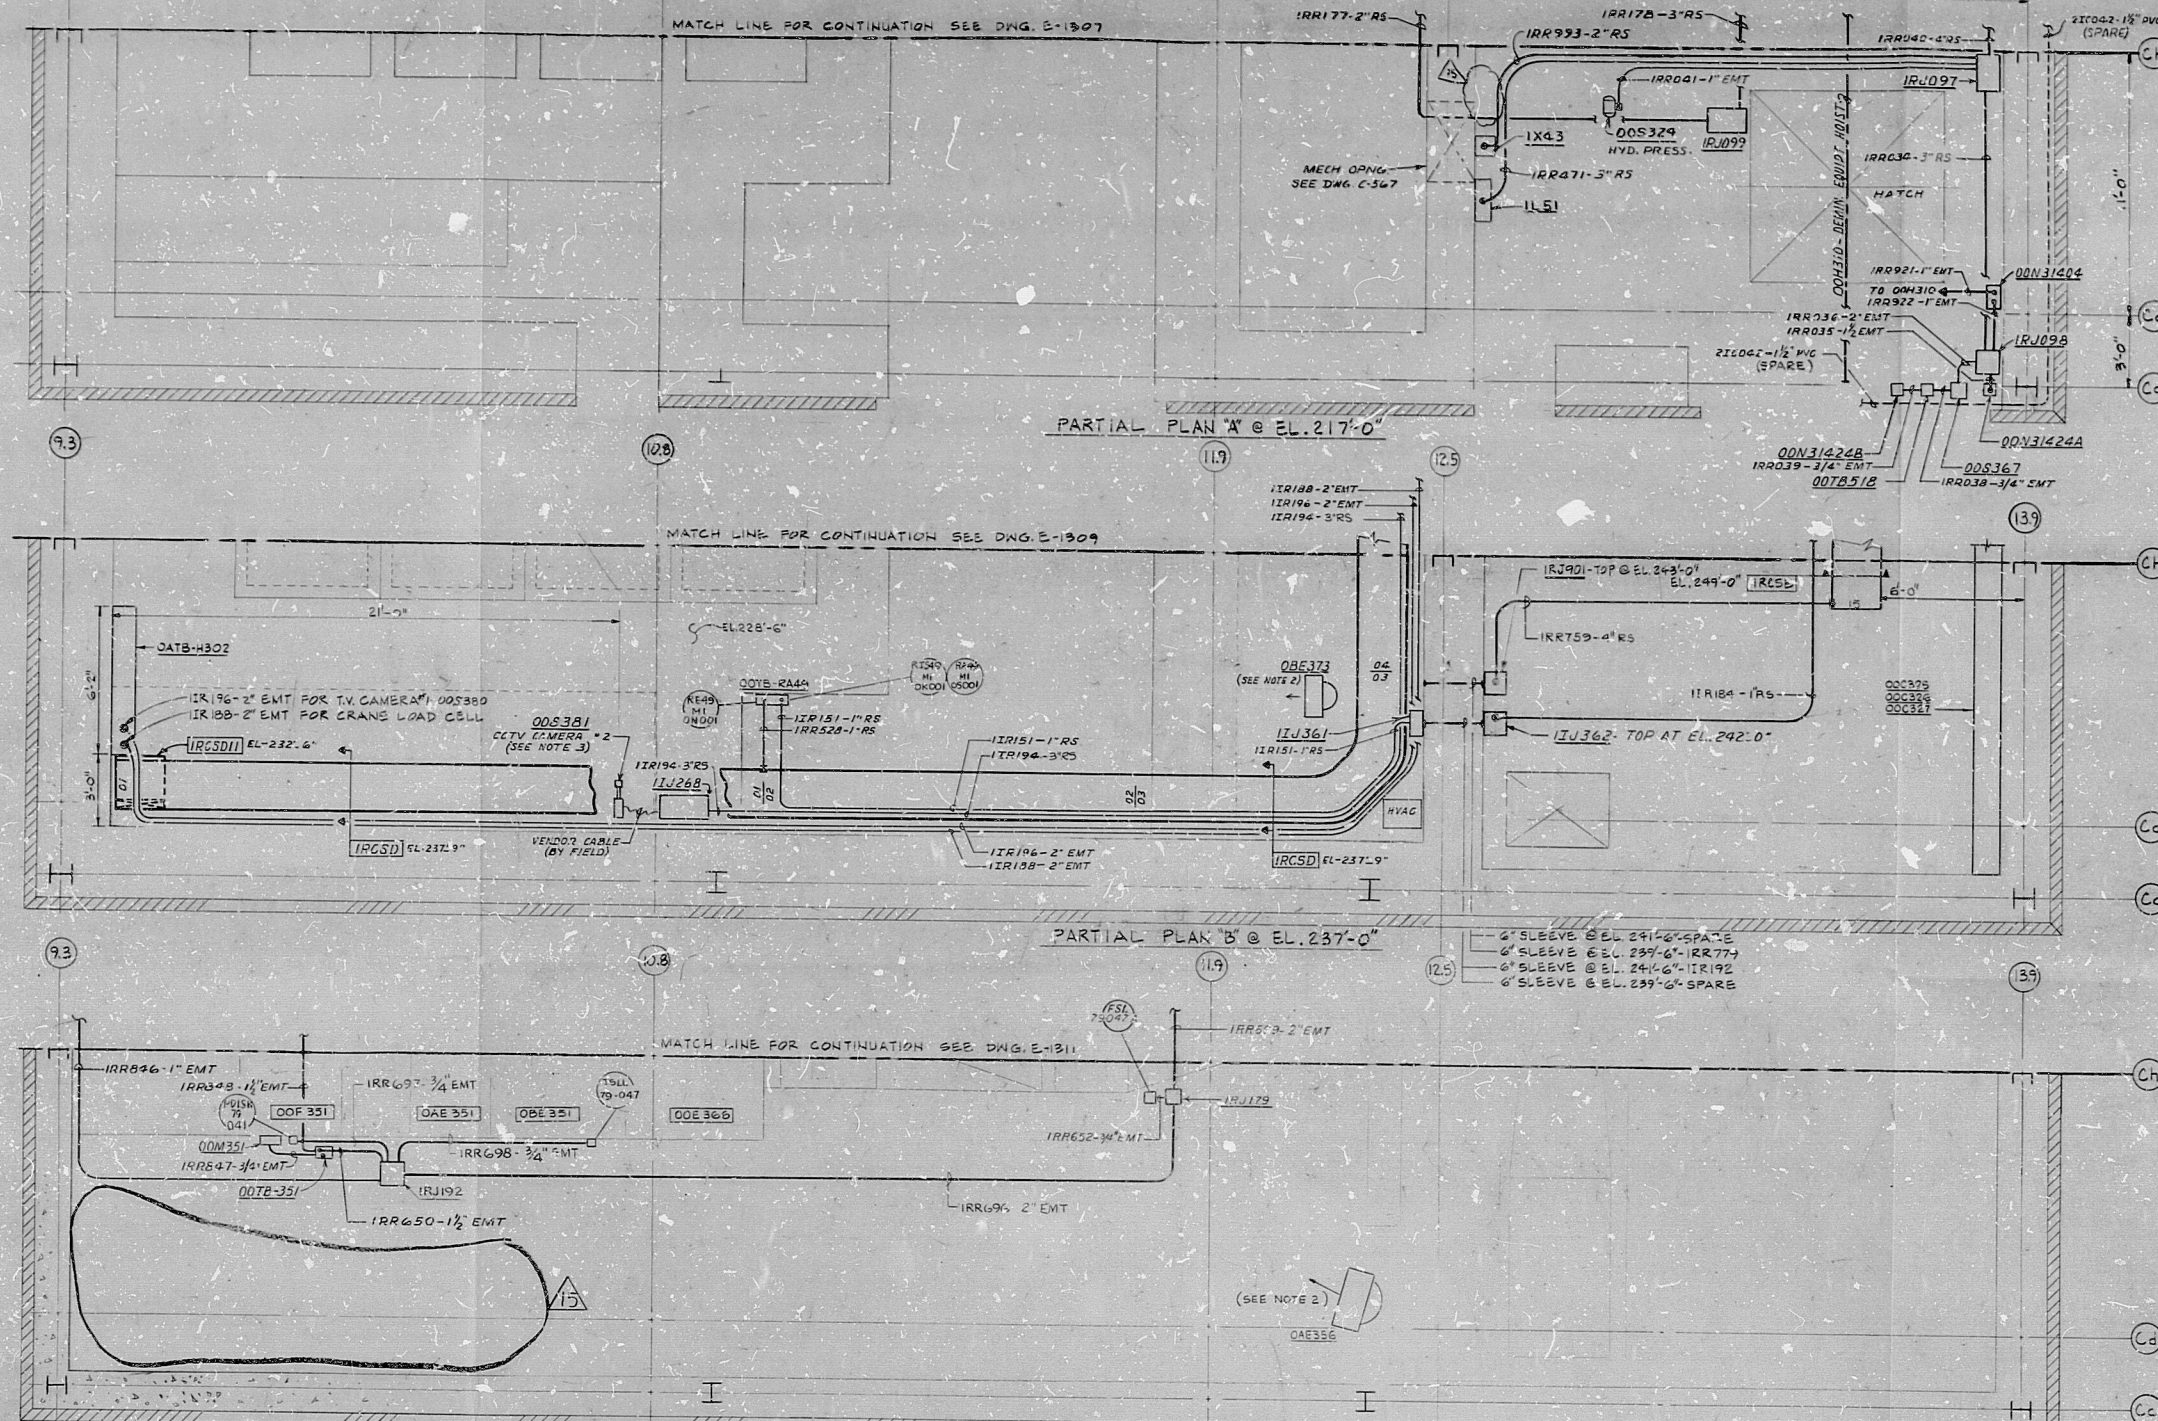


NOTES

- FOR CONTINUATION OF RACEWAYS PARTIAL PLAN 'A' UP SEE PARTIAL PLAN 'B' DOWN SEE DNG. E-1305 PARTIAL PLAN 'B' UP SEE PARTIAL PLAN 'C' DN. SEE PARTIAL PLAN 'A' PARTIAL PLAN 'C' DN. SEE PARTIAL PLAN 'B'
- FOR ELEC. CONN. TO UNIT HRS. & ASSOC. INSTRUMENTATION SEE E-1405 & FOR LAYOUT SEE E-1091.
- CAMERA #2 TO BE MOUNTED OUTSIDE WALL CENTERED ON THE HSA STORAGE BOX AT EL. 236'-0"

REFERENCE DRAWINGS

- E-1500 RACEWAY SCHEDULE UNIT, SERIES 2 UNIT AND COMMON CONDUIT AND CABLE TRAY NOTES, SYMBOLS AND DETAILS
- E-1406 TERMINAL AND JUNCTION BOX NOTES, SCHEDULES AND DETAILS
- E-1410 LIGHTING, RADWASTE ENCL. E-1237/257

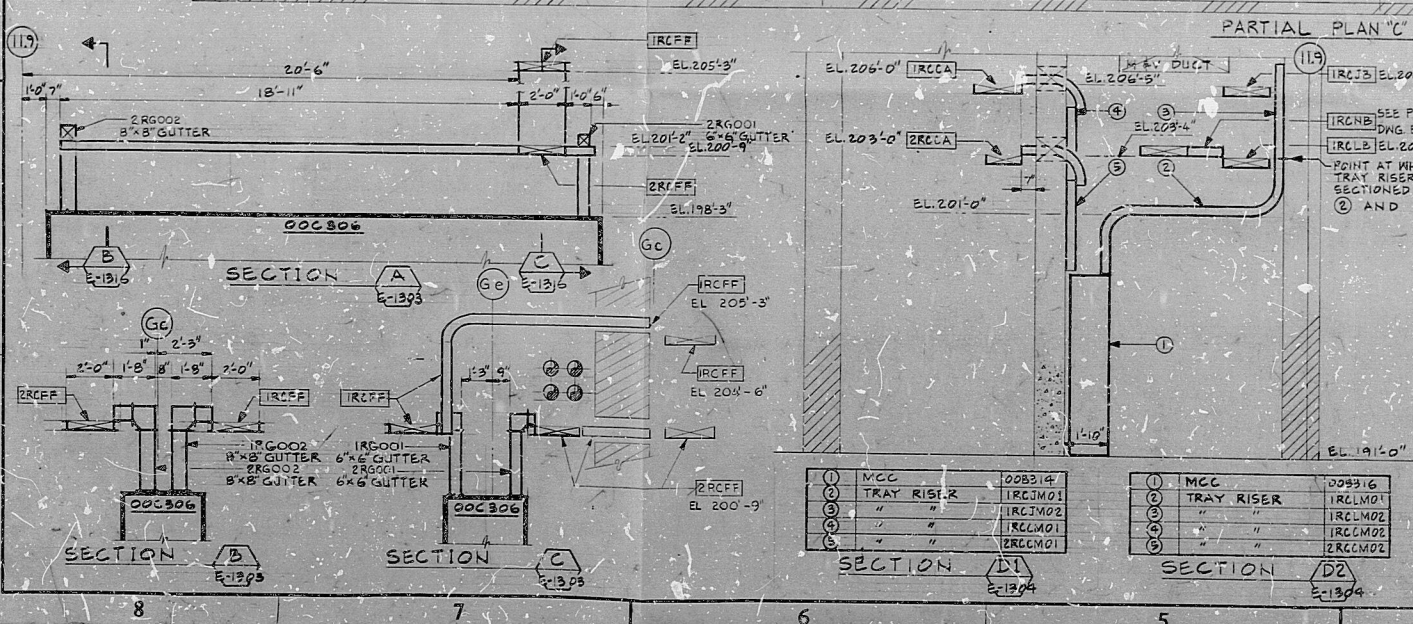

FOR CONSTRUCTION USE

RACEWAYS:			
ADDED	REVISED	DELETED	DATE
IRR177	0-4	IRR446	50 D.S. 1L57
IRR178	0-3		
IRR179	0-3		
IRR193	0-3		

* DNG ONLY



BECHTEL
SAN FRANCISCO

LIMERICK GENERATING STATION UNITS 1 & 2
PHILADELPHIA ELECTRIC COMPANY

RACEWAY LAYOUT - RADWASTE ENCL. MISC. PLANS, DETAILS & SECTIONS
SHEET 1

8051 E-1316

Rids

8301120625

