


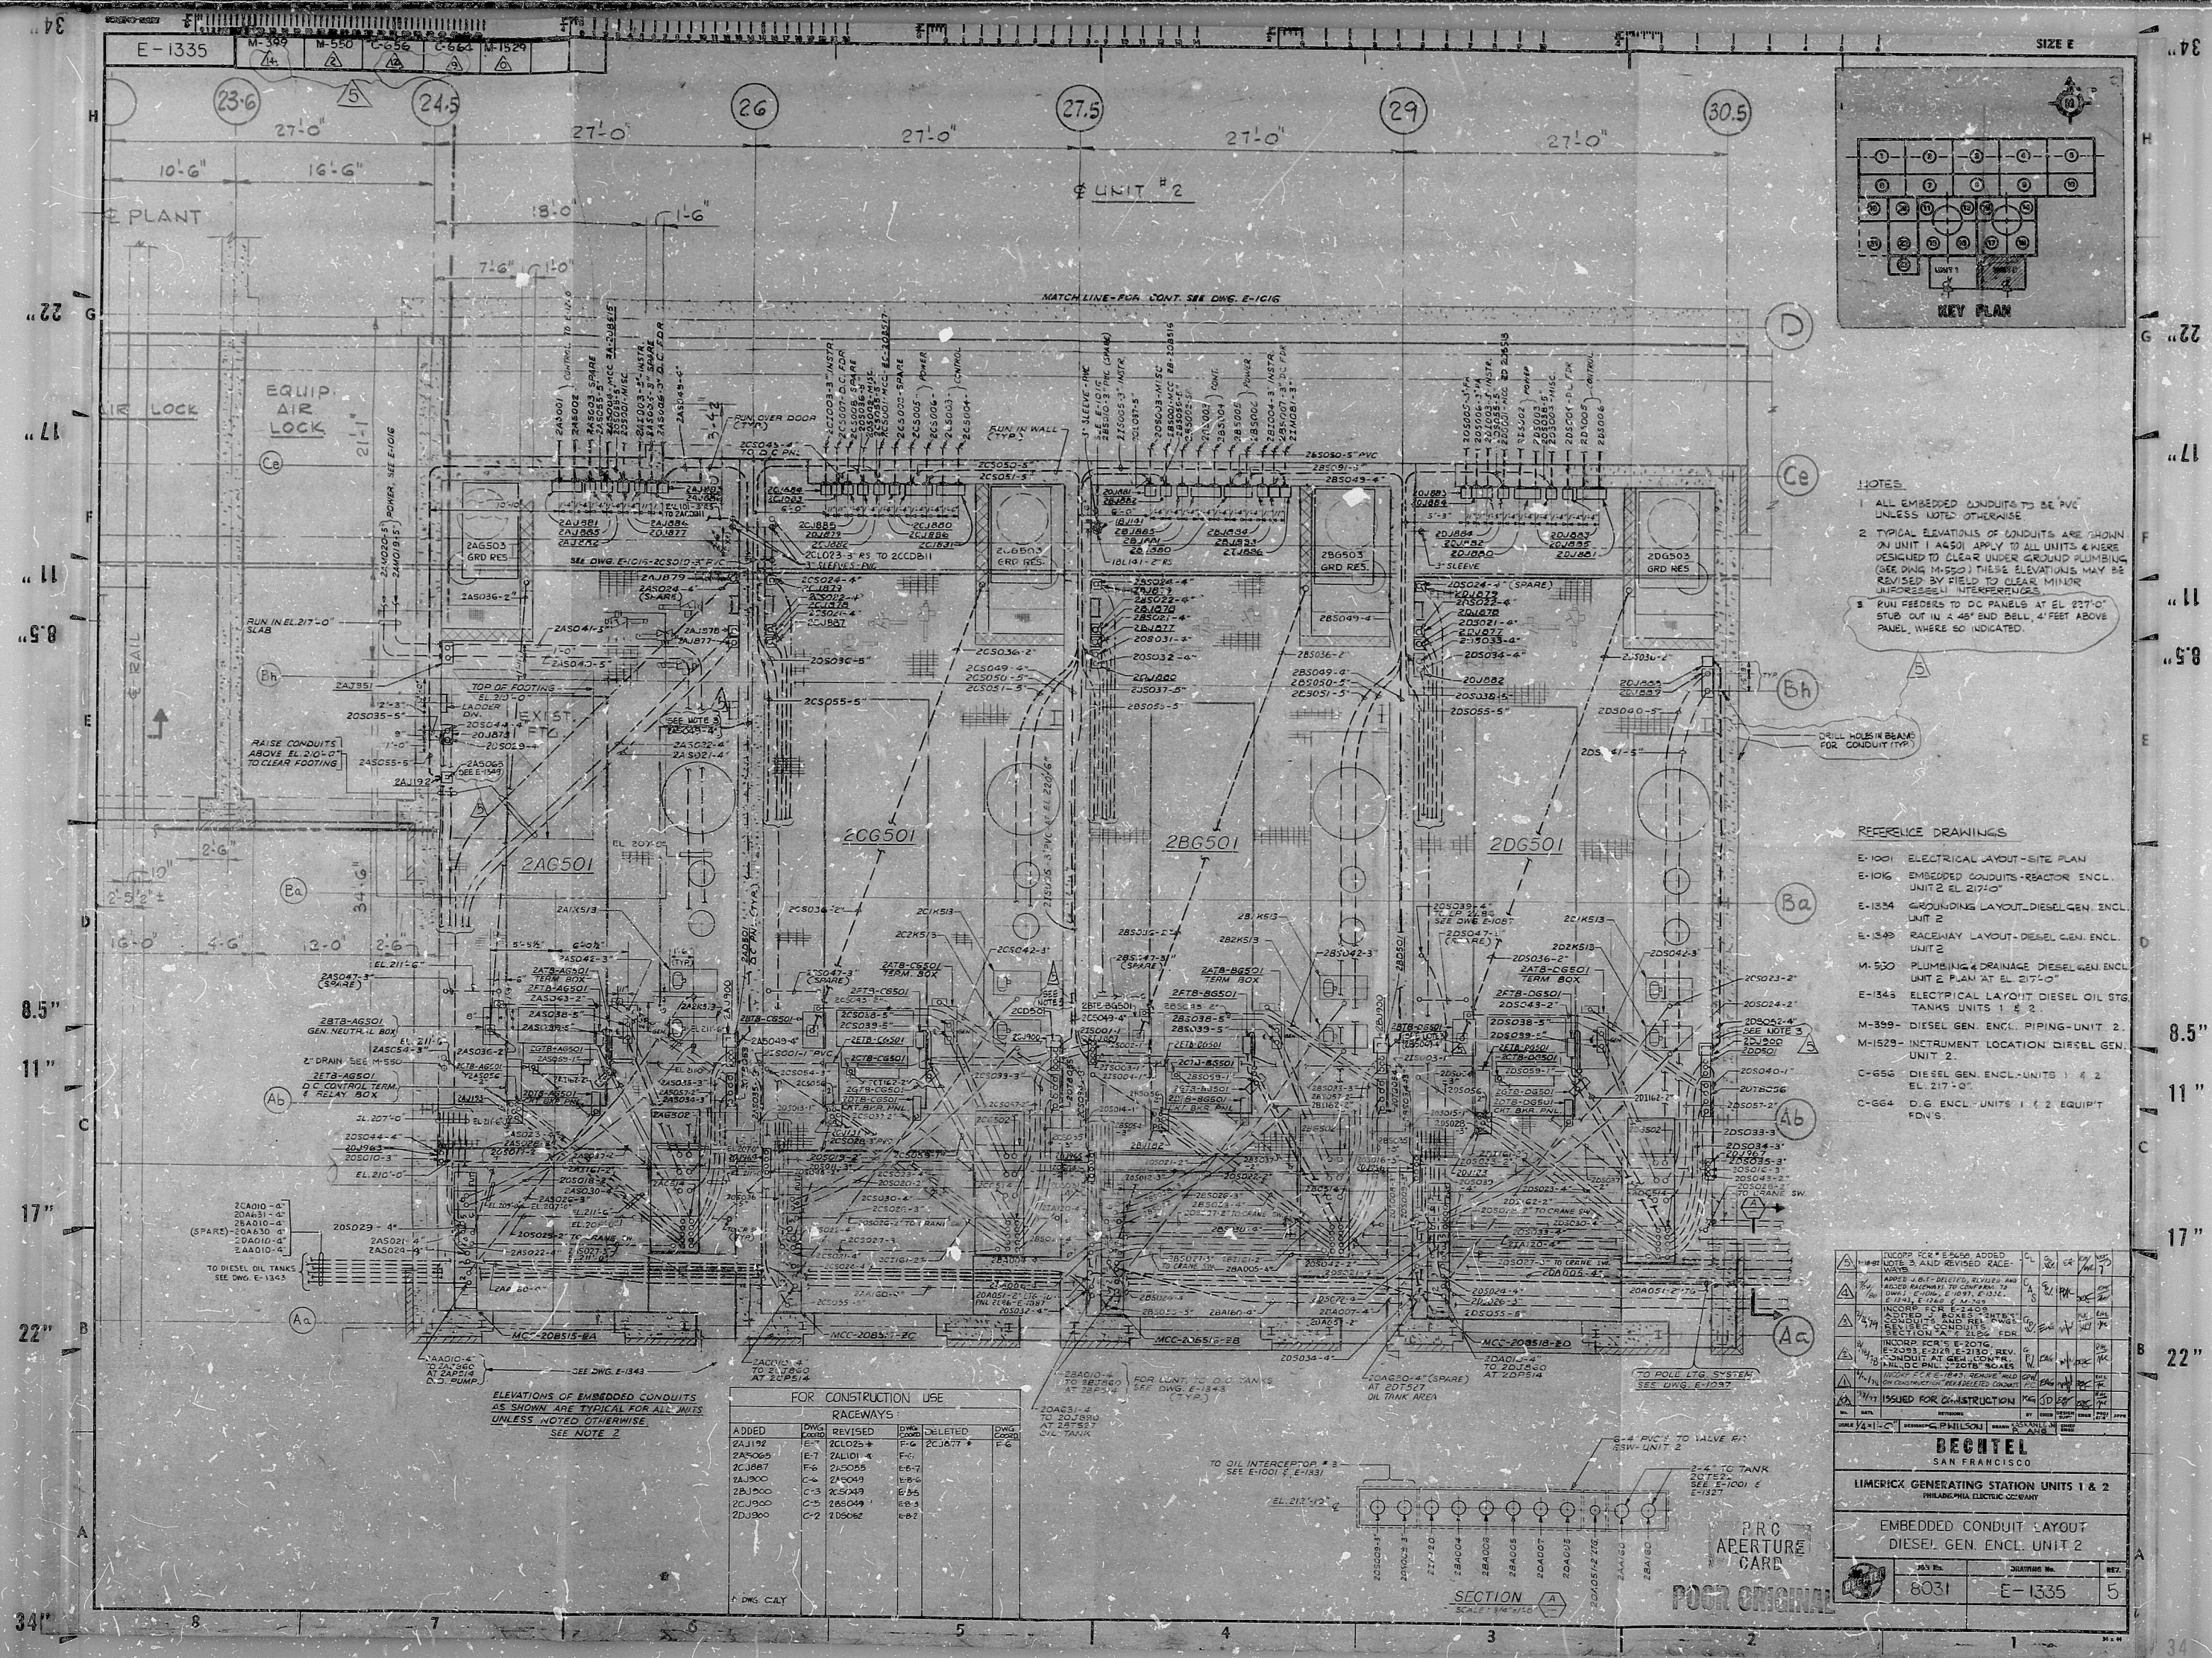

NOTES

1. ALL EMBEDDED CONDUITS TO BE PVC UNLESS NOTED OTHERWISE.
2. TYPICAL ELEVATIONS OF CONDUITS ARE SHOWN ON UNIT 1 ALSO. APPLY TO ALL UNITS & WERE DESIGNED TO CLEAR UNDER GROUND PLUMBING (SEE DWG. M-550). THESE ELEVATIONS MAY BE REVISED BY FIELD TO CLEAR MINOR UNFORESEEN INTERFERENCES.
3. RUN FEEDERS TO DC PANELS AT EL. 217'-0" STUB OUT IN 4" END BELL, 4" FEET ABOVE PANEL, WHERE SO INDICATED.

REFERENCE DRAWINGS

- E-1001 ELECTRICAL LAYOUT-SITE PLAN
- E-1016 EMBEDDED CONDUITS-REACTOR ENCL. UNIT 2 EL. 217'-0"
- E-1334 GROUNDING LAYOUT-DIESEL GEN. ENCL. UNIT 2
- E-1349 RACEWAY LAYOUT-DIESEL GEN. ENCL. UNIT 2
- M-530 PLUMBING & DRAINAGE DIESEL GEN. ENCL. UNIT 2 PLAN AT EL. 217'-0"
- E-1345 ELECTRICAL LAYOUT DIESEL OIL STG. TANKS UNITS 1 & 2
- M-399 DIESEL GEN. ENCL. PIPING-UNIT 2
- M-1529 INSTRUMENT LOCATION DIESEL GEN. UNIT 2
- C-656 DIESEL GEN. ENCL. UNITS 1 & 2 EL. 217'-0"
- C-664 D.G. ENCL. UNITS 1 & 2 EQUIPT. FDN'S.

FOR CONSTRUCTION USE

ADDED	DWG.	REVISED	DWG.	DELETED	DWG.
2A1192	E-1	2C1025	F-6	2C1A77	F-6
2A5065	E-1	2A1101	F-6		
2C1087	F-6	2A5055	E-6		
2A1300	C-6	2A5049	E-6		
2A1300	C-6	2A5049	E-6		
2C1300	C-2	2D5052	E-6		

NO.	DATE	DESCRIPTION	BY	CHKD.	APP'D.
1	10/1/54	ISSUED FOR CONSTRUCTION	W. J. H. H.	W. J. H. H.	W. J. H. H.

BECHTEL
SAN FRANCISCO

LIMERICK GENERATING STATION UNITS 1 & 2
PHILADELPHIA ELECTRIC COMPANY

EMBEDDED CONDUIT LAYOUT
DIESEL GEN. ENCL. UNIT 2

REV. NO.	DATE	DESCRIPTION	BY	CHKD.	APP'D.
8031	E-1335				

Ricks

8301120632

