


Image contained on this frame made in the normal and regular course of business, on the date stated below and that it is an accurate reproduction of the document submitted to reprographics.

DATE 6/1/79
CAMERA OPERATOR [Signature]
SUPERVISOR OF REPROGRAPHICS [Signature]

Q-1340

16X

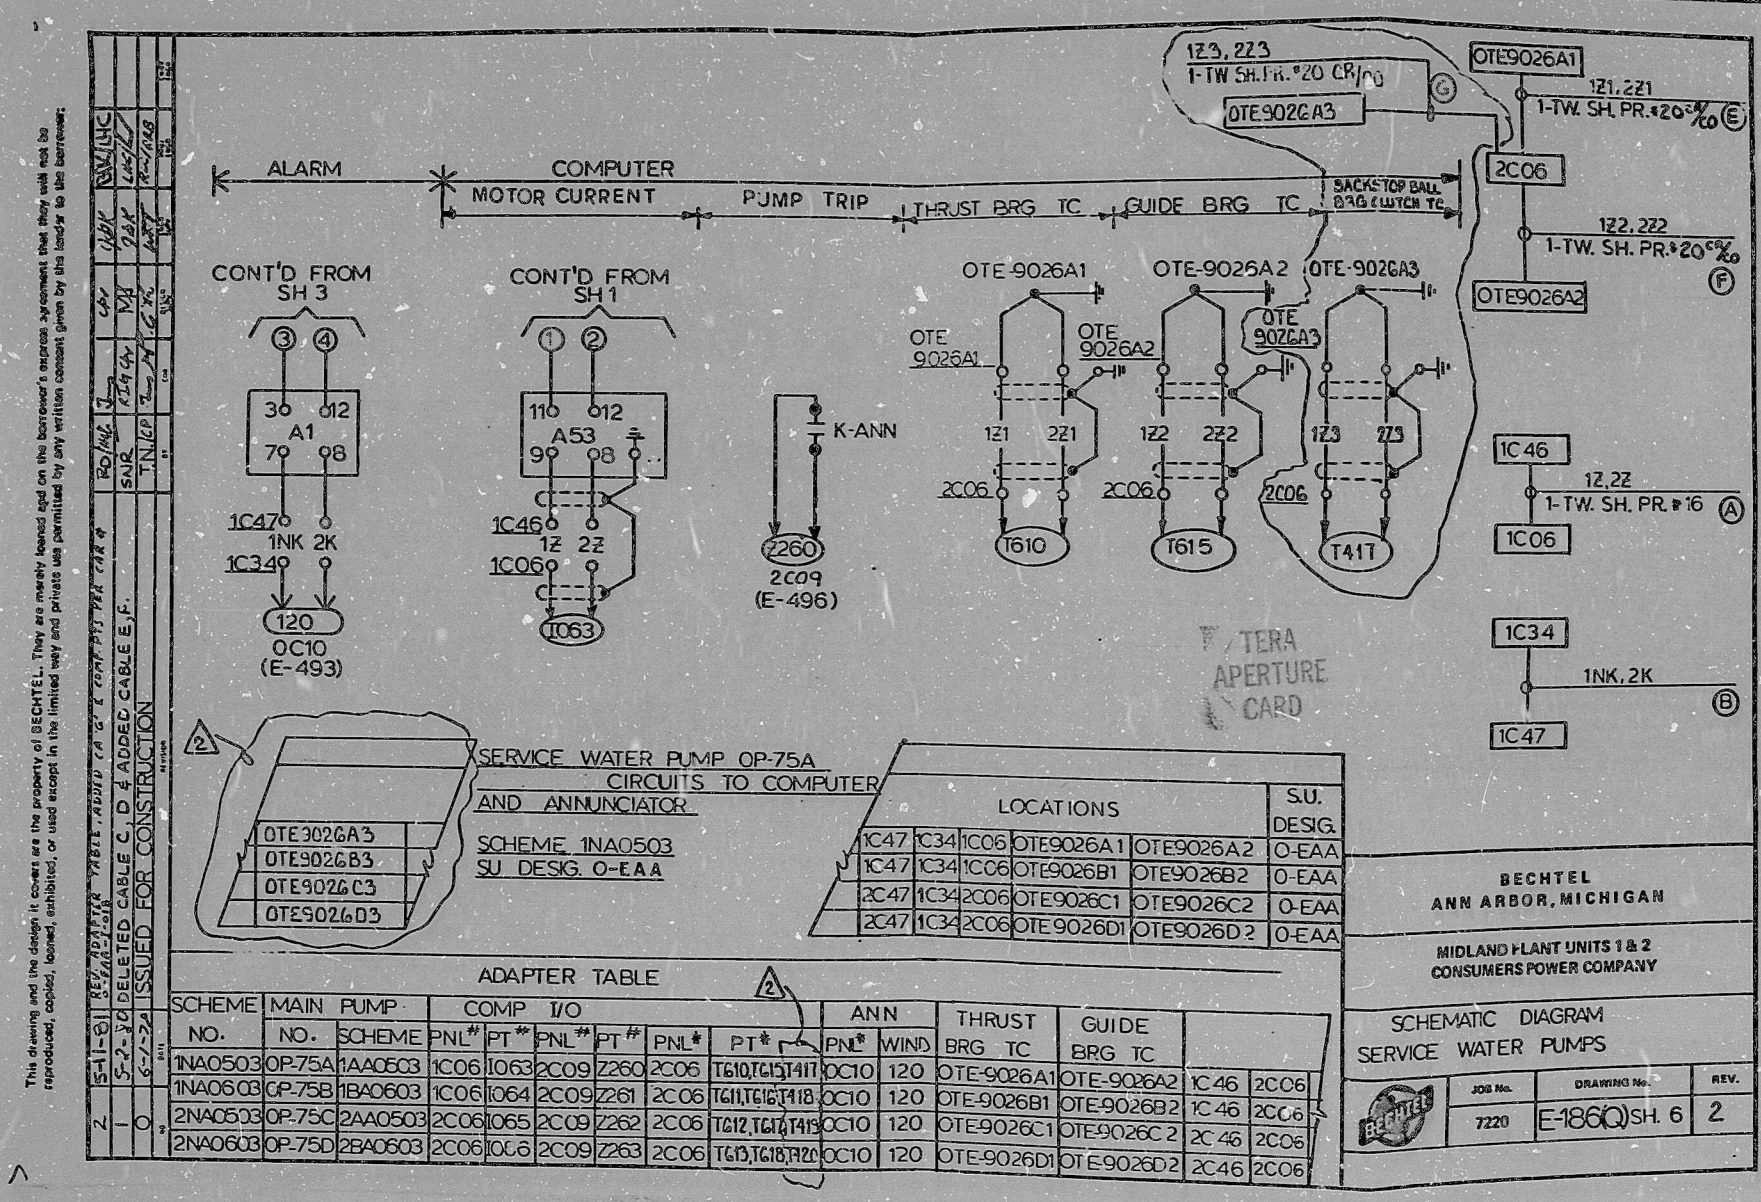

RIDS

8107220267

