


an accurate reproduction of the document submitted to reprographics.

DATE *4/18/72*
C. Anderson
 CAMERA OPERATOR
 SUPERVISOR OF REPROGRAPHICS

16X

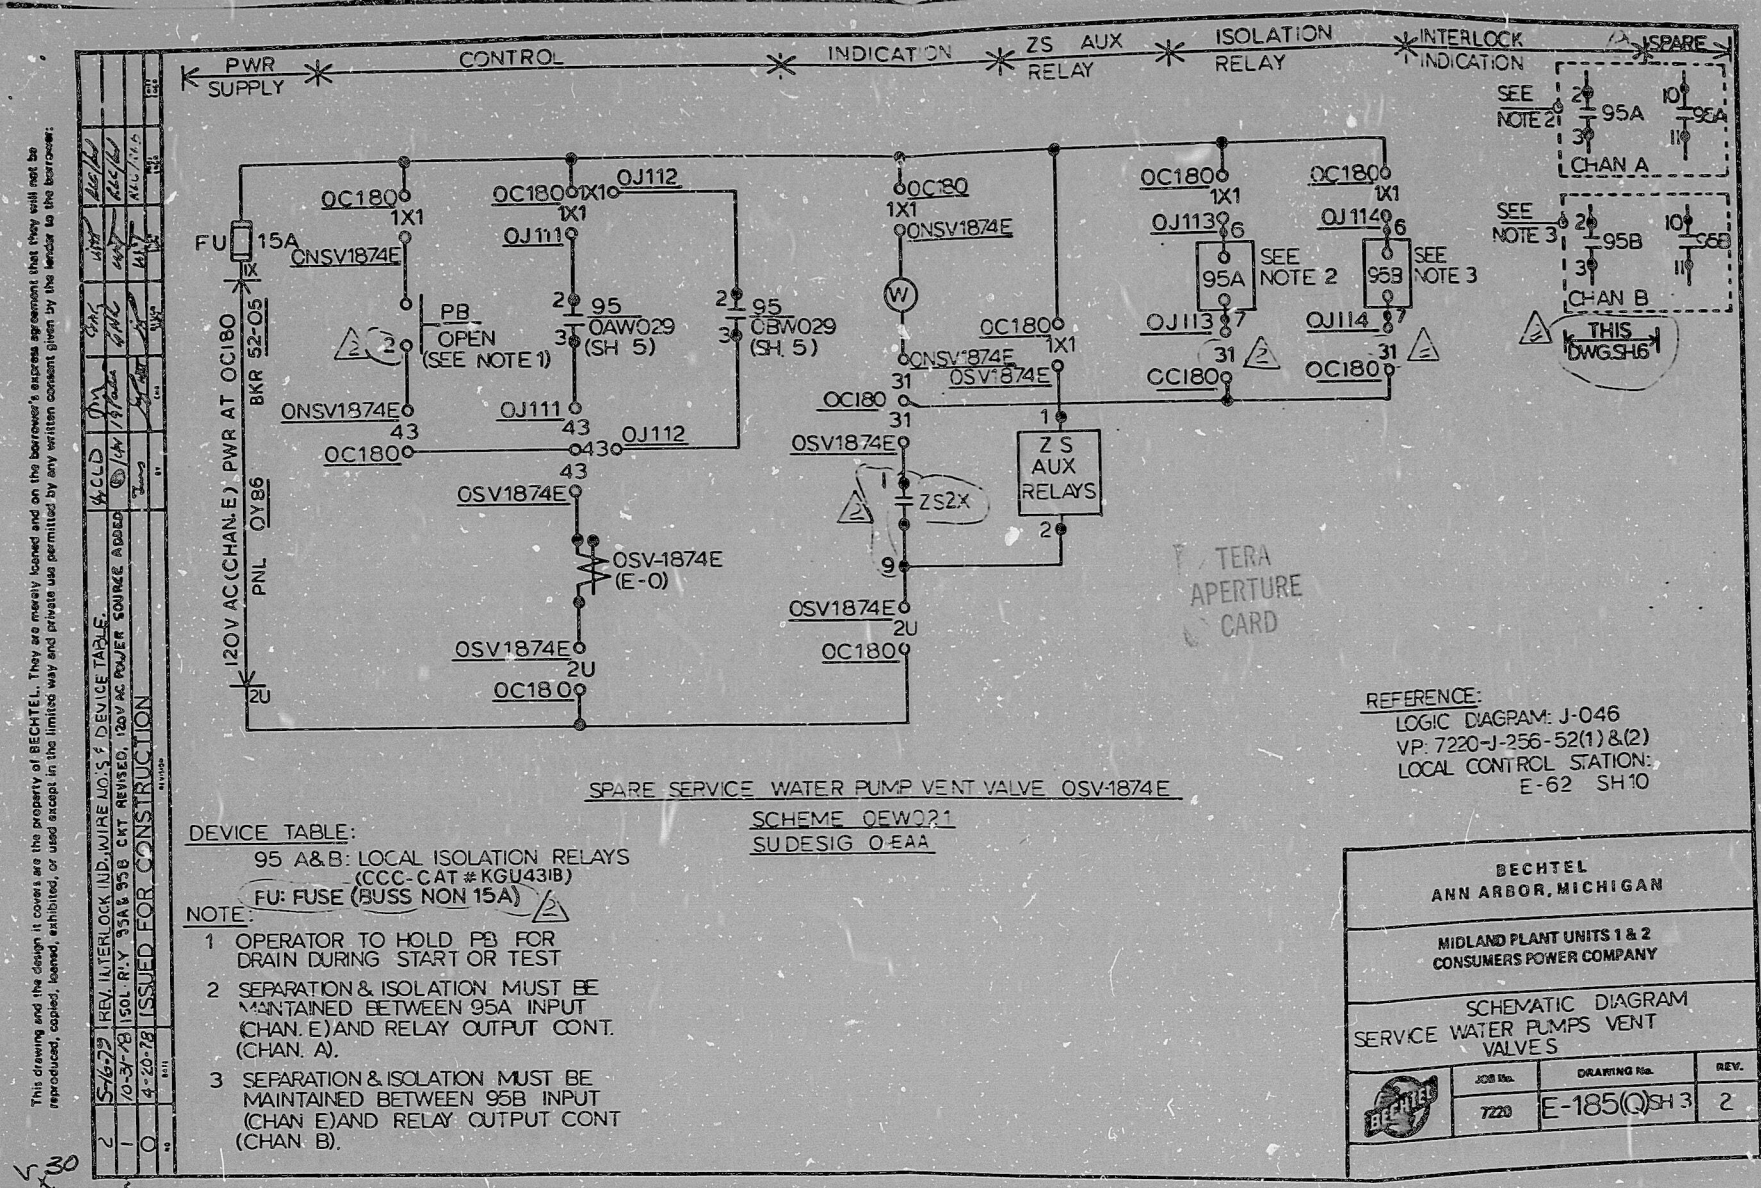

This drawing and the design it covers are the property of BECHTEL. They are hereby loaned and on the borrower's express agreement that they will not be reproduced, copied, loaned, exhibited, or used except in the limited way and for the purpose permitted by the written consent given by the lender to the borrower.

REV.	DATE	BY	CHKD.	APP.	DESCRIPTION

- DEVICE TABLE:**
 95 A&B: LOCAL ISOLATION RELAYS
 (CCC-CAT # KGU4318)
 FU: FUSE (BUSS NON 15A)
- NOTE:**
- 1 OPERATOR TO HOLD PB FOR DRAIN DURING START OR TEST
 - 2 SEPARATION & ISOLATION MUST BE MAINTAINED BETWEEN 95A INPUT (CHAN. E) AND RELAY OUTPUT CONT. (CHAN. A).
 - 3 SEPARATION & ISOLATION MUST BE MAINTAINED BETWEEN 95B INPUT (CHAN. E) AND RELAY OUTPUT CONT. (CHAN. B).

RIDS

8105220294

