




RIDS

8107220383

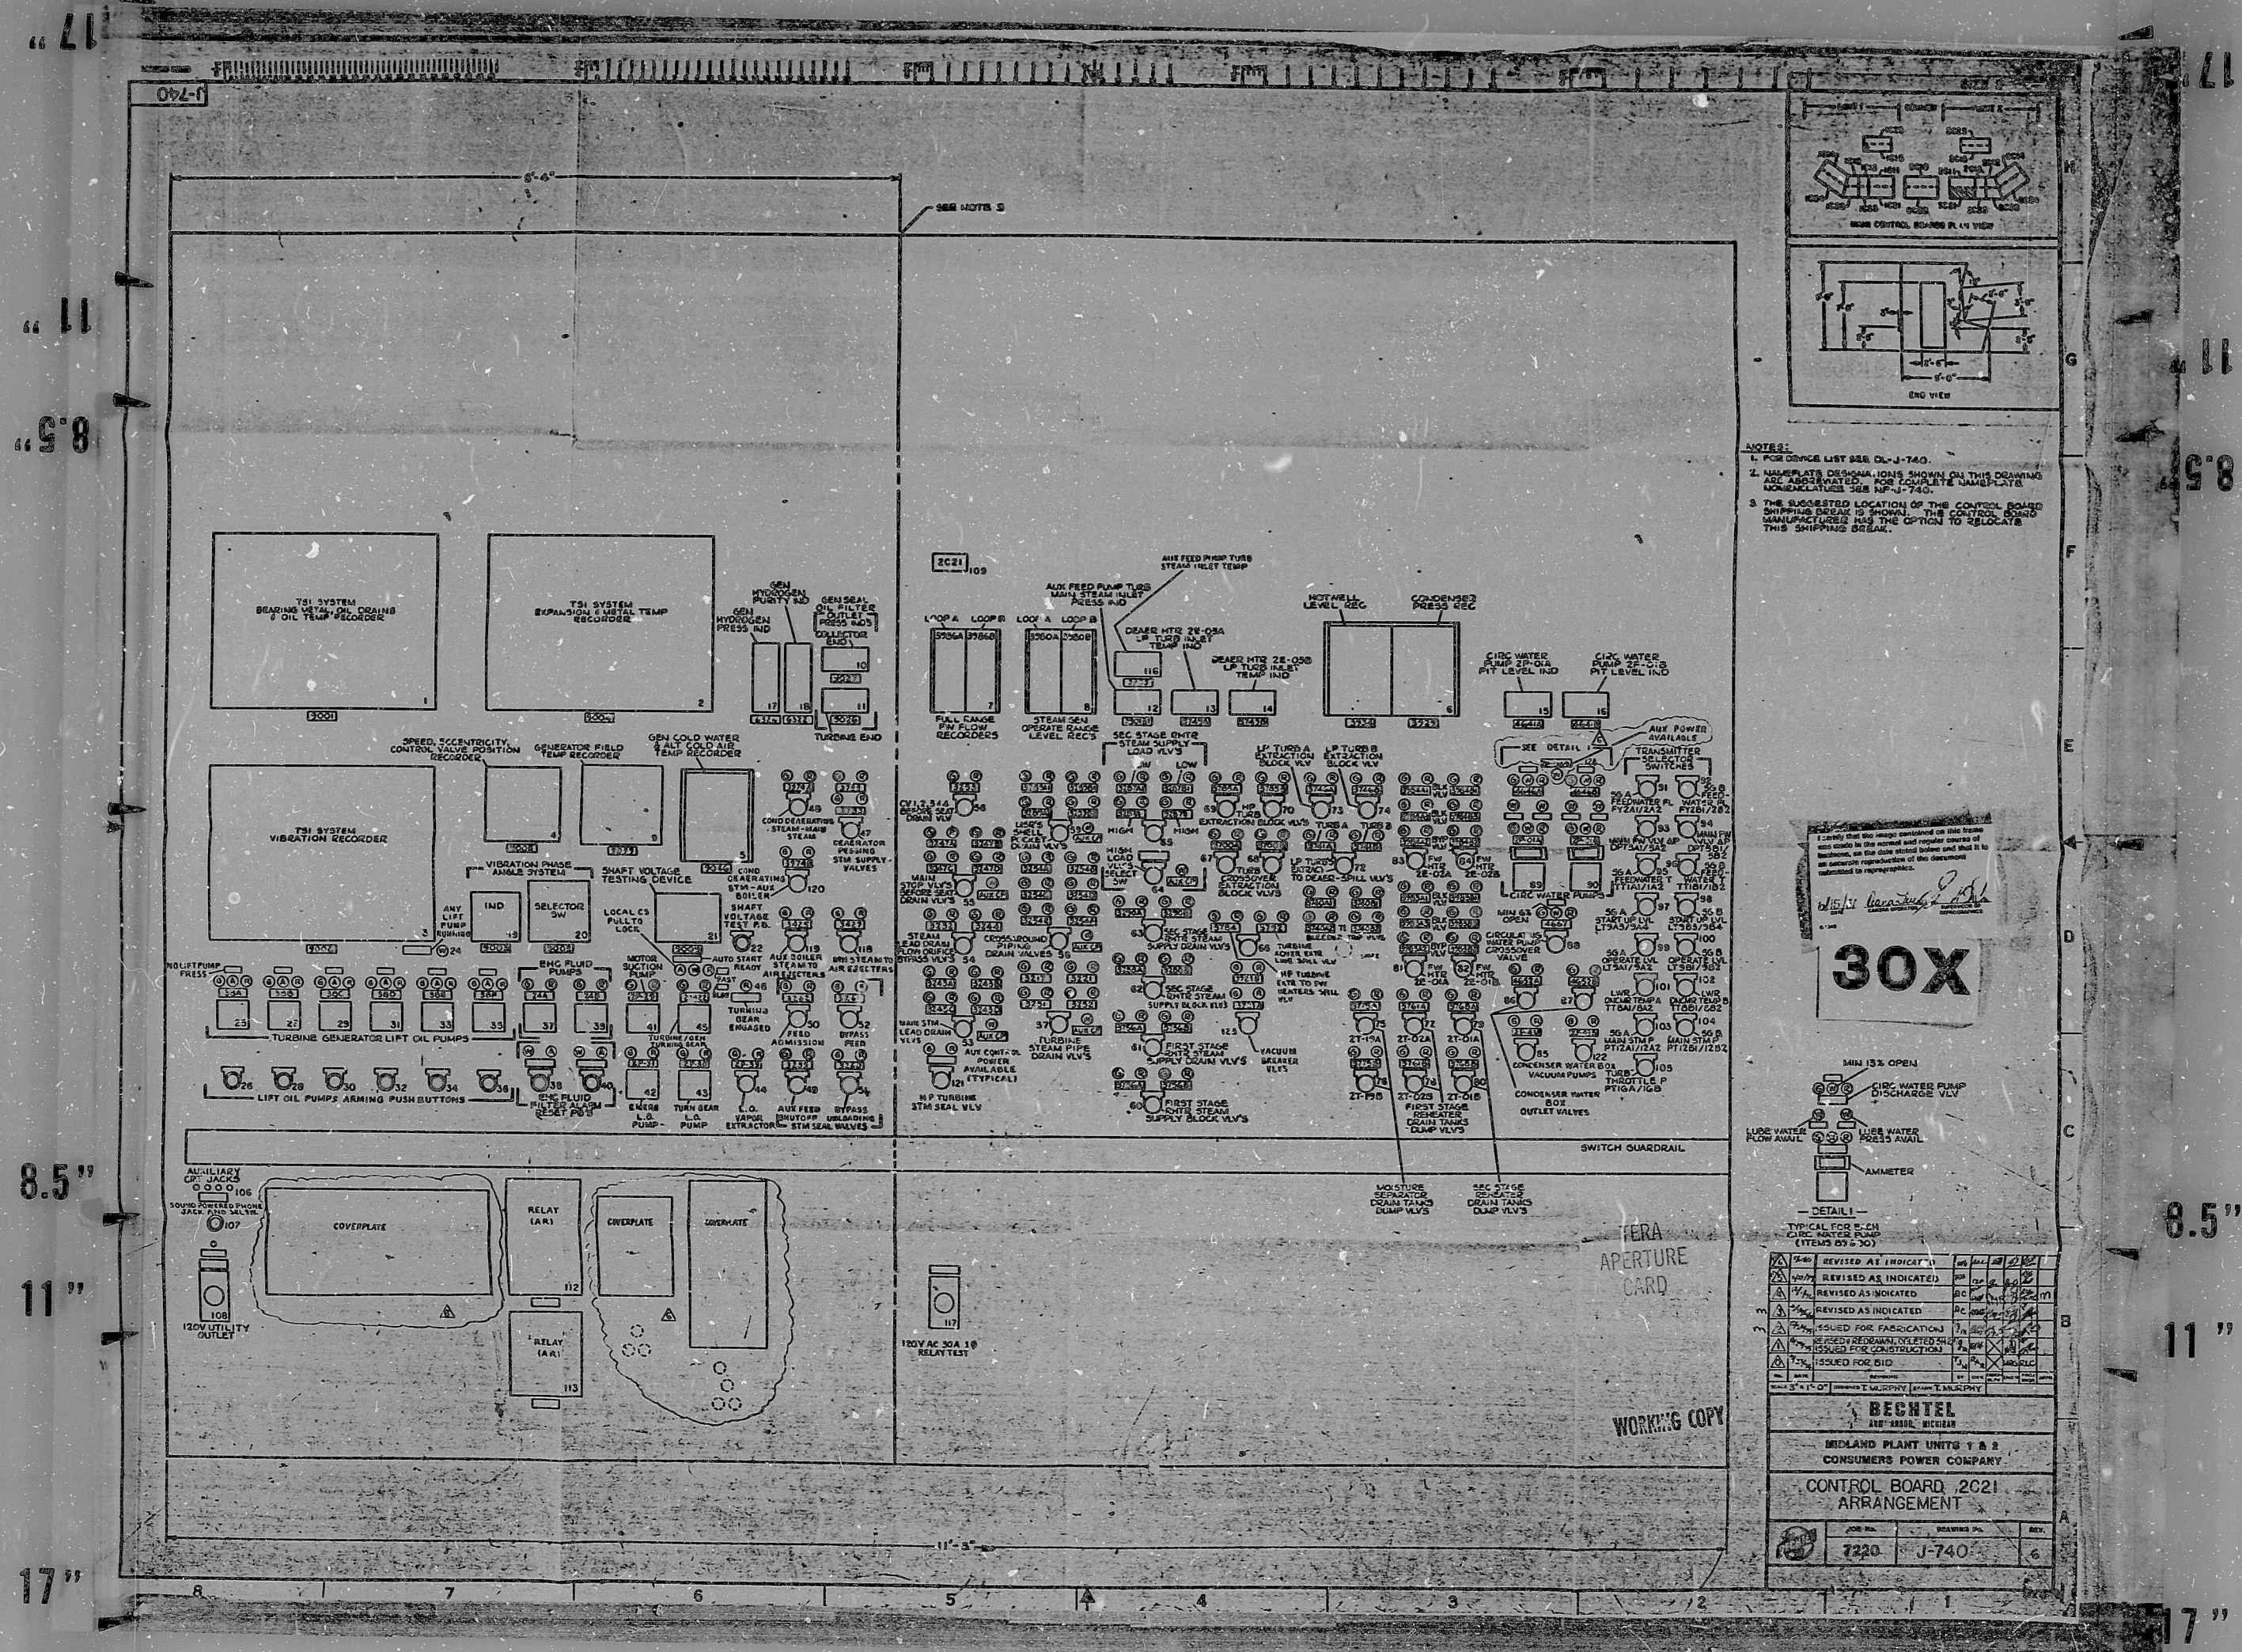