


This drawing and the design it covers are the property of BECHTEL. They are hereby loaned and on the borrower's express agreement that they will not be reproduced, copied, retransmitted, or used except in the manner, or for the purpose, intended, without the written consent of BECHTEL.

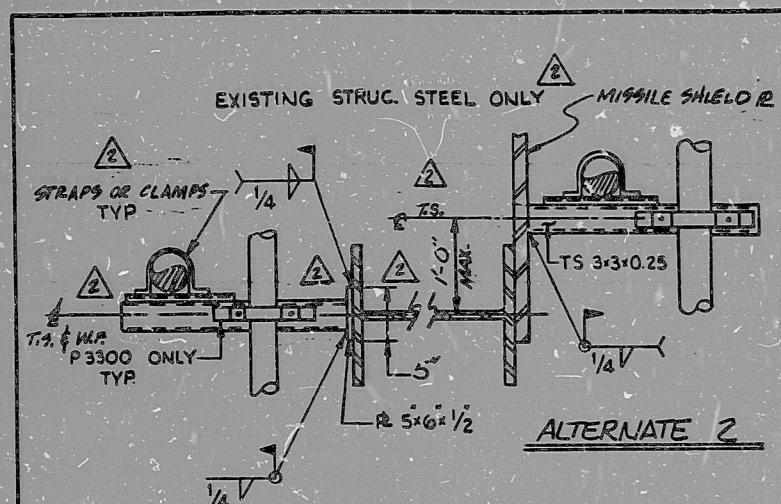

ALTERNATE 1

NOTES:

1. MAX. CANTILEVER LENGTH OF TS IS 24"
2. MAX. WEIGHT PER SUPPORT IS 300 LBS.
3. SUPPORT FOR USE IN AUX. BLDG. ABOVE EL 704'-0"
4. FOR SHIM WELD DETAIL & SHIM ORIENTATION SEE SH. 329.
5. FOR SUPPORT SPACING SEE TABLE 7A ON SH. 313.

TYPE IIC SUPPORT

1-14-72	REVISED AS NOTED	CP	ATZ	MP	WEL	WEL	WEL	WEL	WEL
3-14-83	REV PER REGR. ANALYSIS	CP	RTZ	MP	WEL	WEL	WEL	WEL	WEL
5-15-81	REVISED FOR CONST. PER PN E303	TJB	CP	MP	WEL	WEL	WEL	WEL	WEL
NO.	DATE	REVISIONS	BY	CHKD.	GROUP	GROUP	GROUP	GROUP	GROUP
SCALE	DESIGNED	DRAWN	BY	CHKD.	GROUP	GROUP	GROUP	GROUP	GROUP
ORIGIN	MIDLAND PLANT UNITS 1 AND 2	CONSUMERS POWER COMPANY	CONDUIT AND TRAY	NOTES, SYMBOLS, AND DETAILS	7220	7220	7220	7220	7220

PRC
APERTURE
CARD

CERTIFICATE OF MICROFILMING

"I certify that the image contained on this frame was made in the normal and regular course of business on the date stated below and that it is an accurate reproduction of the document submitted to the contractor for filming by Bechtel Power Corporation."

Date 7-11-83
Camera Operator Jimbo Vank
Cont. Supervisor Joe Conkett

PDR RIDS

8401060659

