


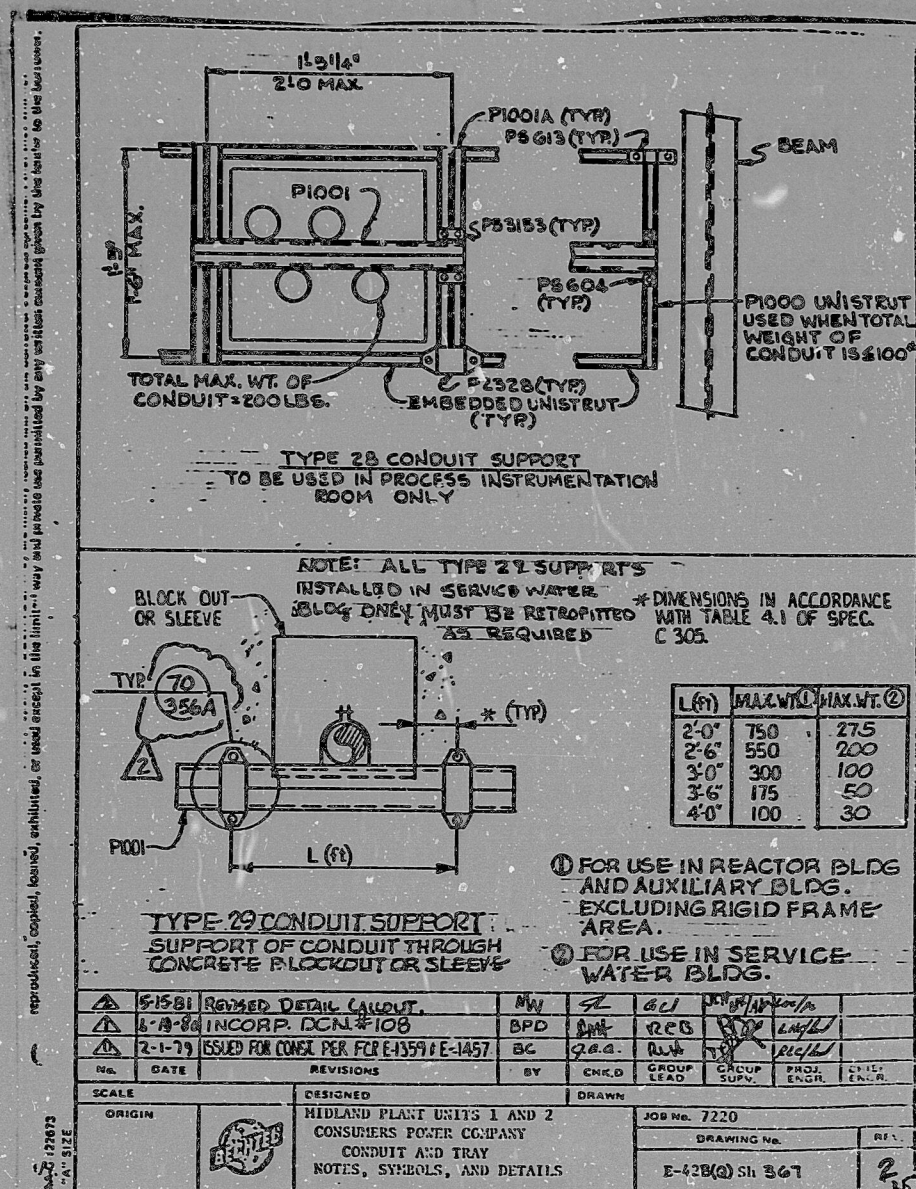

TERA
APERTURE
CARD

16X

I certify that the image contained on this frame
was made in the normal and regular course of
business, on the date stated below and that it is
an accurate reproduction of the document
submitted to reprographics.

6-15-81
DATE
M. C. L. C. S. A. H.
CAMERA OPERATOR
SUPERVISOR OF
REPROGRAPHICS

G-1348

RIDS

8107230331

