


This drawing and the design it covers are the property of BECHTEL. They are hereby loaned and on the borrower's express agreement that they will not be reproduced, copied, altered, or used except in the limited way and within the limits set forth in the license to the borrower.

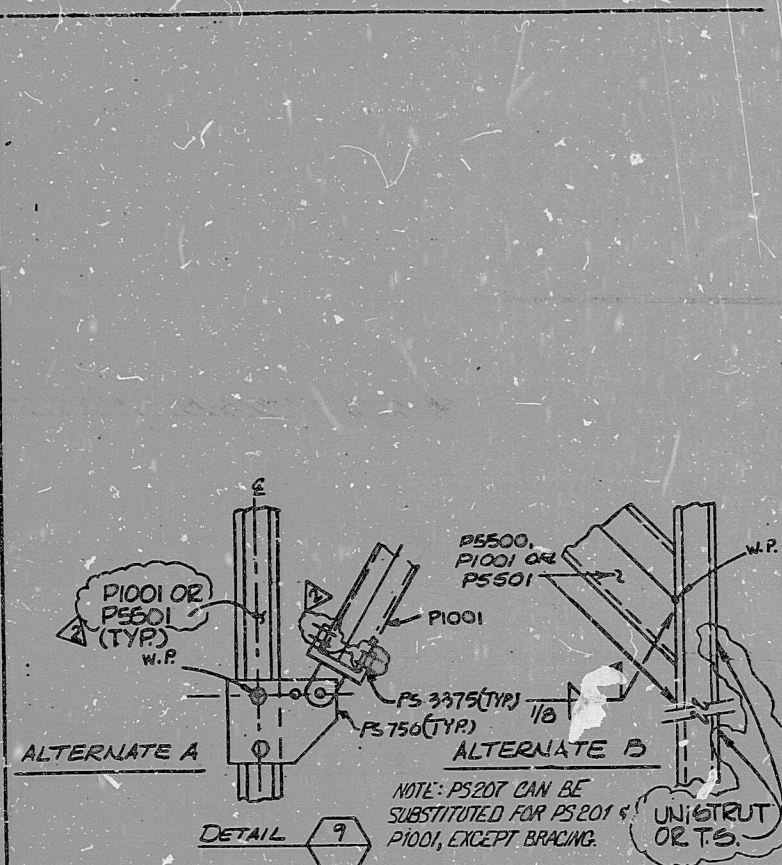

CLASS I CONDUIT SUPPORTS

1-8-83	REVISED AS NOTED	DEL. 1-8-83	BY	W.P.
8-13-84	REVISED AS NOTED	S/D	W.P.	W.P.
12-12-77	ISSUED FOR CONSTRUCTION 1 & 2	BY	W.P.	W.P.
DATE	REVISIONS	BY	CHK'D	GROUP
				LEAD
				SUPV.
				PROJ. ENGR.
				CHIEF ENGR.
SCALE	DESIGNED	DRAWN	PAVITT	
ORIGIN	MIDLAND PLANT UNITS 1 & 2	JOB No.	7220	
	CONSUMERS POWER COMPANY	DRAWING No.		REV.
	CONDUIT AND TRAY			
	NOTES, SYMBOLS AND DETAILS	E-428(d) SH. 351	2	

CERTIFICATE OF MICROFILMING

"I certify that the image contained on this frame was made in the normal and regular course of business on the date stated below and that it is an accurate reproduction of the document submitted to the contractor for filming by Bechtel Power Corporation."

7-11-83 Date
Camera Operator
Cont. Supv.

PRC
PERTURE
CARD

PDR RIDS

84 ϕ 1 ϕ 9 ϕ 263

