


34"

34"

A  
 22"  
 B  
 17"  
 C  
 11"  
 D  
 8.5"  
 E  
 11"  
 F  
 8.5"  
 G  
 17"  
 H  
 22"  
 I  
 17"  
 J

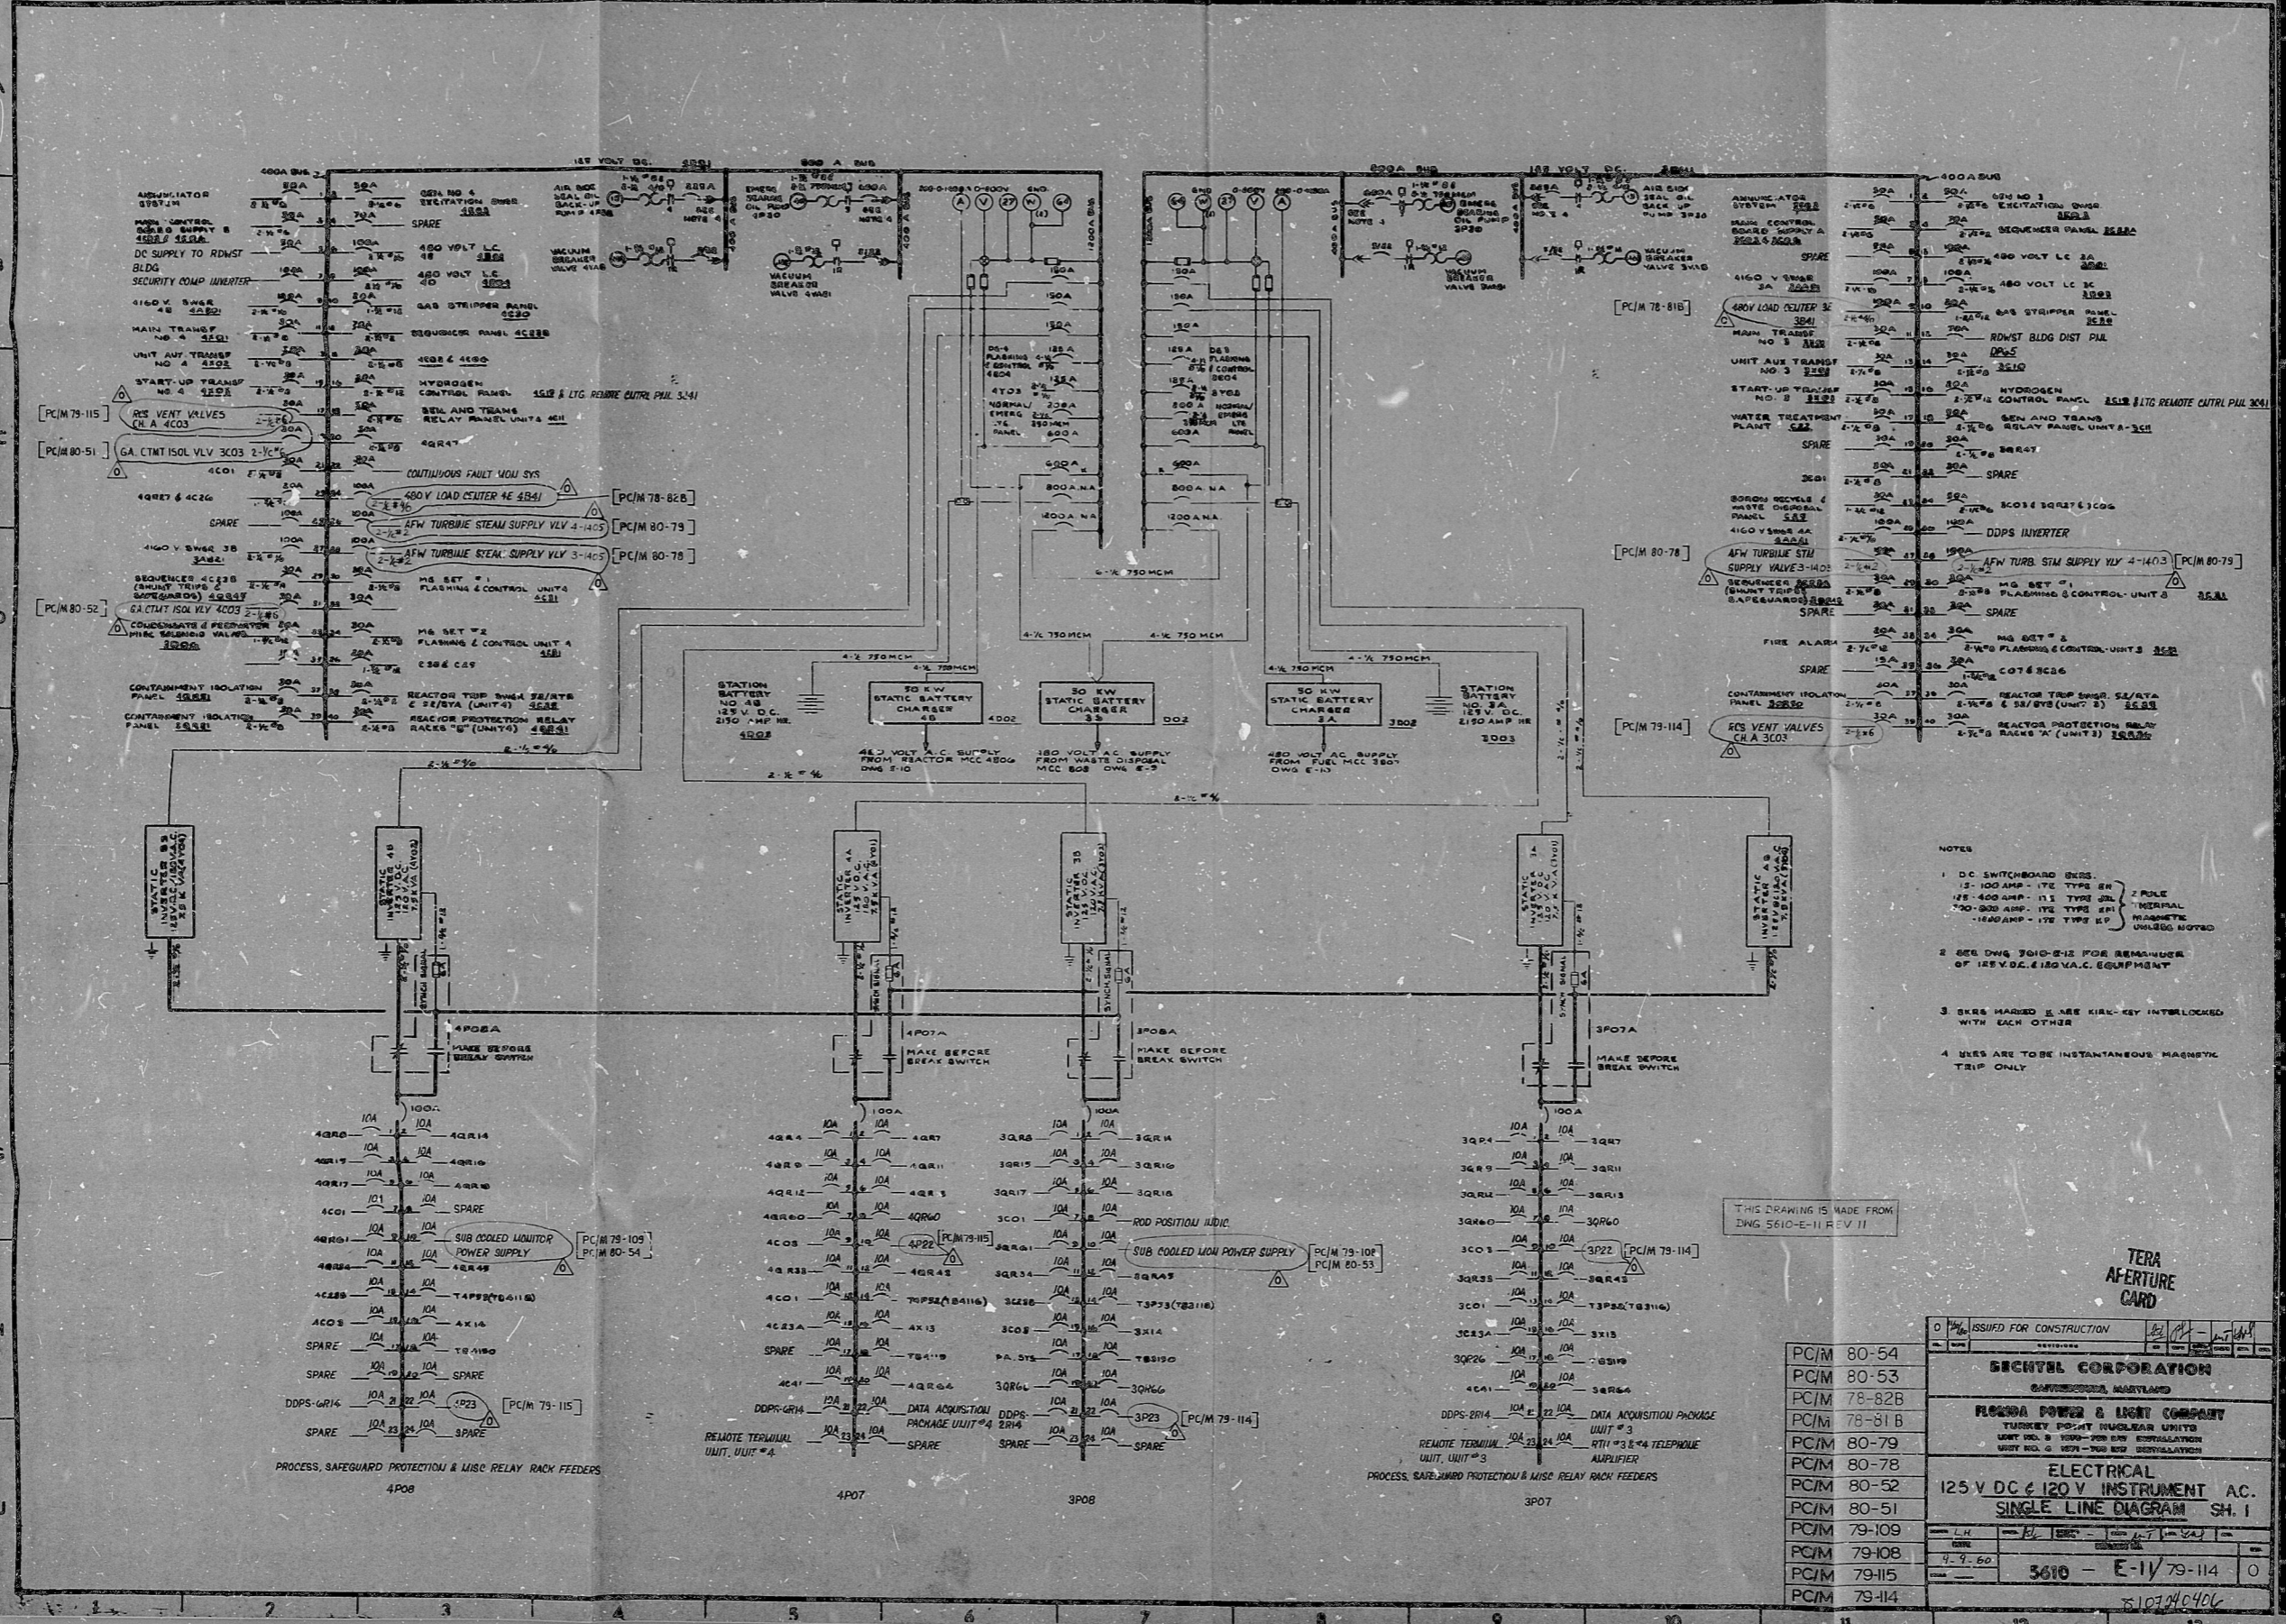

NOTES  
 1 DC SWITCHBOARD BUSES  
 2 100 AMP - 17E TYPE ER  
 3 400 AMP - 11 TYPE ER  
 4 200 AMP - 17E TYPE ER  

THIS DRAWING IS MADE FROM:  
 DWG 5610-E-11 REV 11

PC/M 80-54	ISSUED FOR CONSTRUCTION
PC/M 80-53	REVISION
PC/M 78-82B	REVISION
PC/M 78-81B	REVISION
PC/M 80-79	REVISION
PC/M 80-78	REVISION
PC/M 80-52	REVISION
PC/M 80-51	REVISION
PC/M 79-109	REVISION
PC/M 79-108	REVISION
PC/M 79-115	REVISION
PC/M 79-114	REVISION

3610 - E-11/79-114

TERA  
 APERTURE  
 CARD

34"

34"



RIDS

8107240406

