


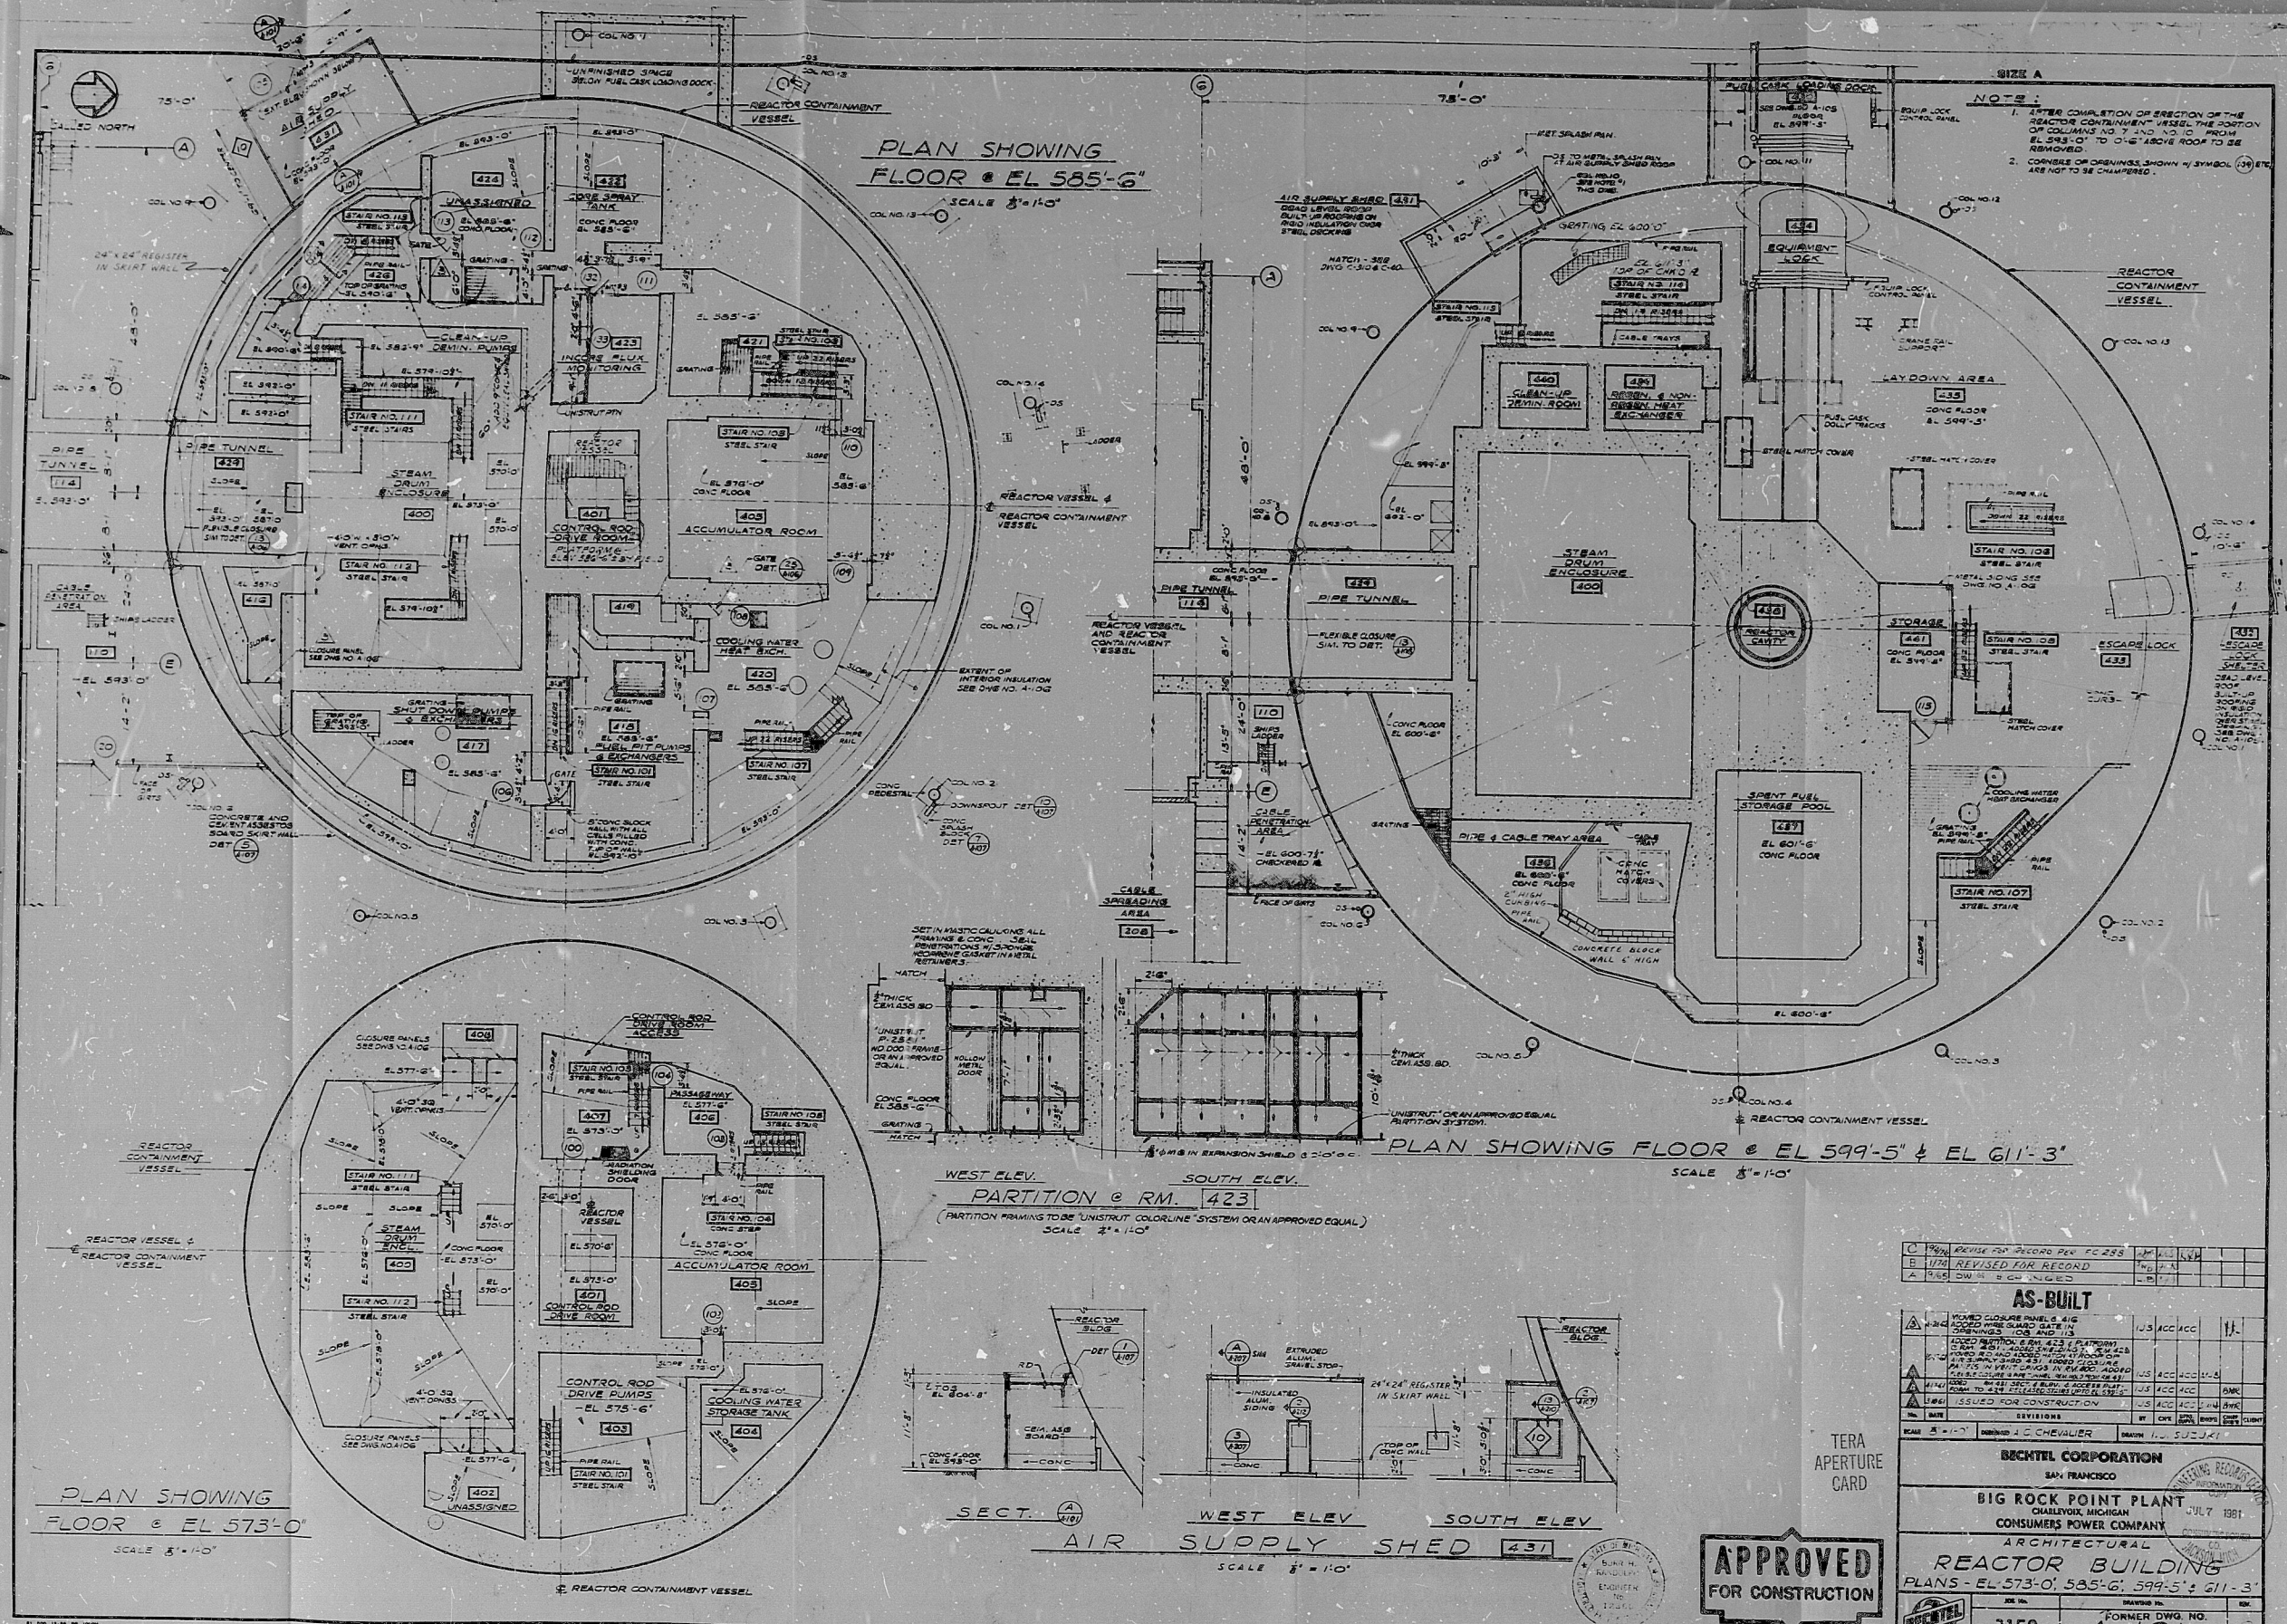

RIDS

810J270073

