


I certify that the image contained on this frame was made in the normal and regular course of business, on the date stated below and that it is an accurate reproduction of the document submitted to reprographics.

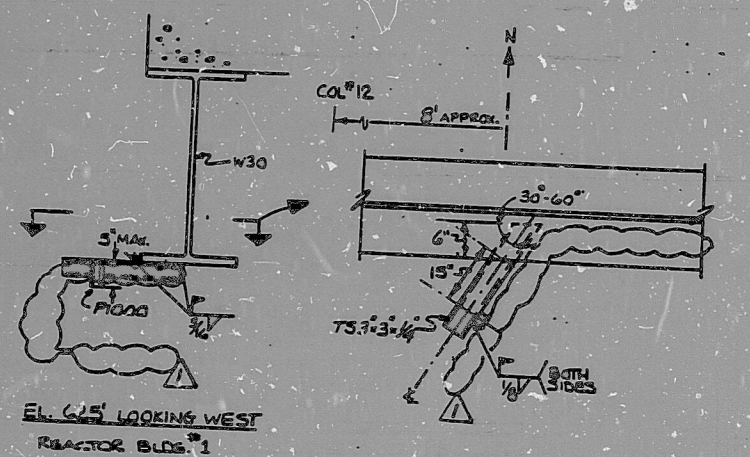

- NOTES:
1. TOTAL WEIGHT OF COMPONENT ATTACHED TO SUPPORT SHALL NOT EXCEED 50 POUNDS
 2. FOR CONNECTION DETAILS NOT SHOWN, SEE DETAIL 97 SHEET 137 AND DETAIL 39 SHEET 360.
 3. FOR TYPICAL SHIMMING DETAILS, SEE DETAIL 60, SHEET 342.

TYPE 540 SUPPORT

E-428(V) SUPPORT															
E-27-01		INCOB PCN E-017		TCR		RUM		HMC		HMC		HMC		HMC	
6-12-79		ISSUED FOR COMINT PCN #63		HMC		HMC		HMC		HMC		HMC		HMC	
No.		DATE		REVISIONS		SY		CHILD		GROUP LEAD		GROUP SUPV		PRGA ENGR	
SCALE 3/4		ORIGIN		DESIGN		DRAWN		HMC CHAPMAN		JOB NO. 7220		DRAWING NO.		REV.	
				KIDLAND PLANT UNITS 1 & 2 CONSUMERS POWER COMPANY ORIENTAL AND TRAY NOTES, SYMBOLS AND DETAILS								E-428(V) Ss. 540			

PRC
APERTURE
CARD

PDR RIDS

840110009

