


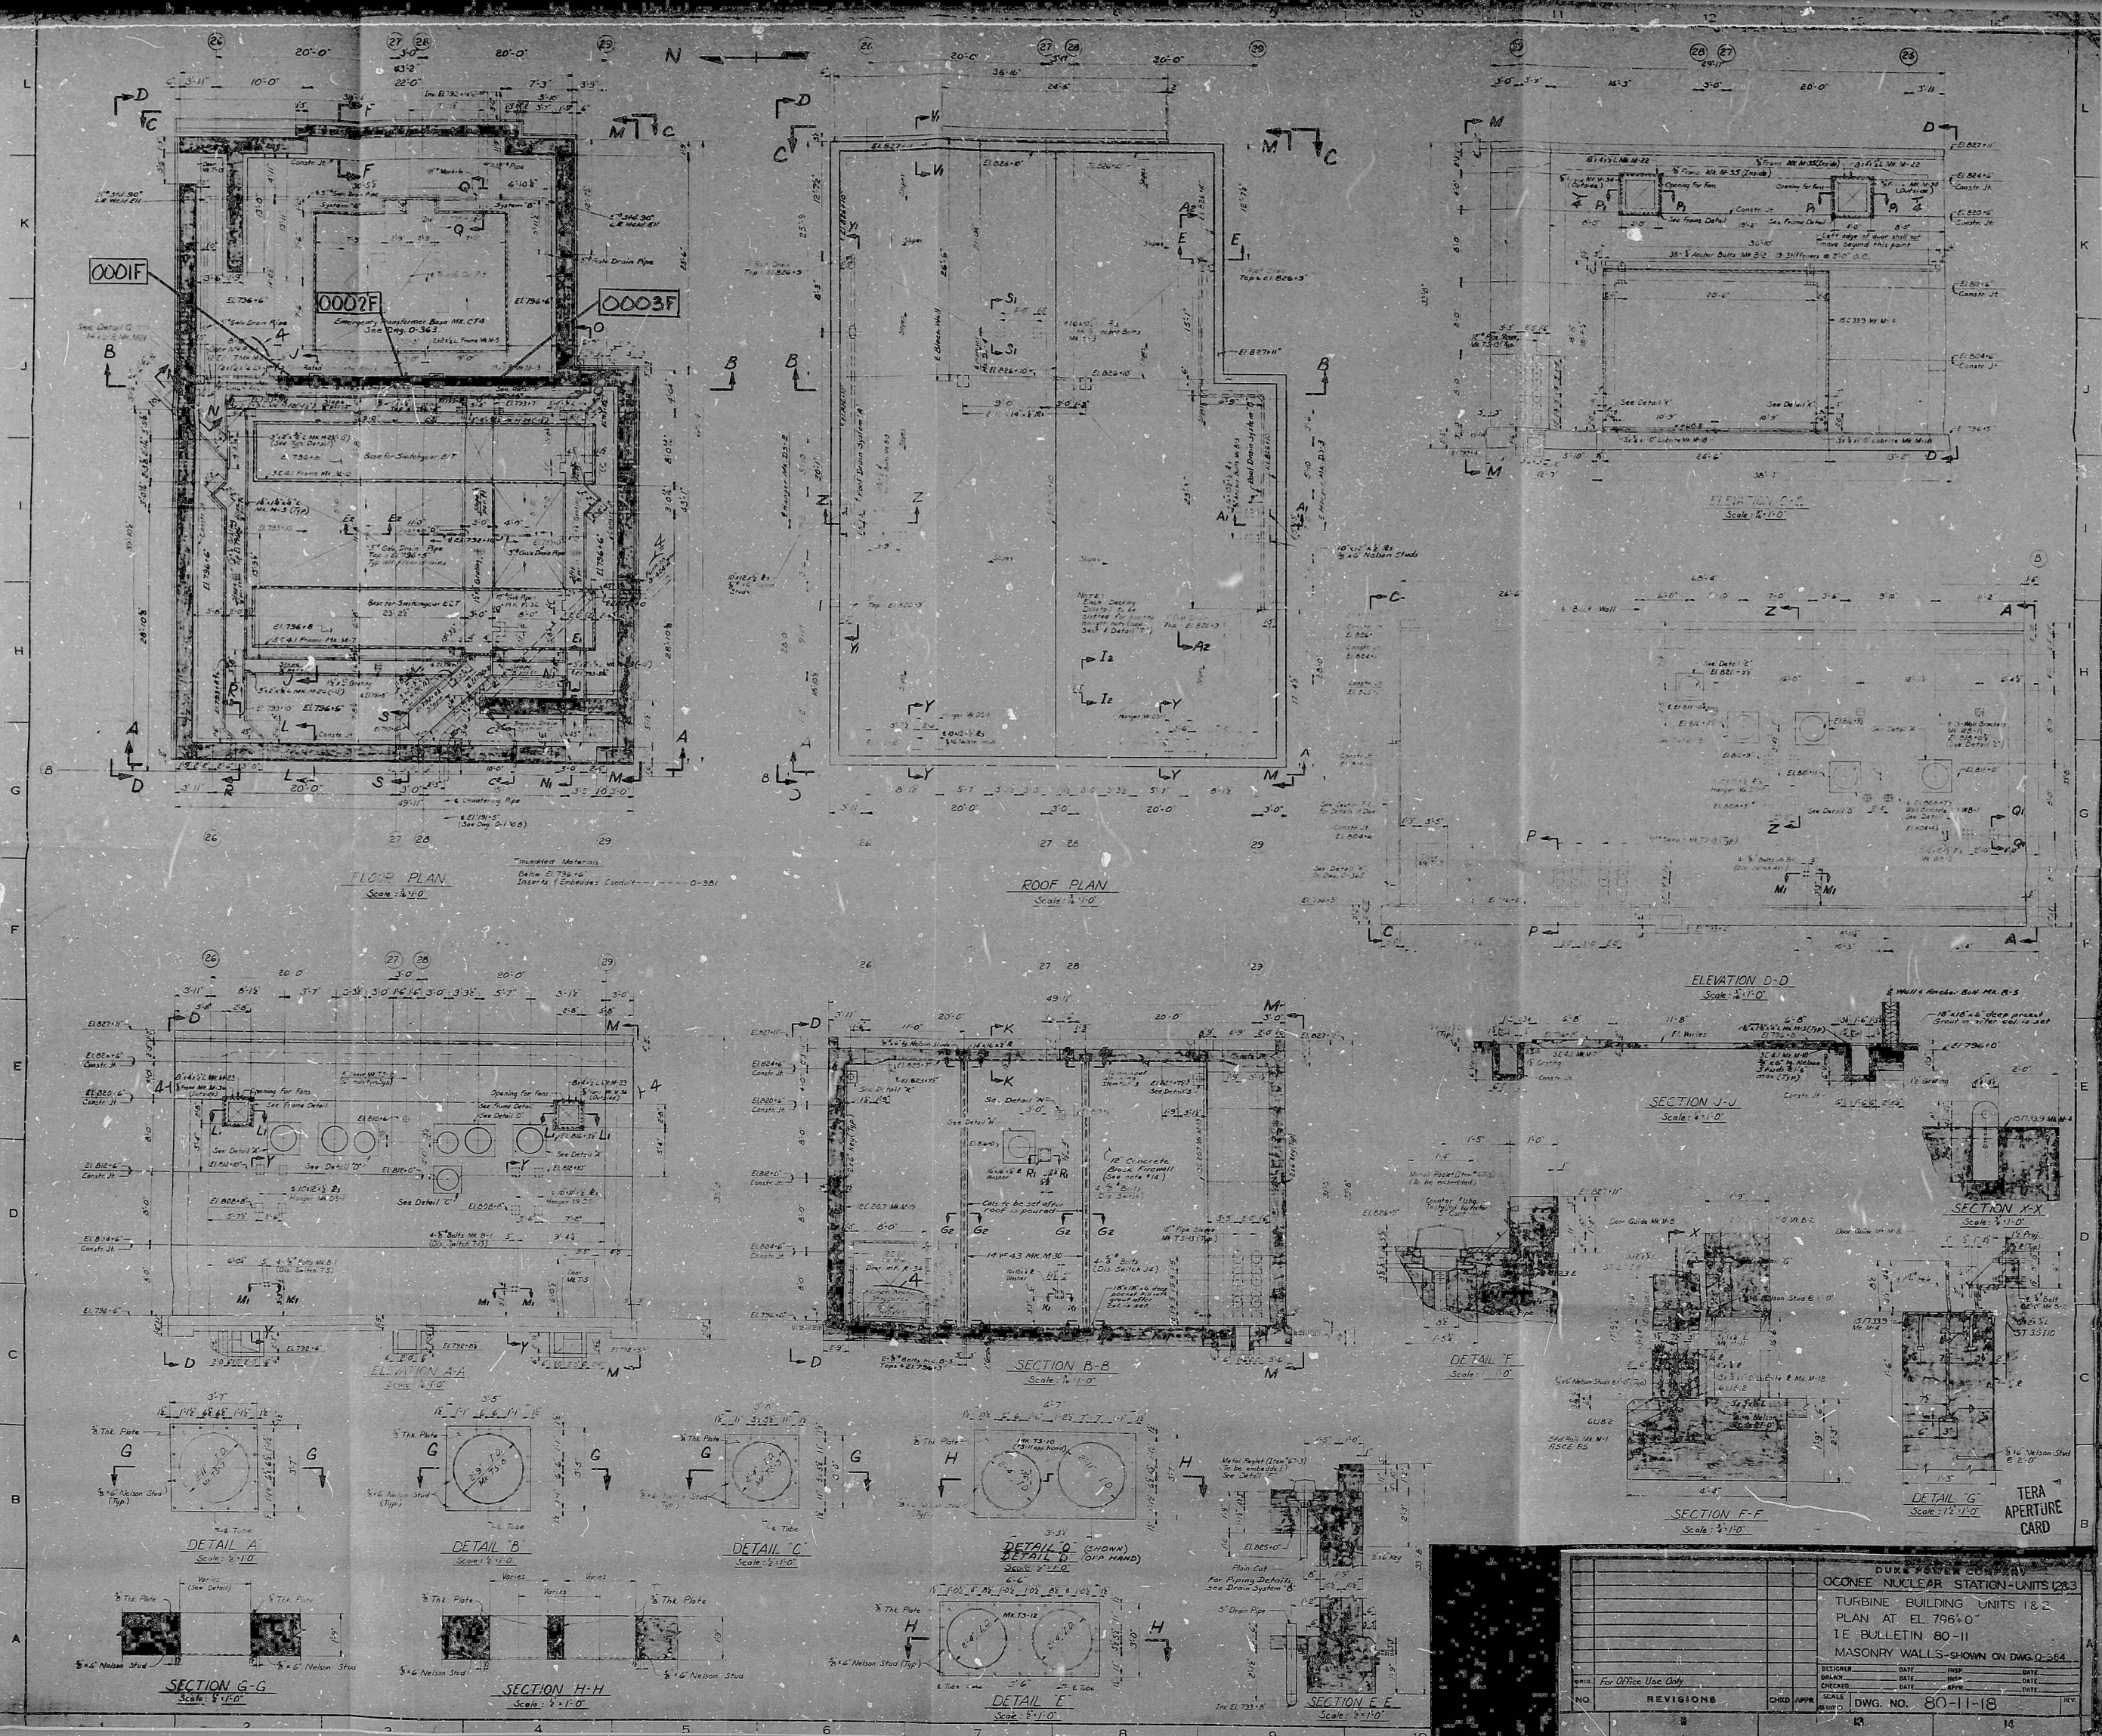

REVISIONS			
NO.	DESCRIPTION	DATE	BY
1	For Office Use Only		

 TURBINE BUILDING UNITS 1 & 2
 PLAN AT EL. 796.0'
 IE BULLETIN 80-11
 MASONRY WALLS SHOWN ON DWG. Q-264
 DWG. NO. 80-11-18

PIDS

807270369

